03-00-049-A
Scan # 45286

03-00-049-107-019, 018

MAP OF SUB-LOT NO. 292
HOY-LO-MAE ALL'T. THIRD ADD'N.

VOL. 15 PG. 7 PLATS
SHEFFIELD TWP. - LORAIN CITY
LORAIN COUNTY OHIO
SCALE: 1" = 30' MAY 3-1967 6:30 P.M.
Gary E. Penfound REG. SURVEYOR

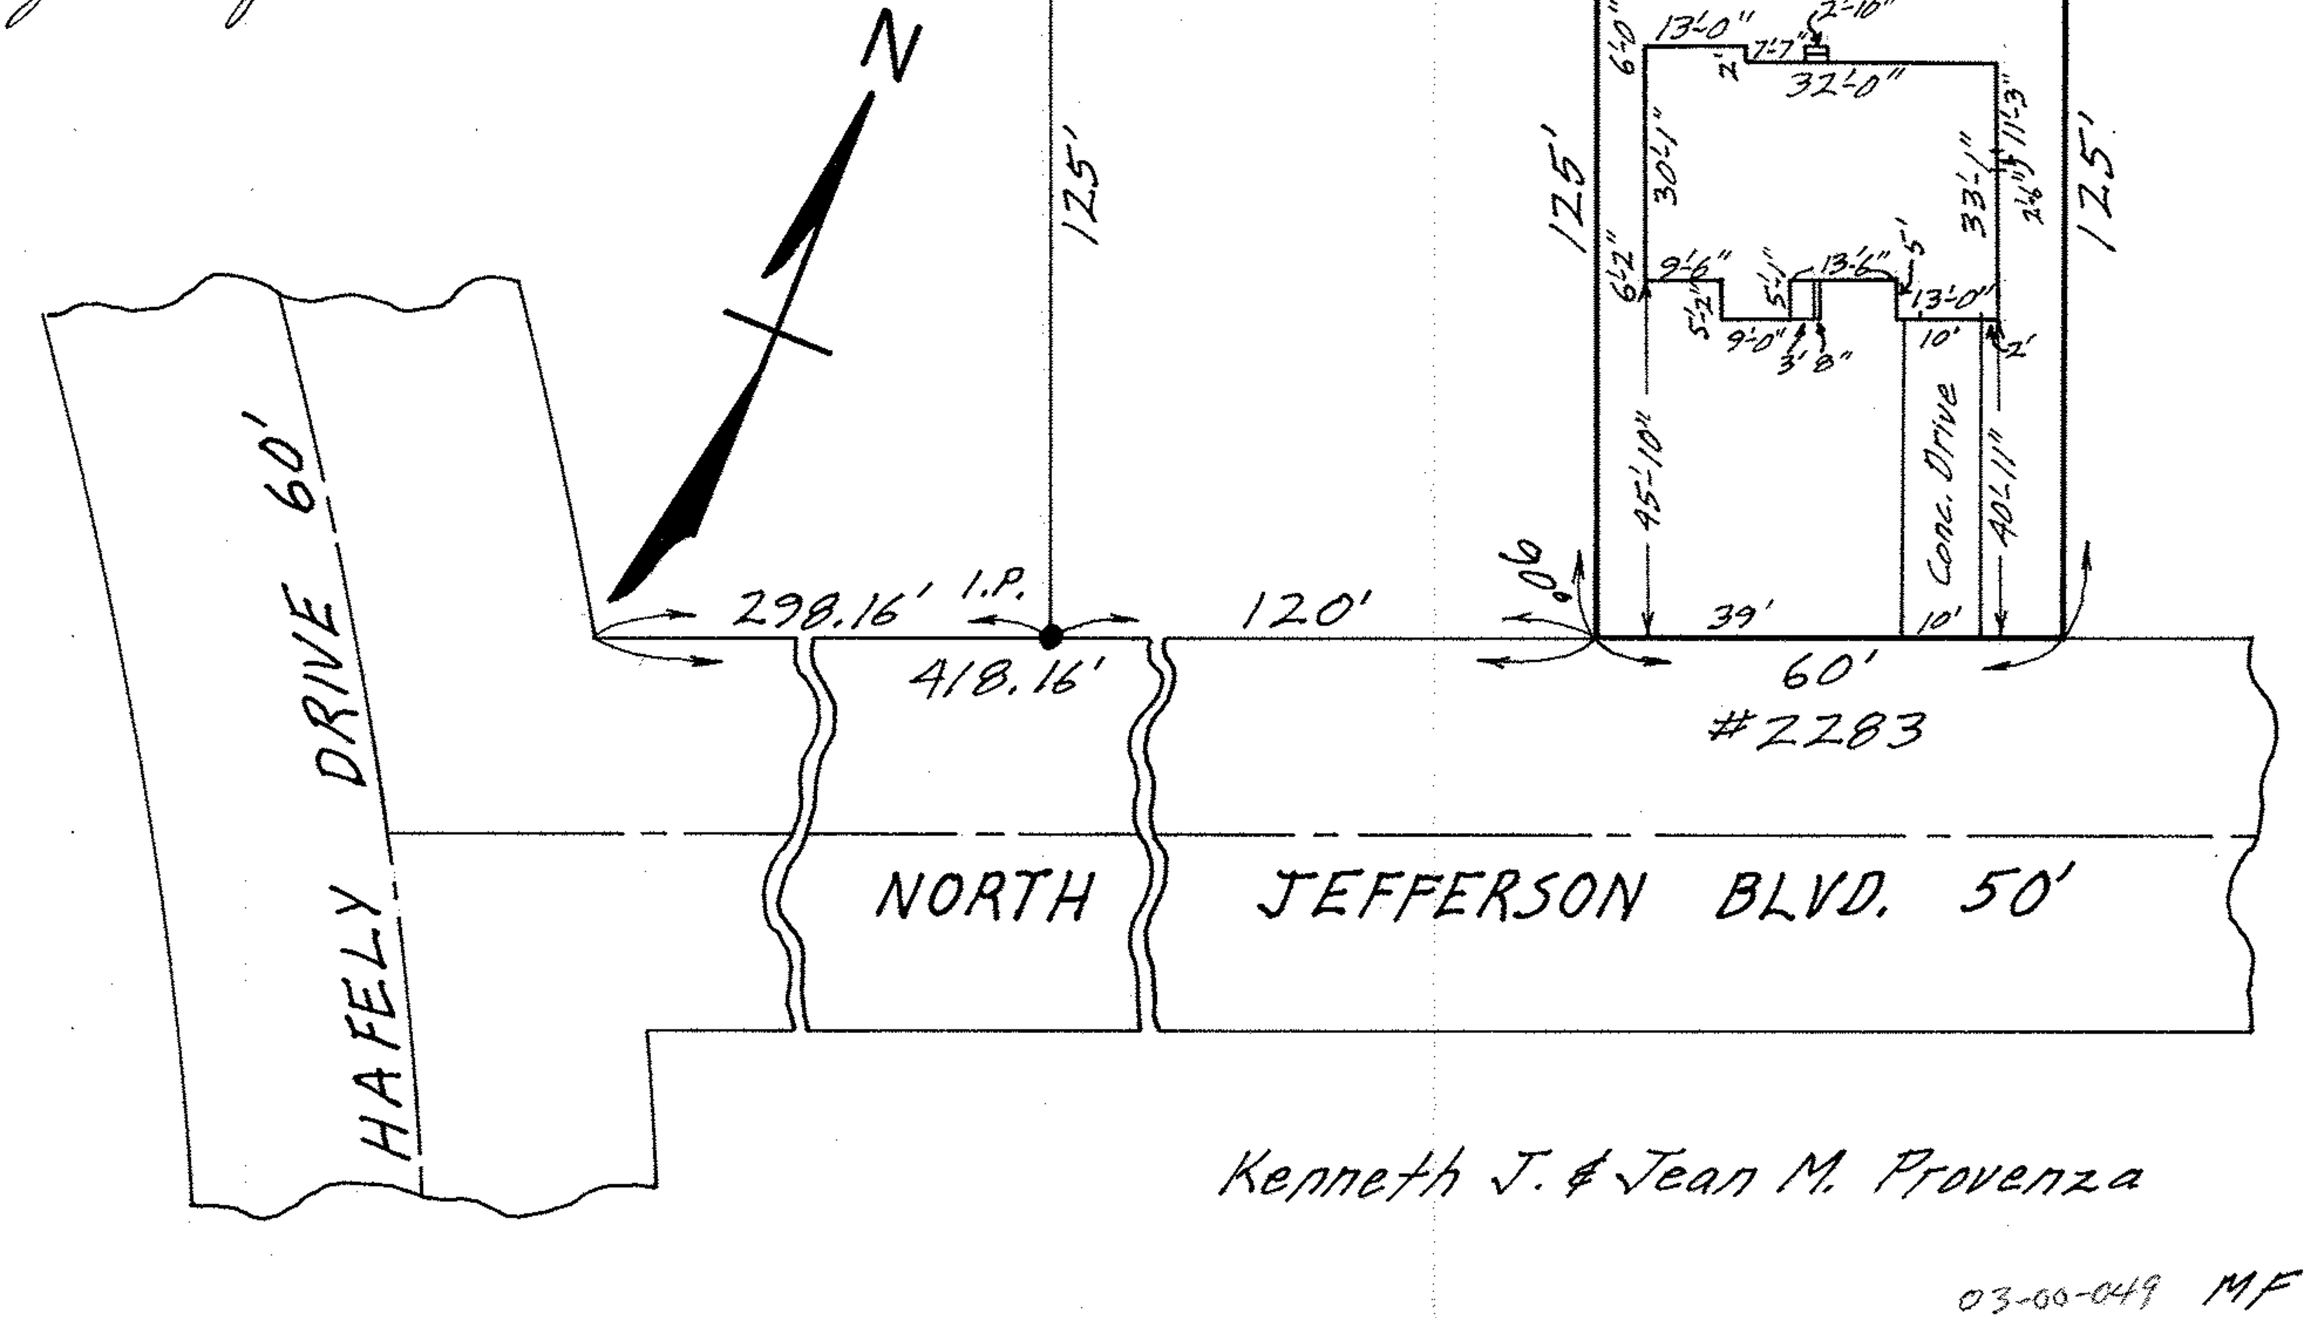

03-00-049 MF