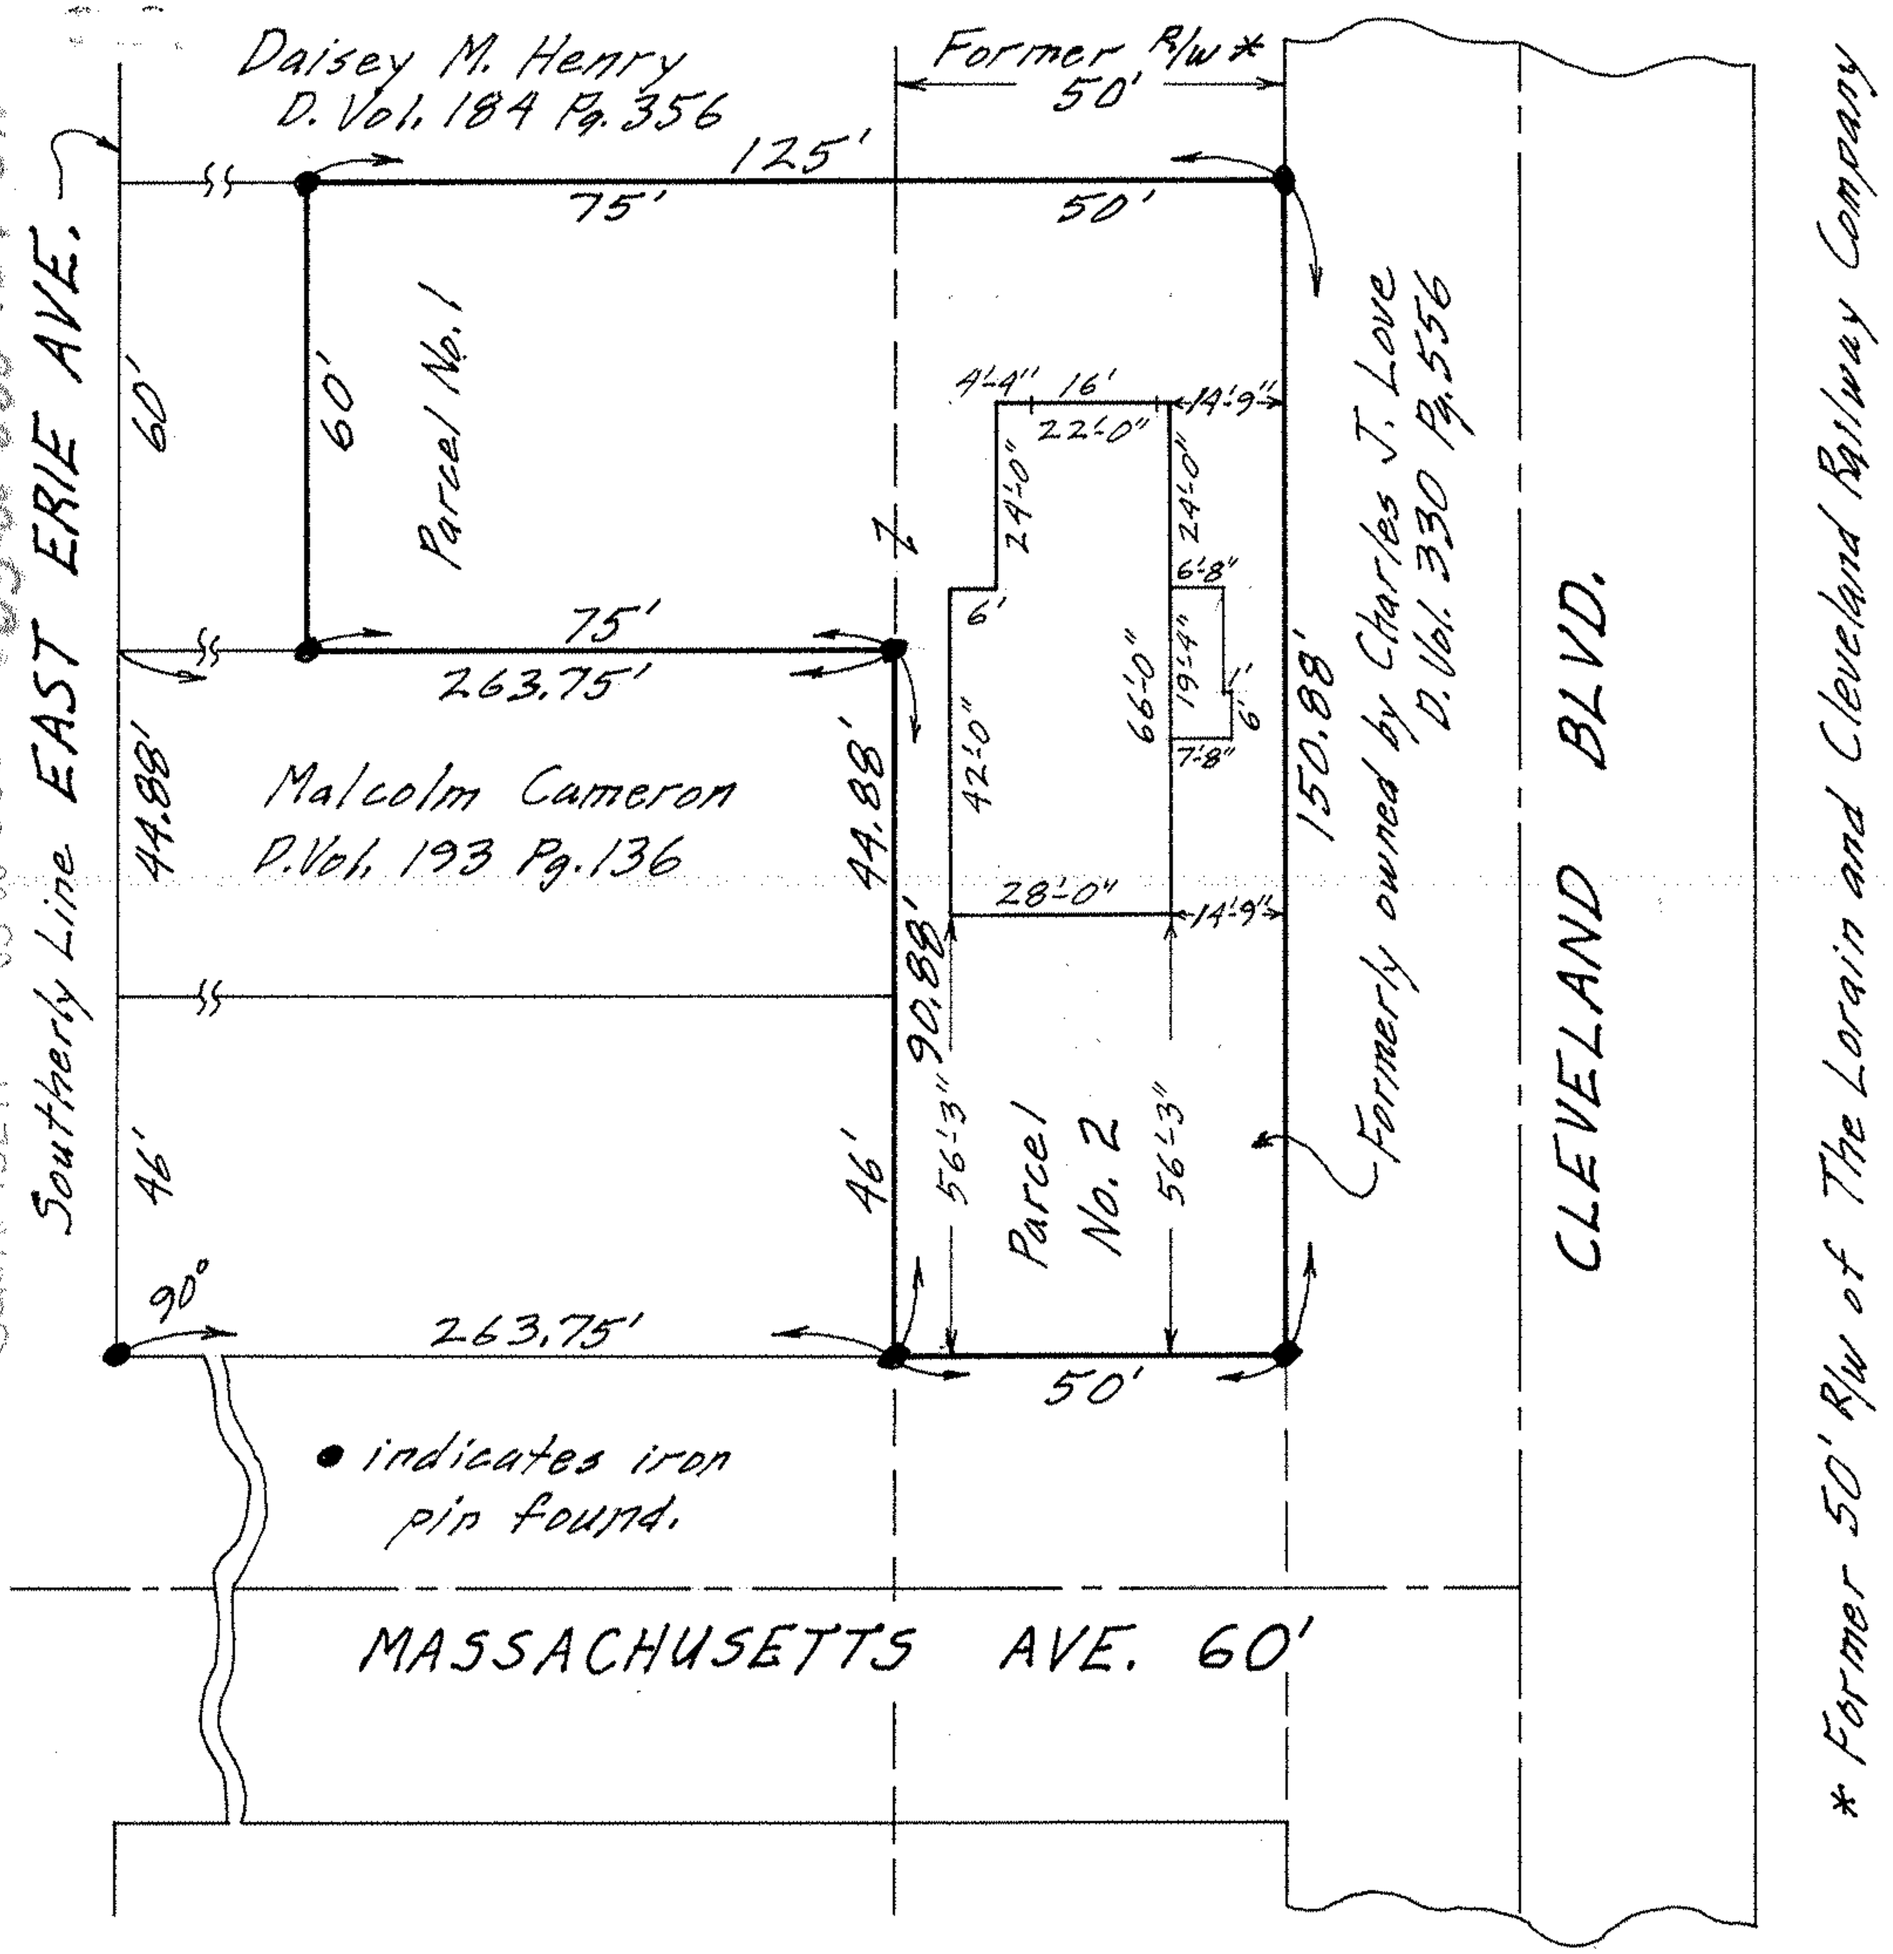

MAP OF PARTS OF ORIG. LOT NO. 50
SHEFFIELD TWP. LORAIN CITY
LORAIN COUNTY OHIO
SCALE: 1" = 30' SEPT. 29 - 1966 11:30 A.M.
Gary E. Penfound REG. SURVEYOR

Order No. 1469 James F. & JoLyn Kidd

03-00-050 MF

Scan # 45291 03-00-050 03-00-050-104-011