

03-00-055-105-001, 016
03-00-055-A
SCAN # 45296


LARKMOOR STREET 60'

S. 88°02'30"E.

NEBRASKA AVENUE 60'

N. 0°55'E.

#1301

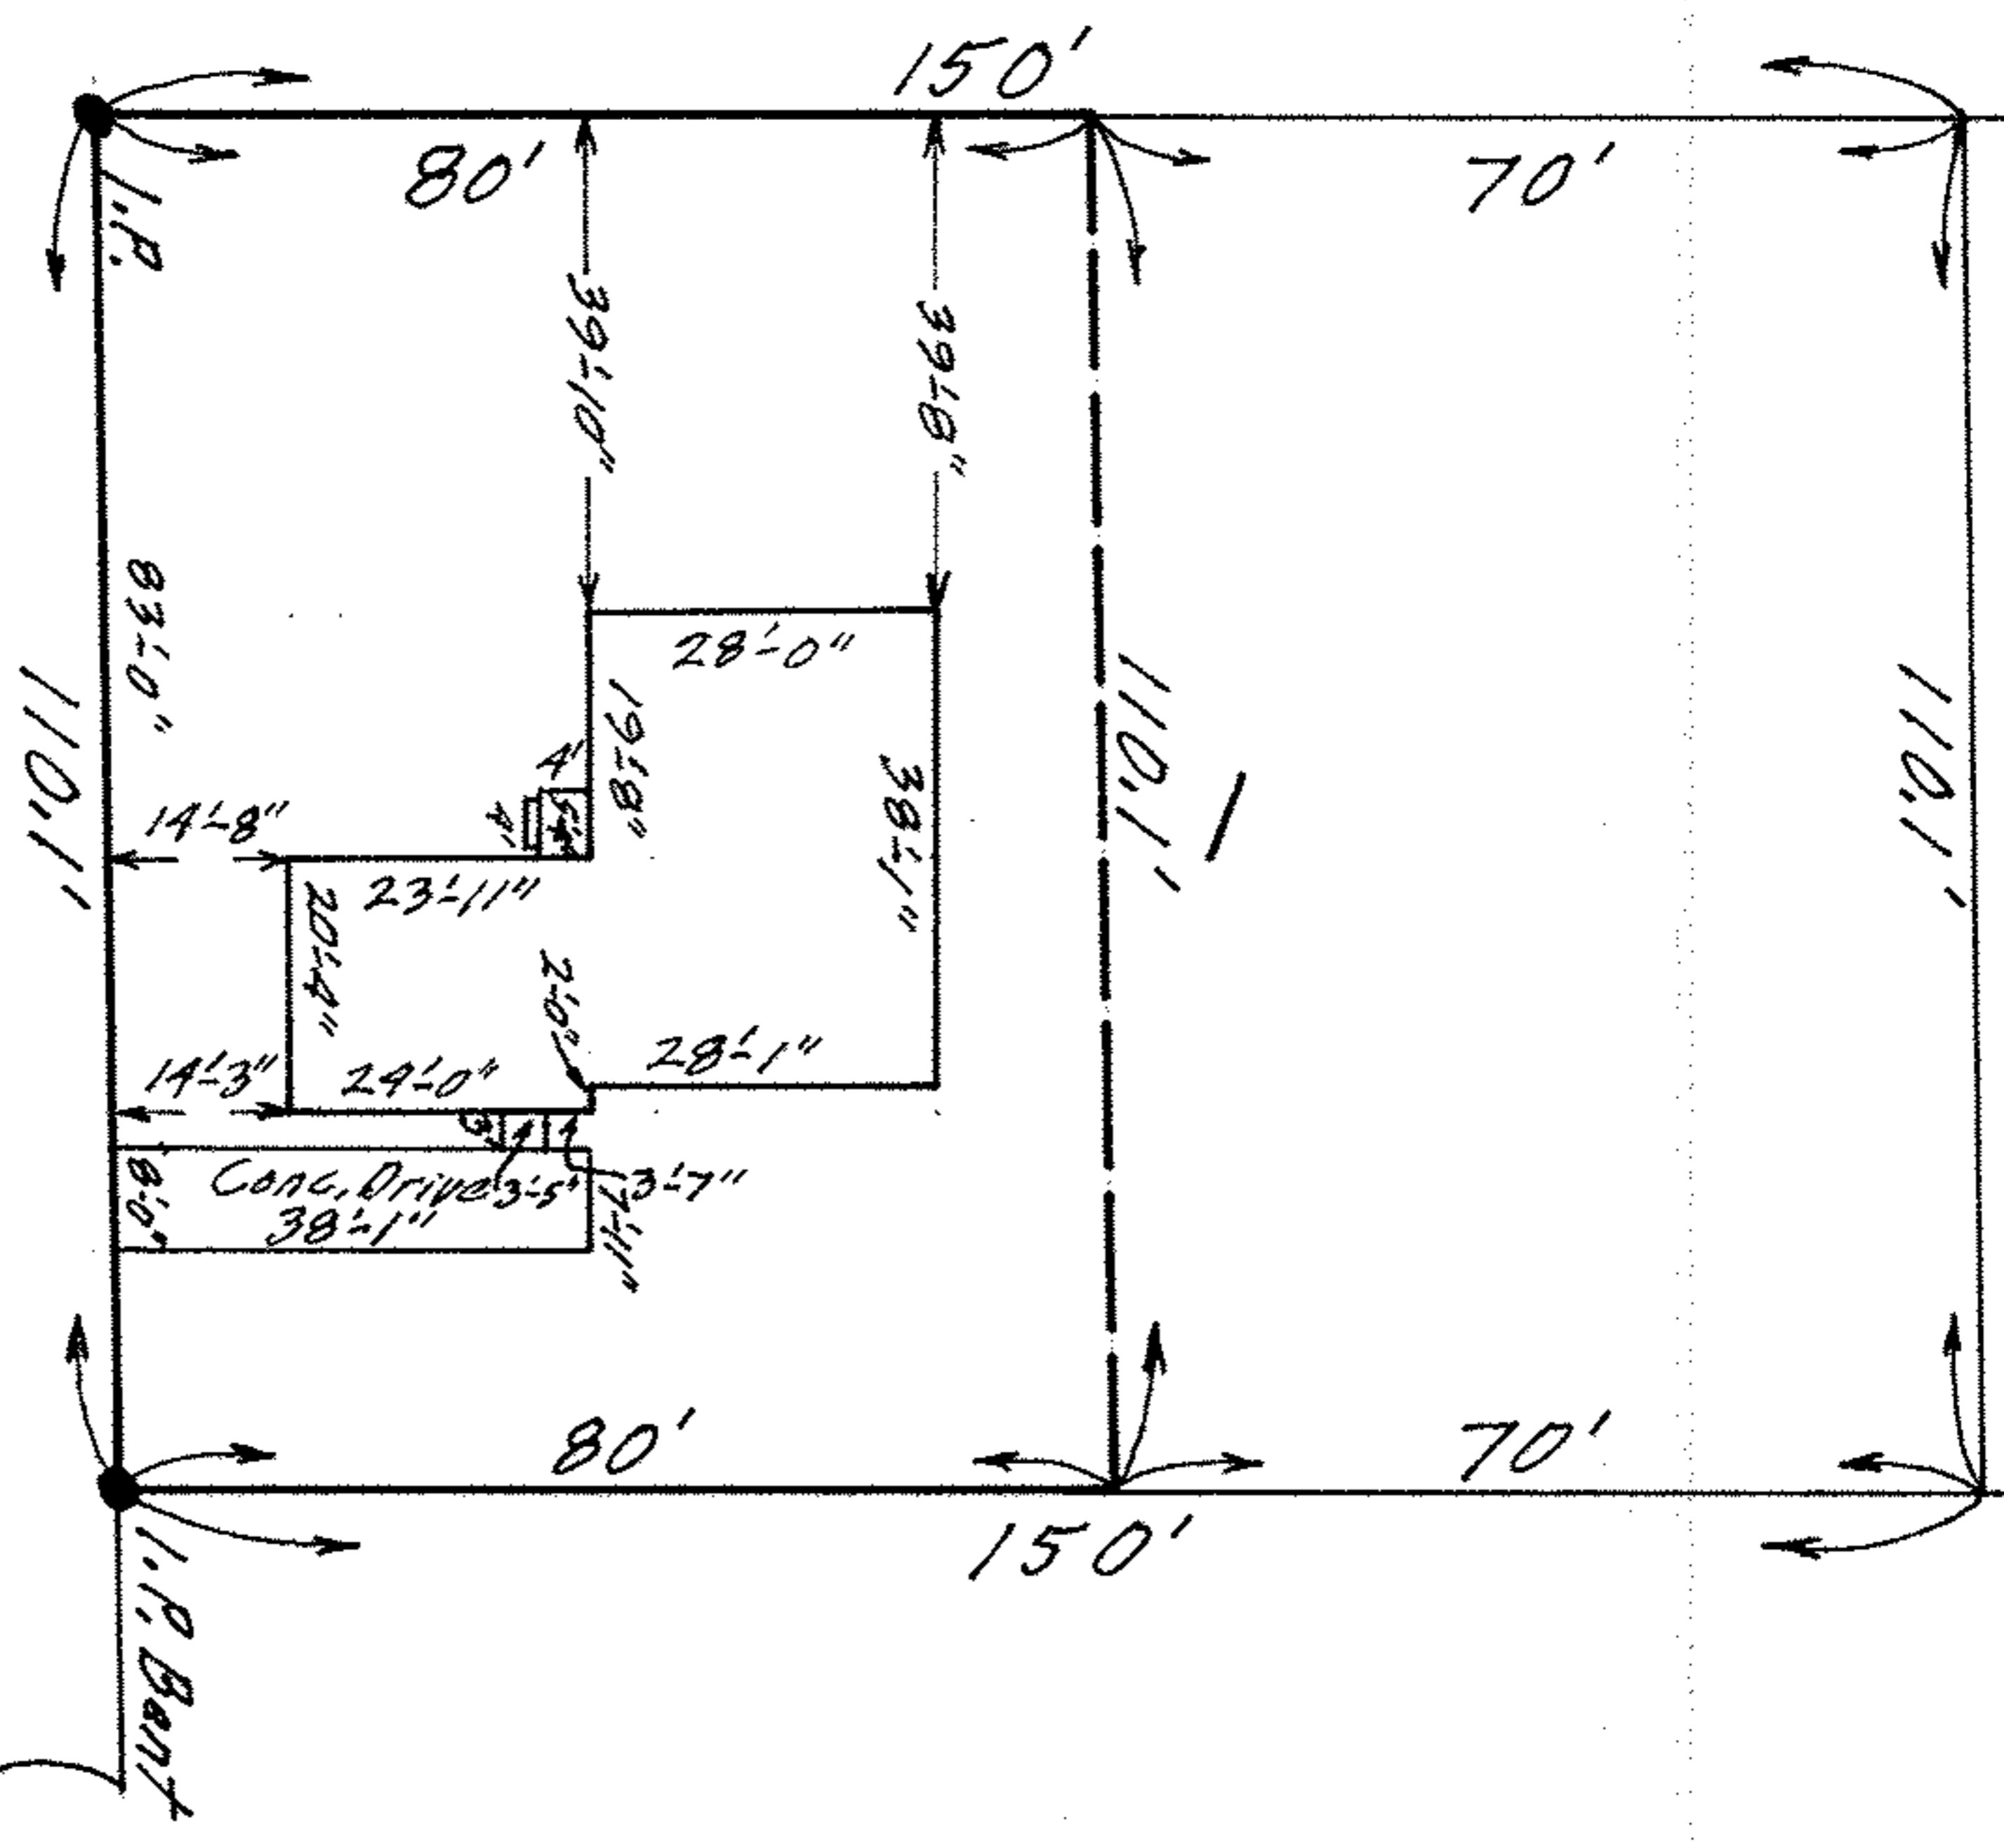

2

MAP OF THE WESTERLY 80 FEET OF SUB-LOT NO. 1
 LARKWOOD SUB'N. NO. 1 Vol. 18 Pg. 36-A PLATS
 ORIG. LOT 55 SHEFFIELD TOWNSHIP
 LORAIN CITY LORAIN COUNTY OHIO

SCALE: 1" = 30' MAY 31-1969 3:00 P.M.

Gary E. Penfound REG. SURVEYOR

P.O. Robert & Ellen Bartick