03-00-057-A
03-00-057-A
Scan #45305

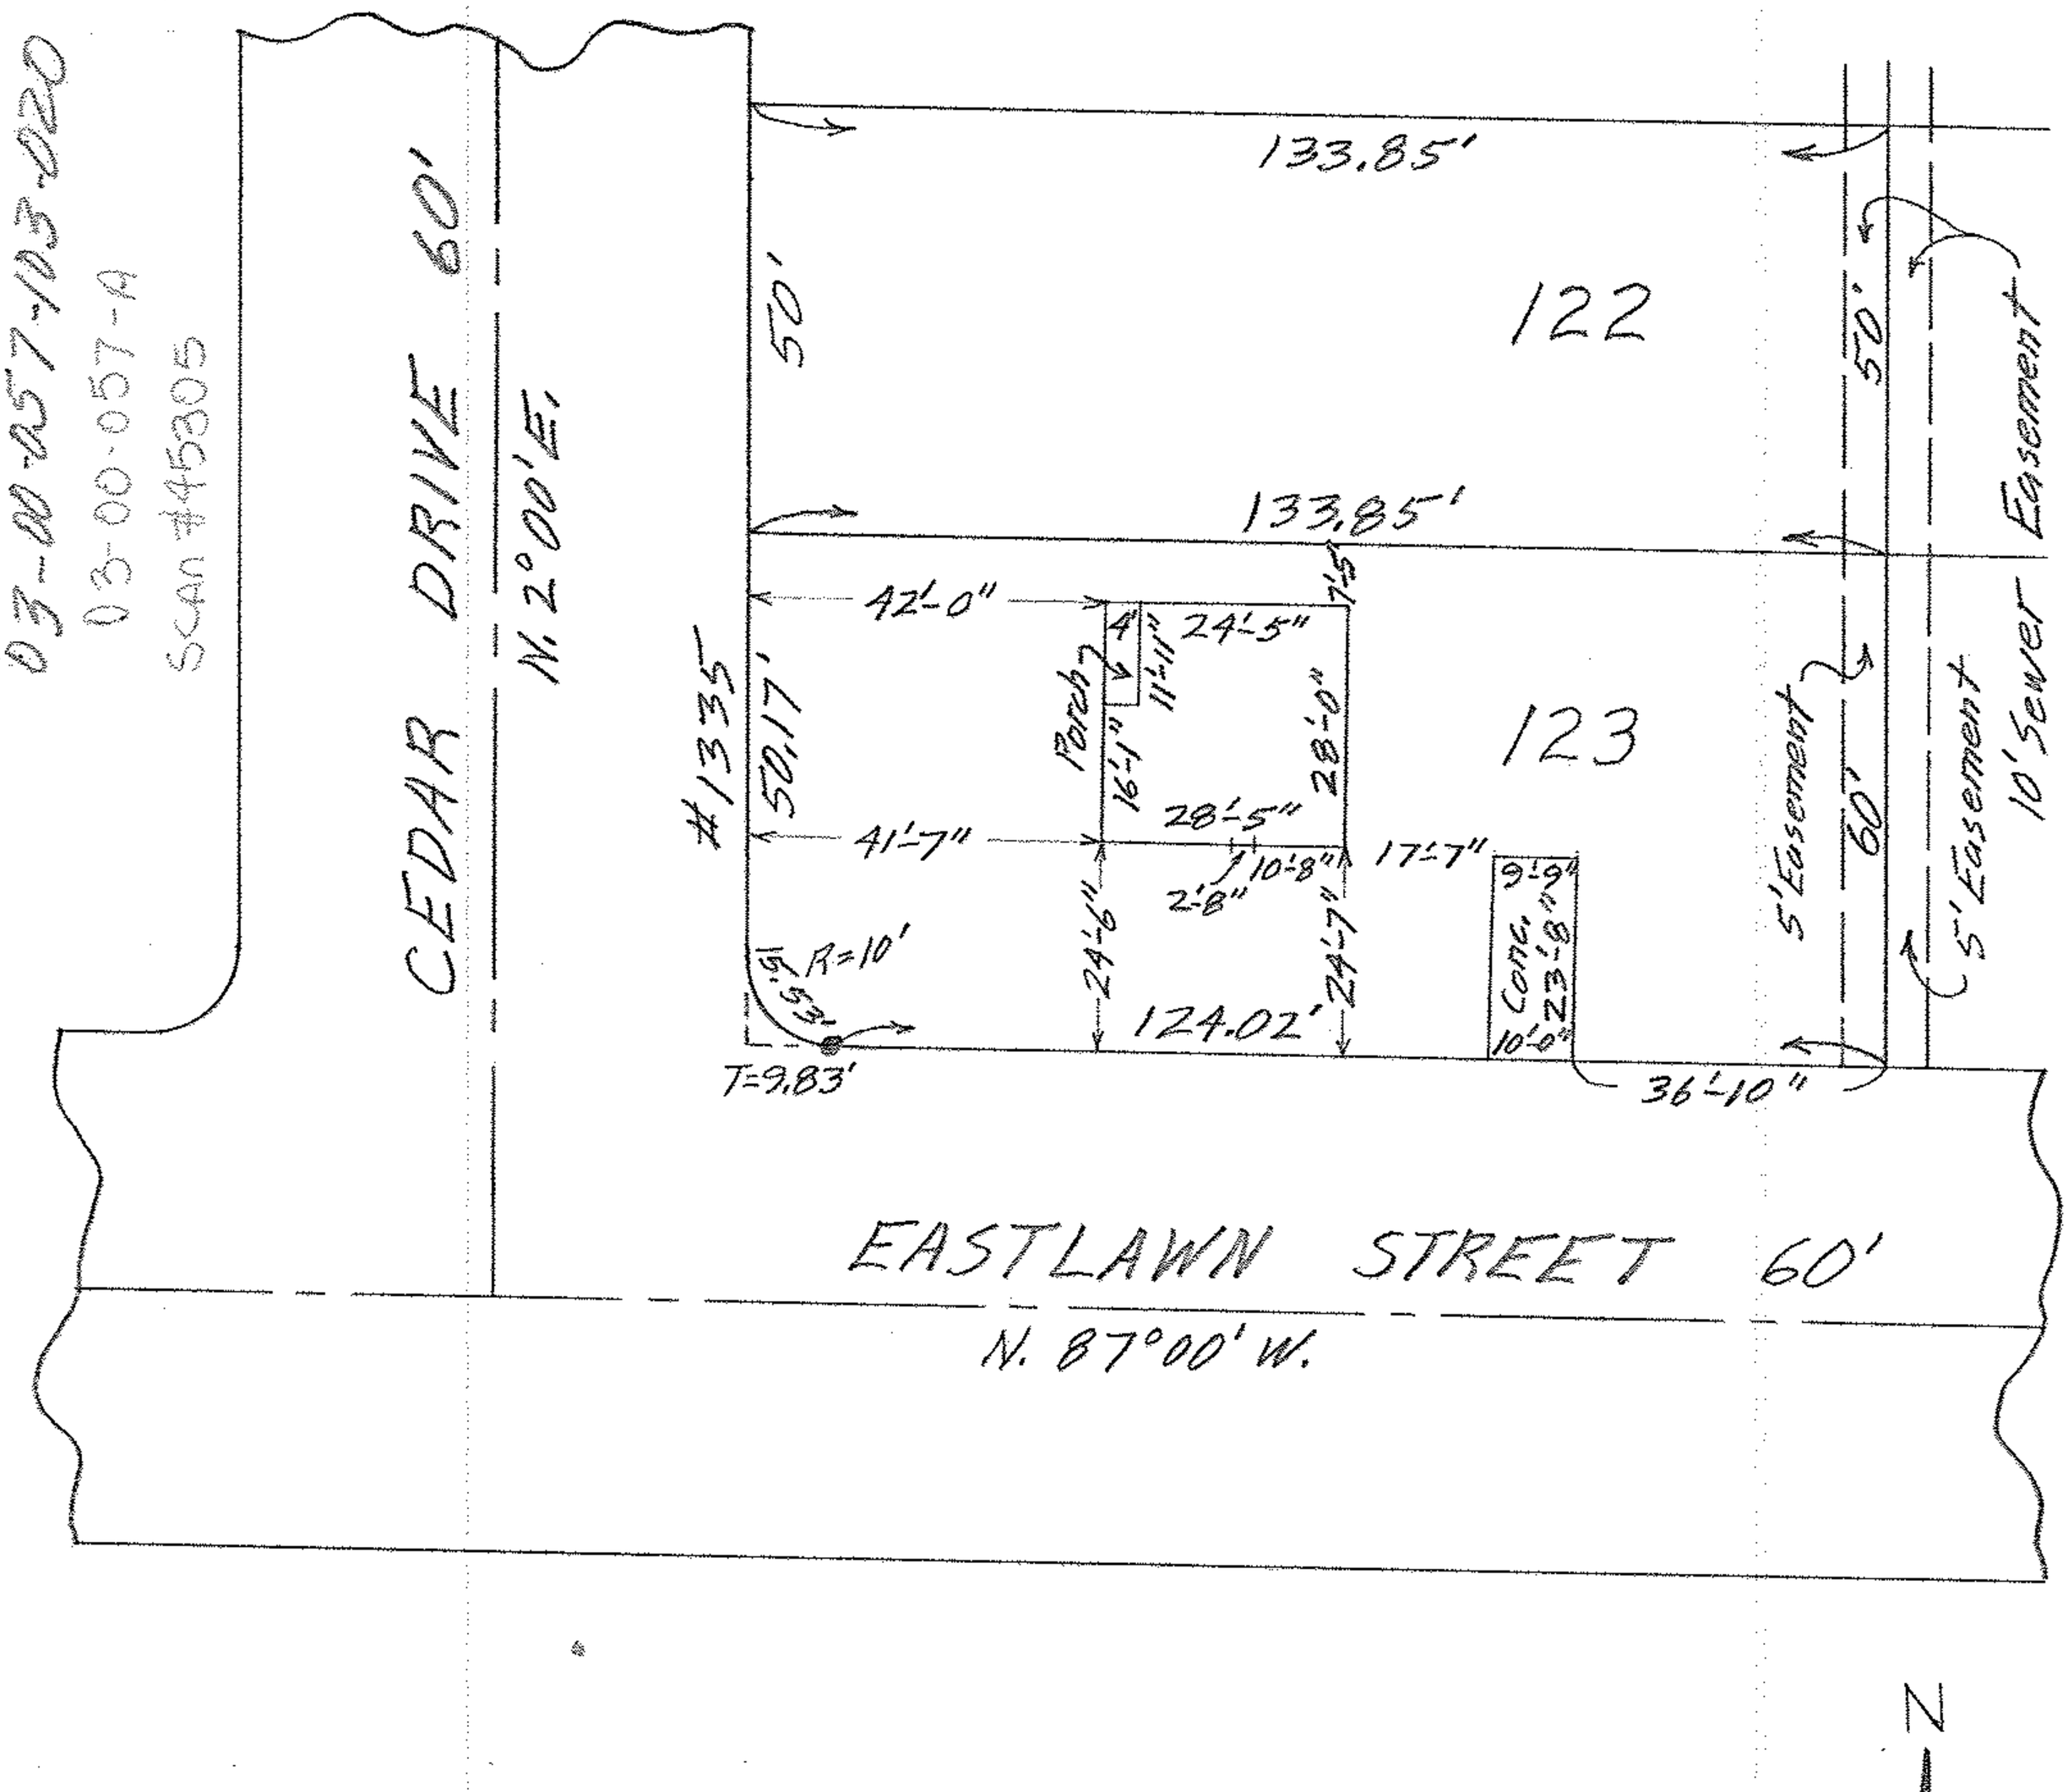

MAP OF SUB-LOT NO. 123
MAPLE HEIGHTS SUB'N. NO. 3 VOL. 15 PG. 35
ORIG. LOT 57 SHEFFIELD TWP. - LORAIN CITY
LORAIN COUNTY OHIO
SCALE: 1"=30' JUNE 3-1963 1:30 P.M.
Gary E. Penfound REG. SURVEYOR

Francisco & Joyce Corcino WW

03-00-057