


N

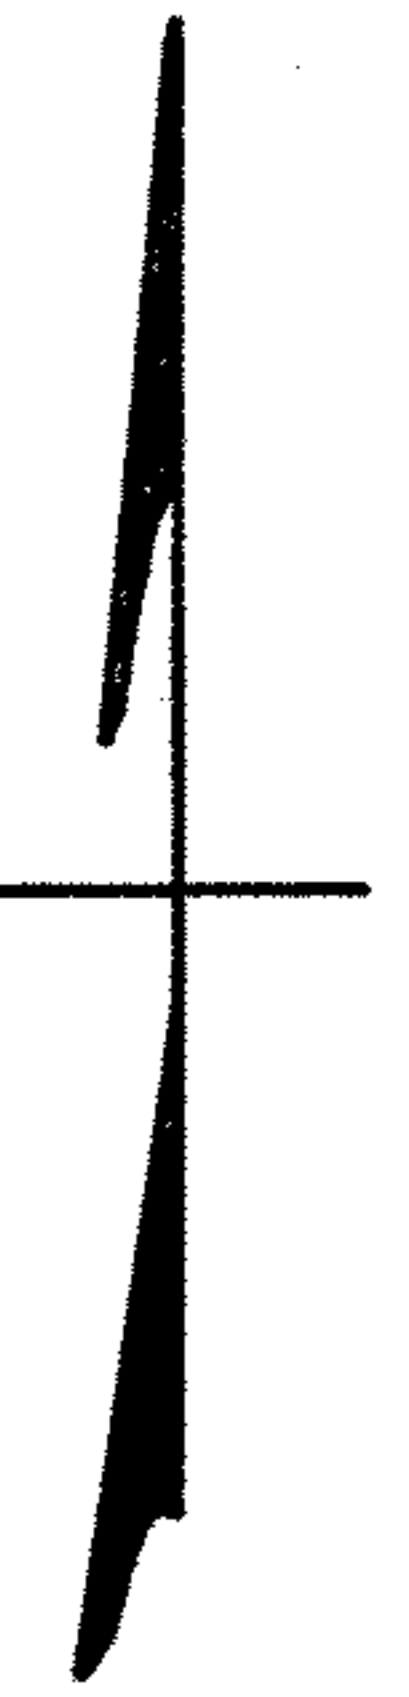

03-00-074-110-054-9006, 029

MAP OF SUB-LOTS NOS. 200-201-202-203 & 204
THE LIBERTY SUBV. VOL. 9 PG. 26 03-00-075-A
ORIG. LOT 76 SHEFFIELD TWP. LORAIN COUNTY OHIO


SCAN# 45312

SCALE: 1"=30' MAY 6-1970 5:45 P.M.

16' ALLEY

MAYFIELD STREET 50'

LIBERTY AVENUE 60'

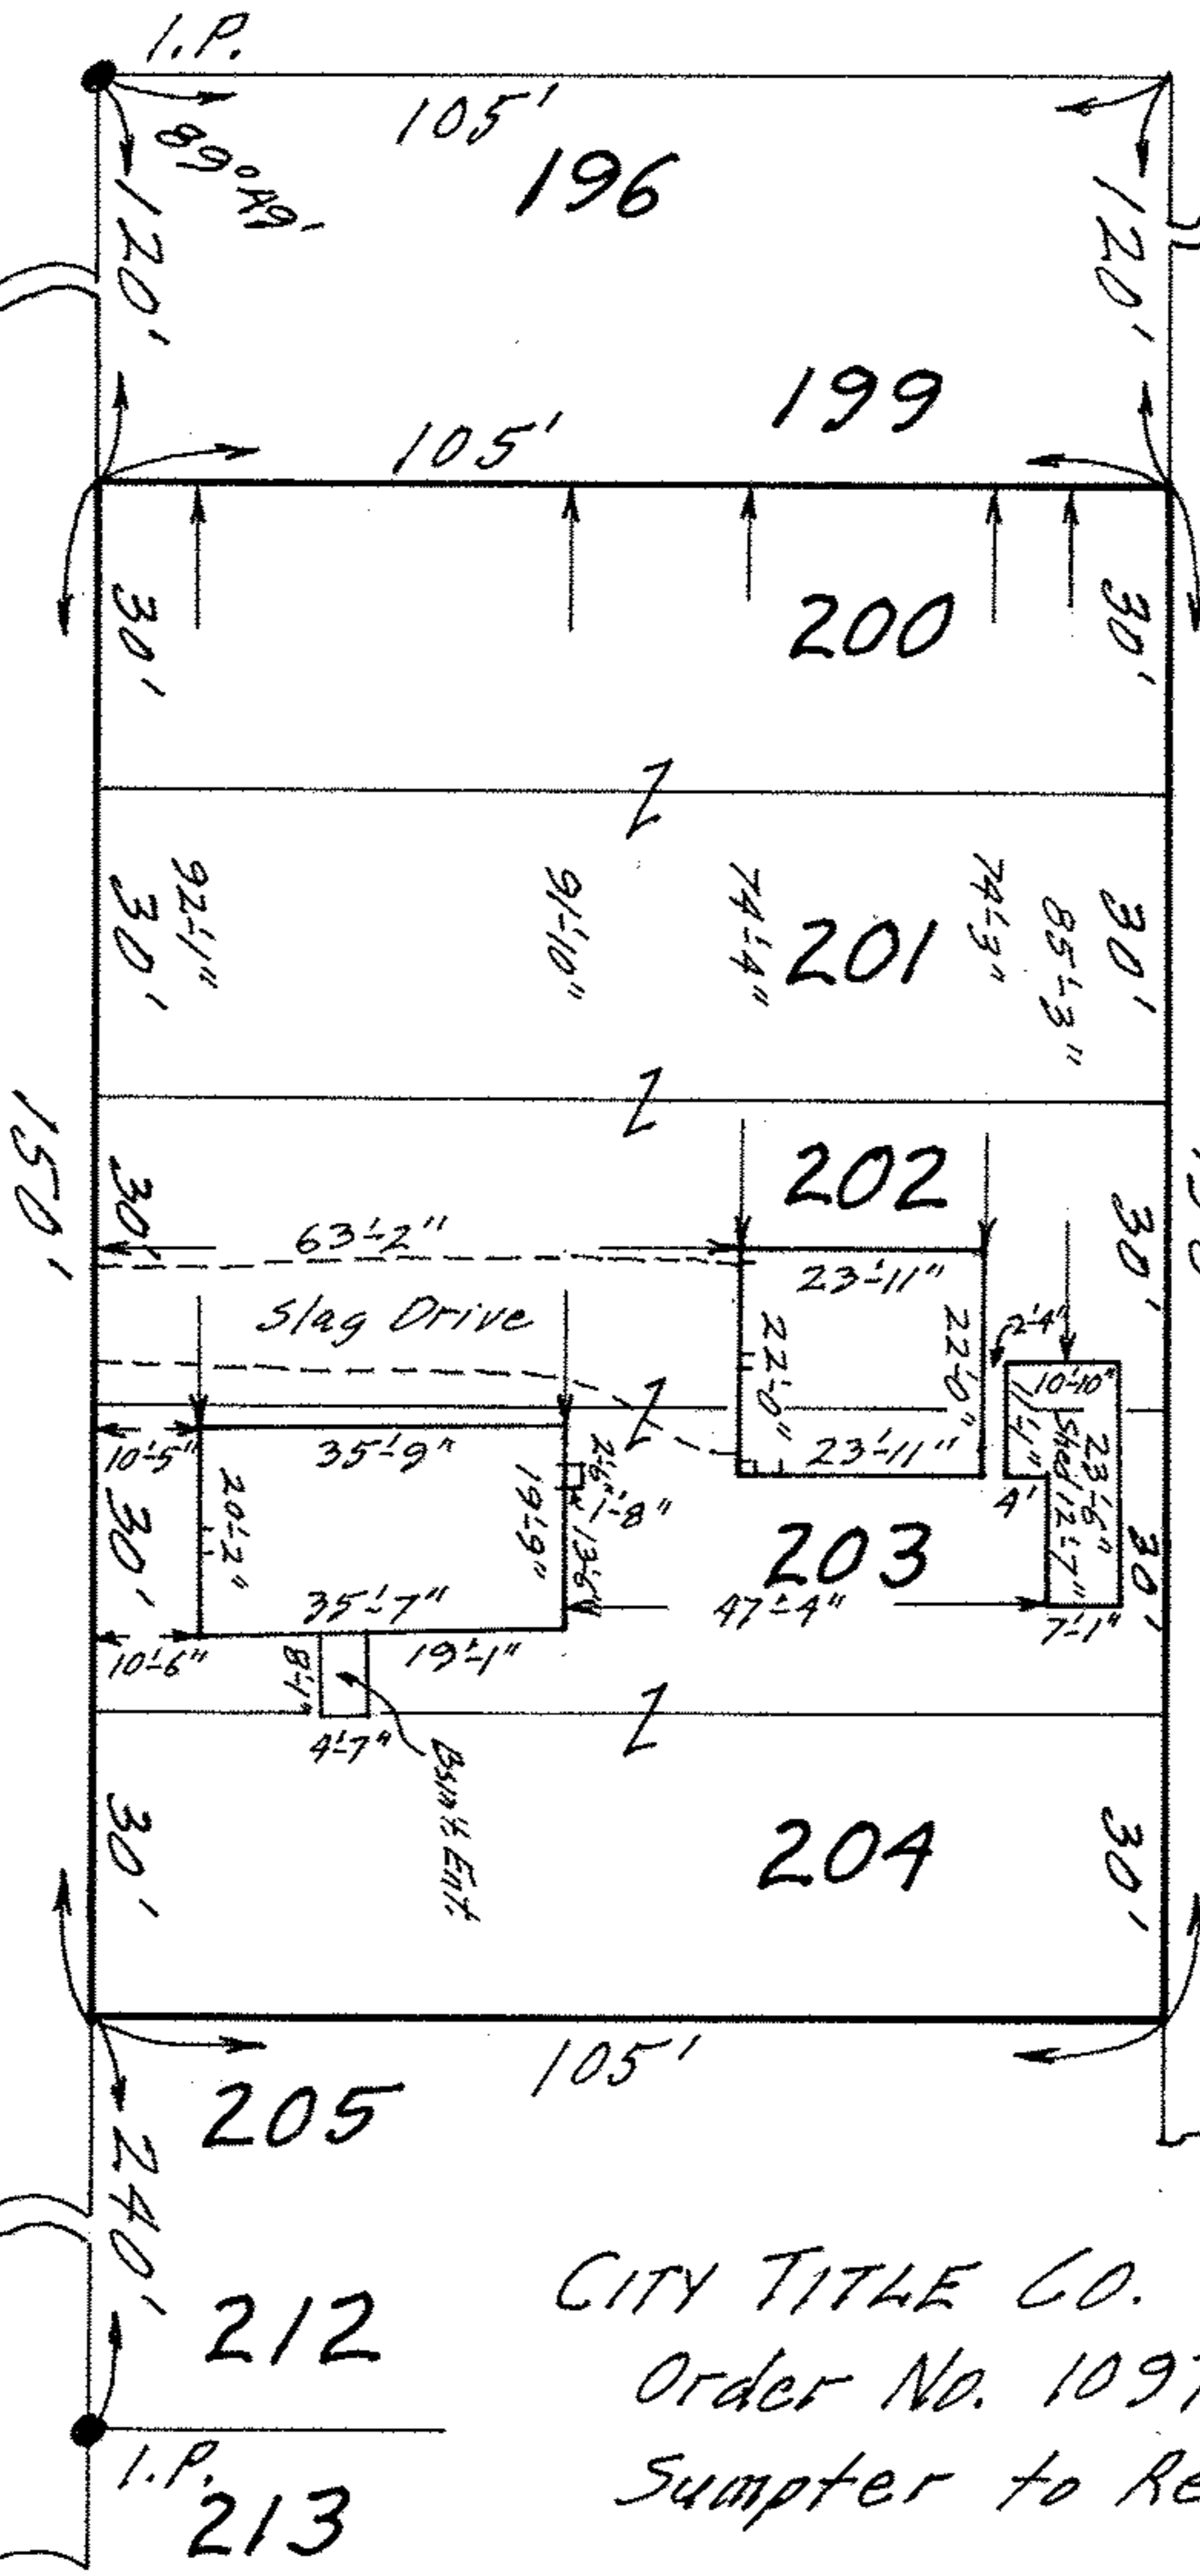

CITY TITLE CO.
Order No. 1097-8
Sumpter to Reising

NOTE: There are no encroachments on this property.

Survey E. performed REG. SURVEYOR NO. 4457

03-00-076