Scan # 45313 03-00-076-114-003.009
03-00-075.C

MAP OF PARTS OF ORIGINAL LOT NO. 76
SHEFFIELD TWP. - LORAIN COUNTY - OHIO

SCALE: 1" = 30' JUNE 4-1967 2:40 P.M.

Gary E. Penfound REG. SURVEYOR

BERKS TITLE INS. CO. Order No. 1833

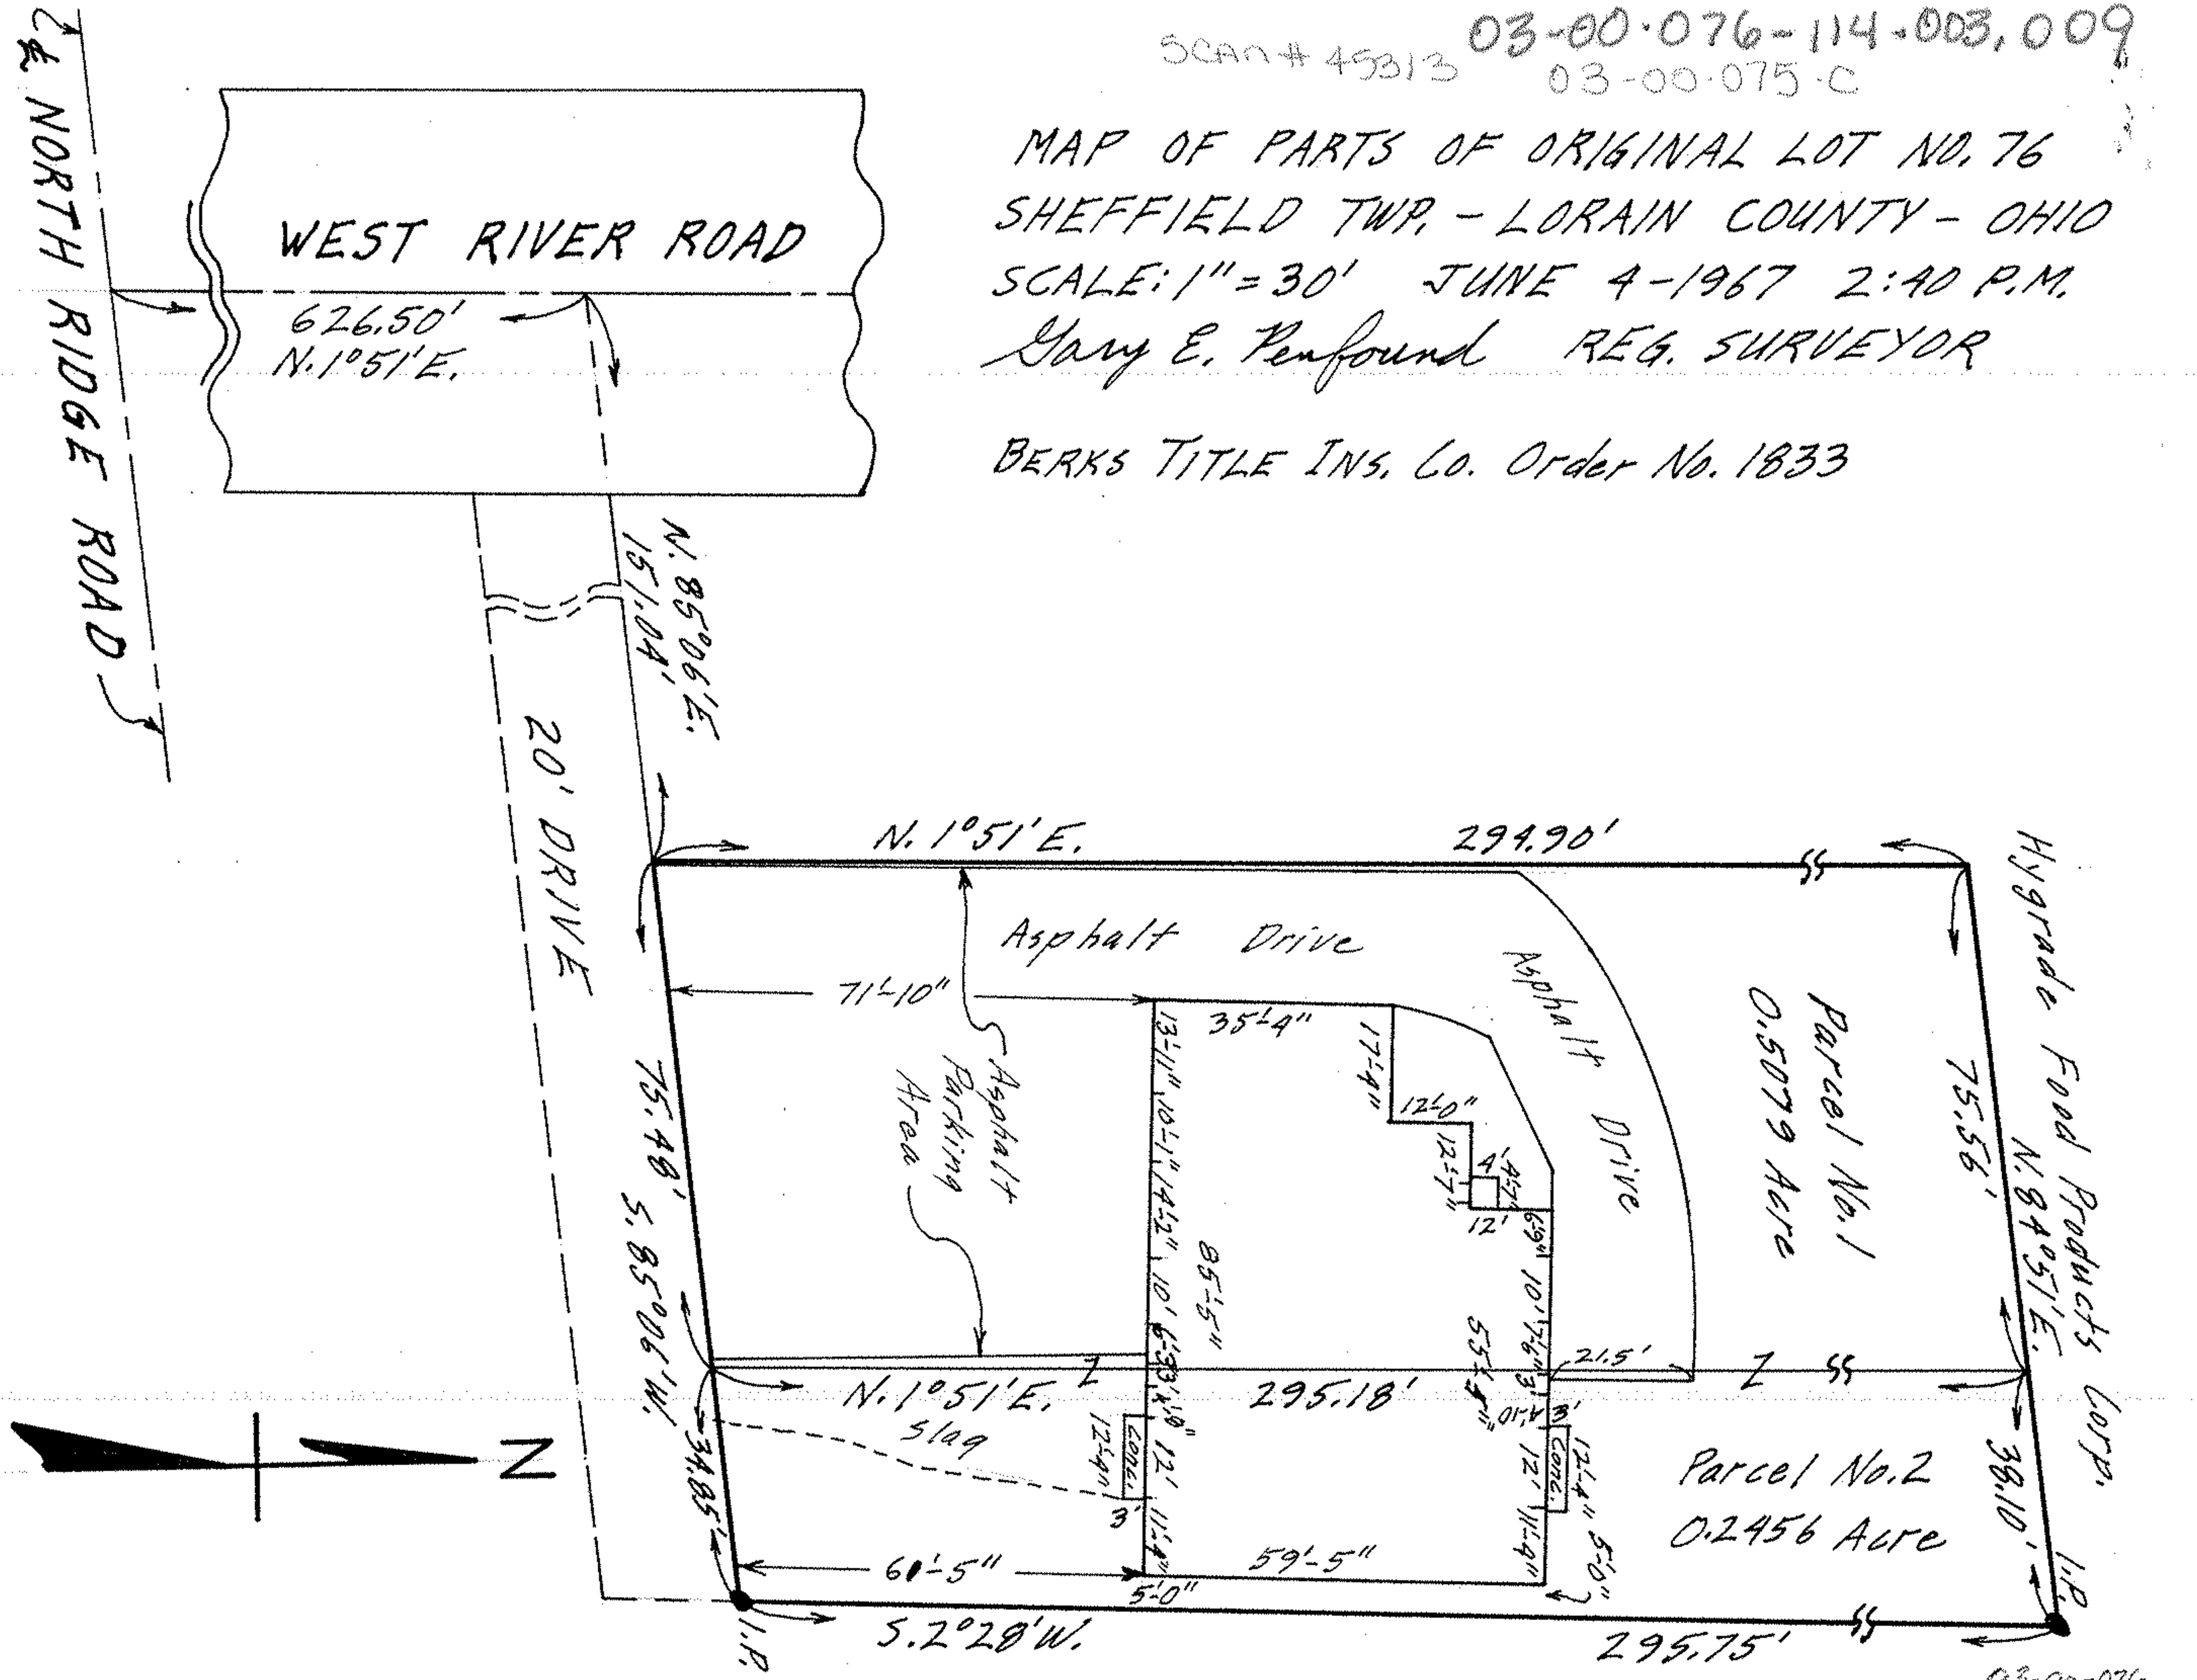

03-00-076