03-00-078-113-005

Scan # 45918

03-00-077-A

CITY TITLE Co. Order No. E-810-11

Paul & Linda K. Salvador to

Harvey Joe & Constance Bodkins

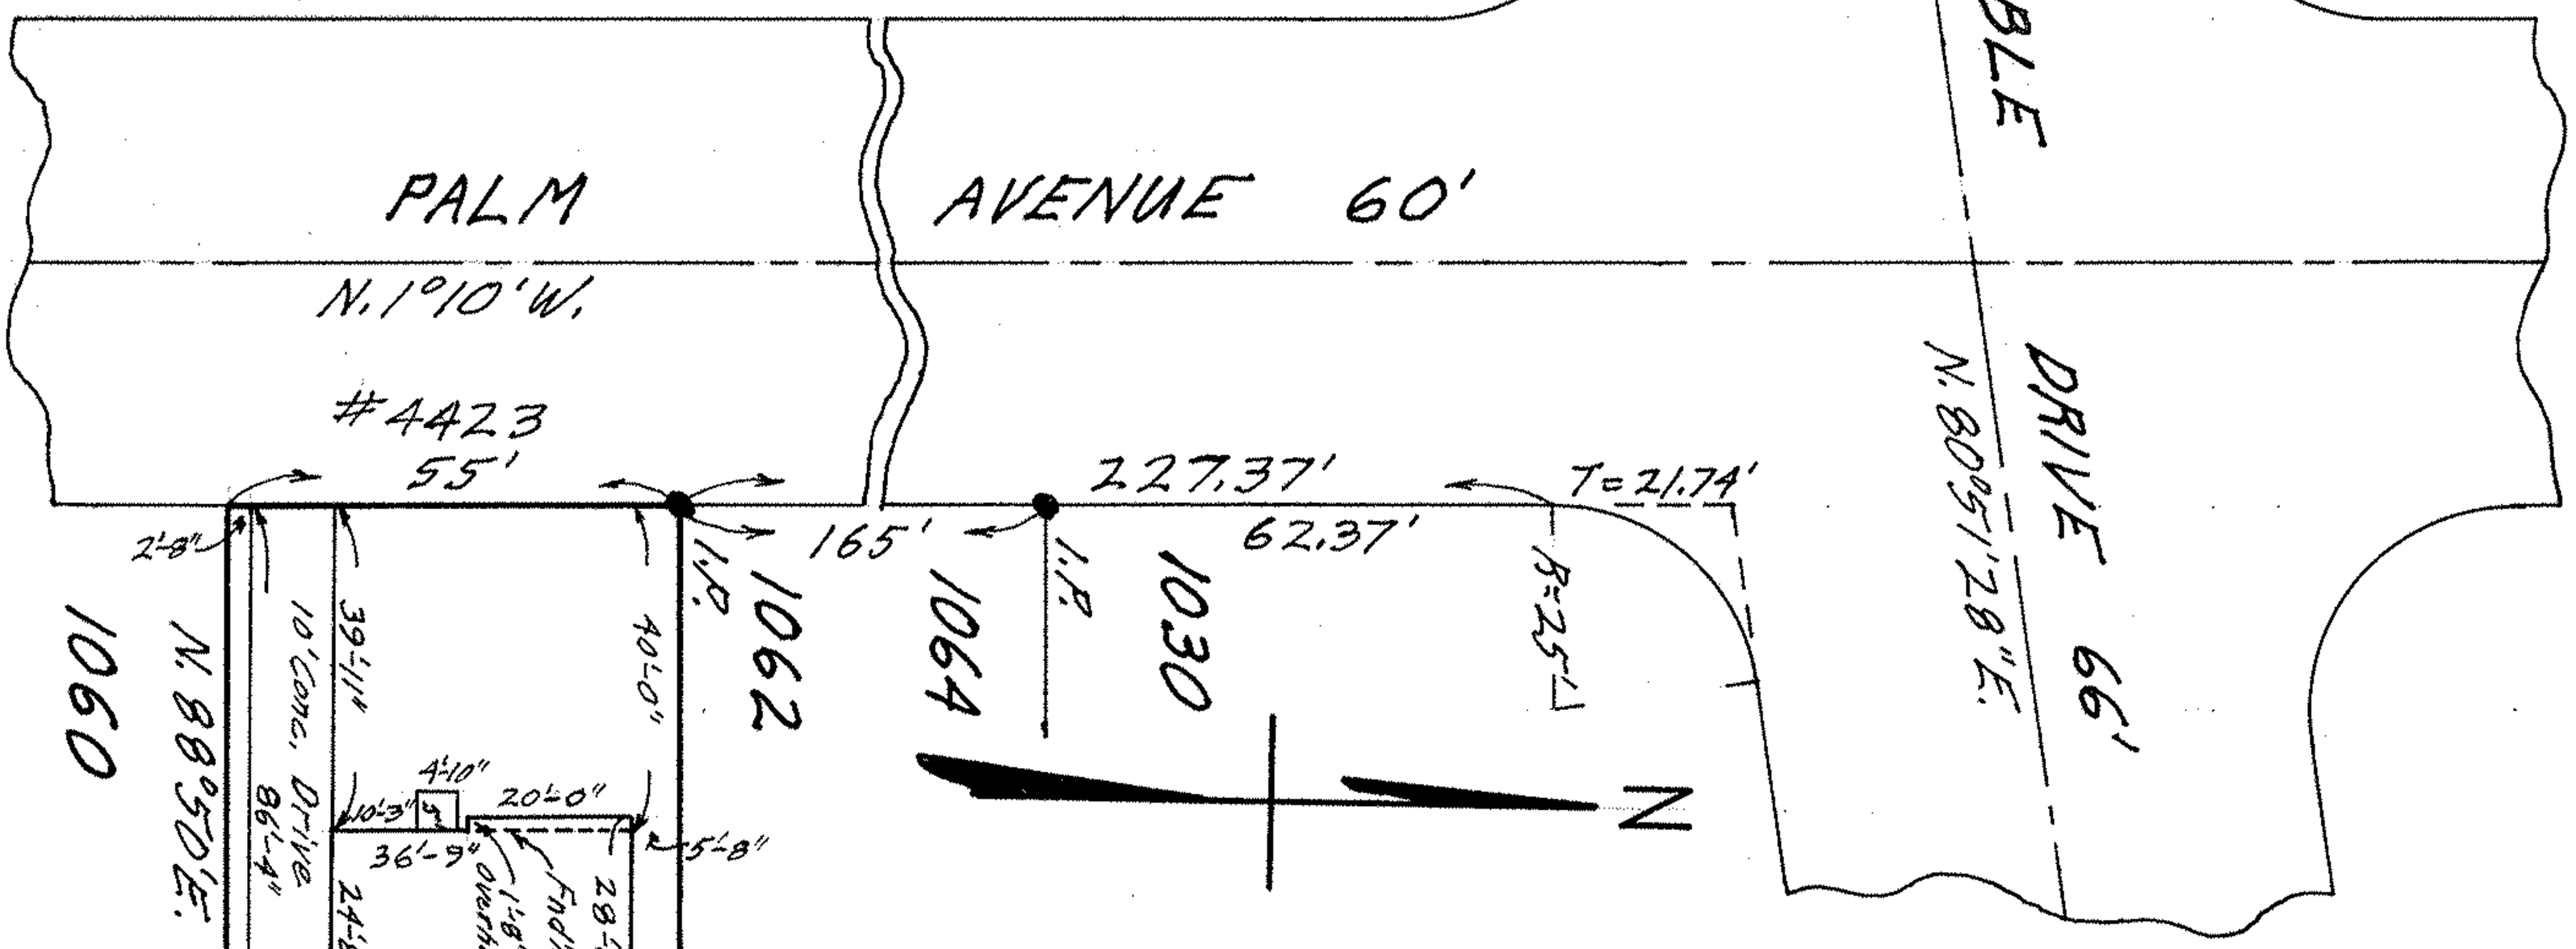

MAP OF SUB-LOT NO. 1061

HOMEWOOD 5TH ADD'N. "C" VOL. 22 PG. 62

ORIG. LOTS 78 & 79 SHEFFIELD TWP.

LORAIN CITY - LORAIN COUNTY - OHIO

SCALE: 1" = 30' AUG. 28-1969 1:30 P.M.

NOTE: There are no encroachments on this property.

Gary E. Penfound REG. SURVEYOR NO. 4457

03-00-078