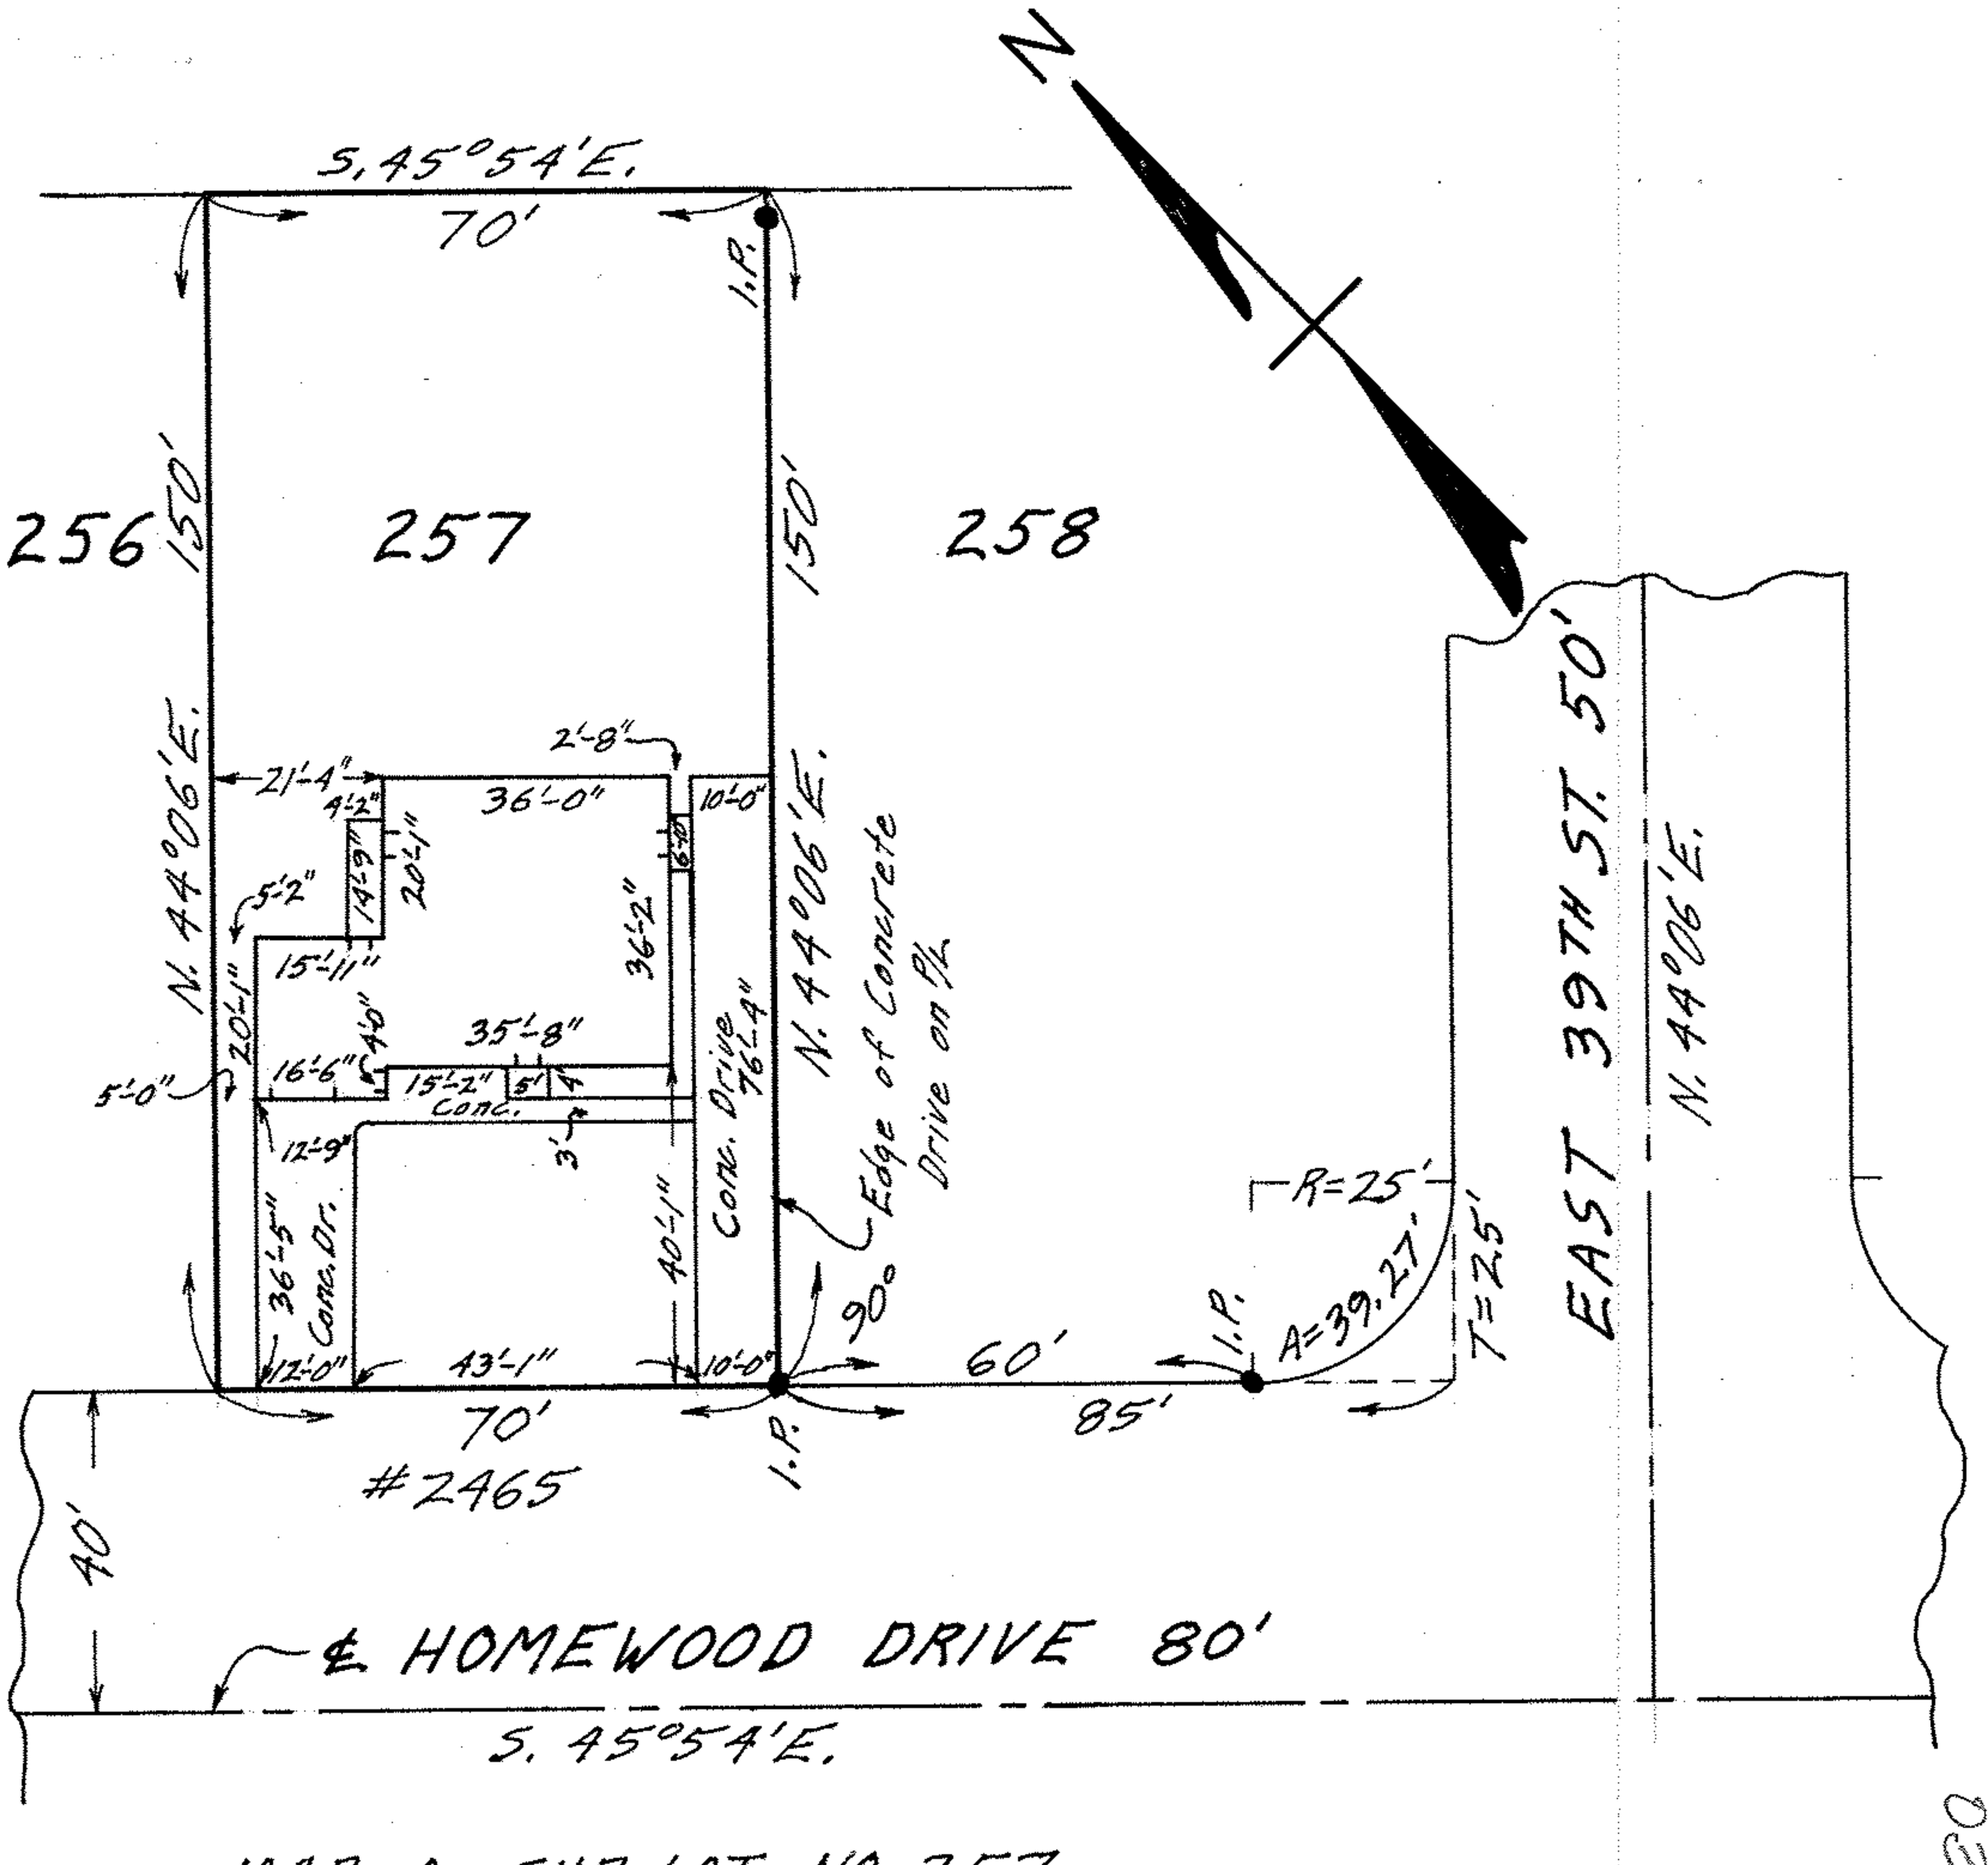

MAP OF SUB-LOT NO. 257
HOMEWOOD ADD'N. Vol. 14 Pgs. 22 & 23
ORIG. LOT 80 SHEFFIELD TWP.
LORAIN CITY - LORAIN COUNTY - OHIO
SCALE: 1" = 30' FEB. 11-1970 5:45 P.M.
NOTE: There are no encroachments on this property.
Gary C. Penfound REG. SURVEYOR NO. 4457
CITY TITLE Co. Order No. E-1028-29
James W. & Elizabeth Smith to Raymond Meyers

03-00-030-109-092
03-00-079-A
Scan # 45321

03-00-030