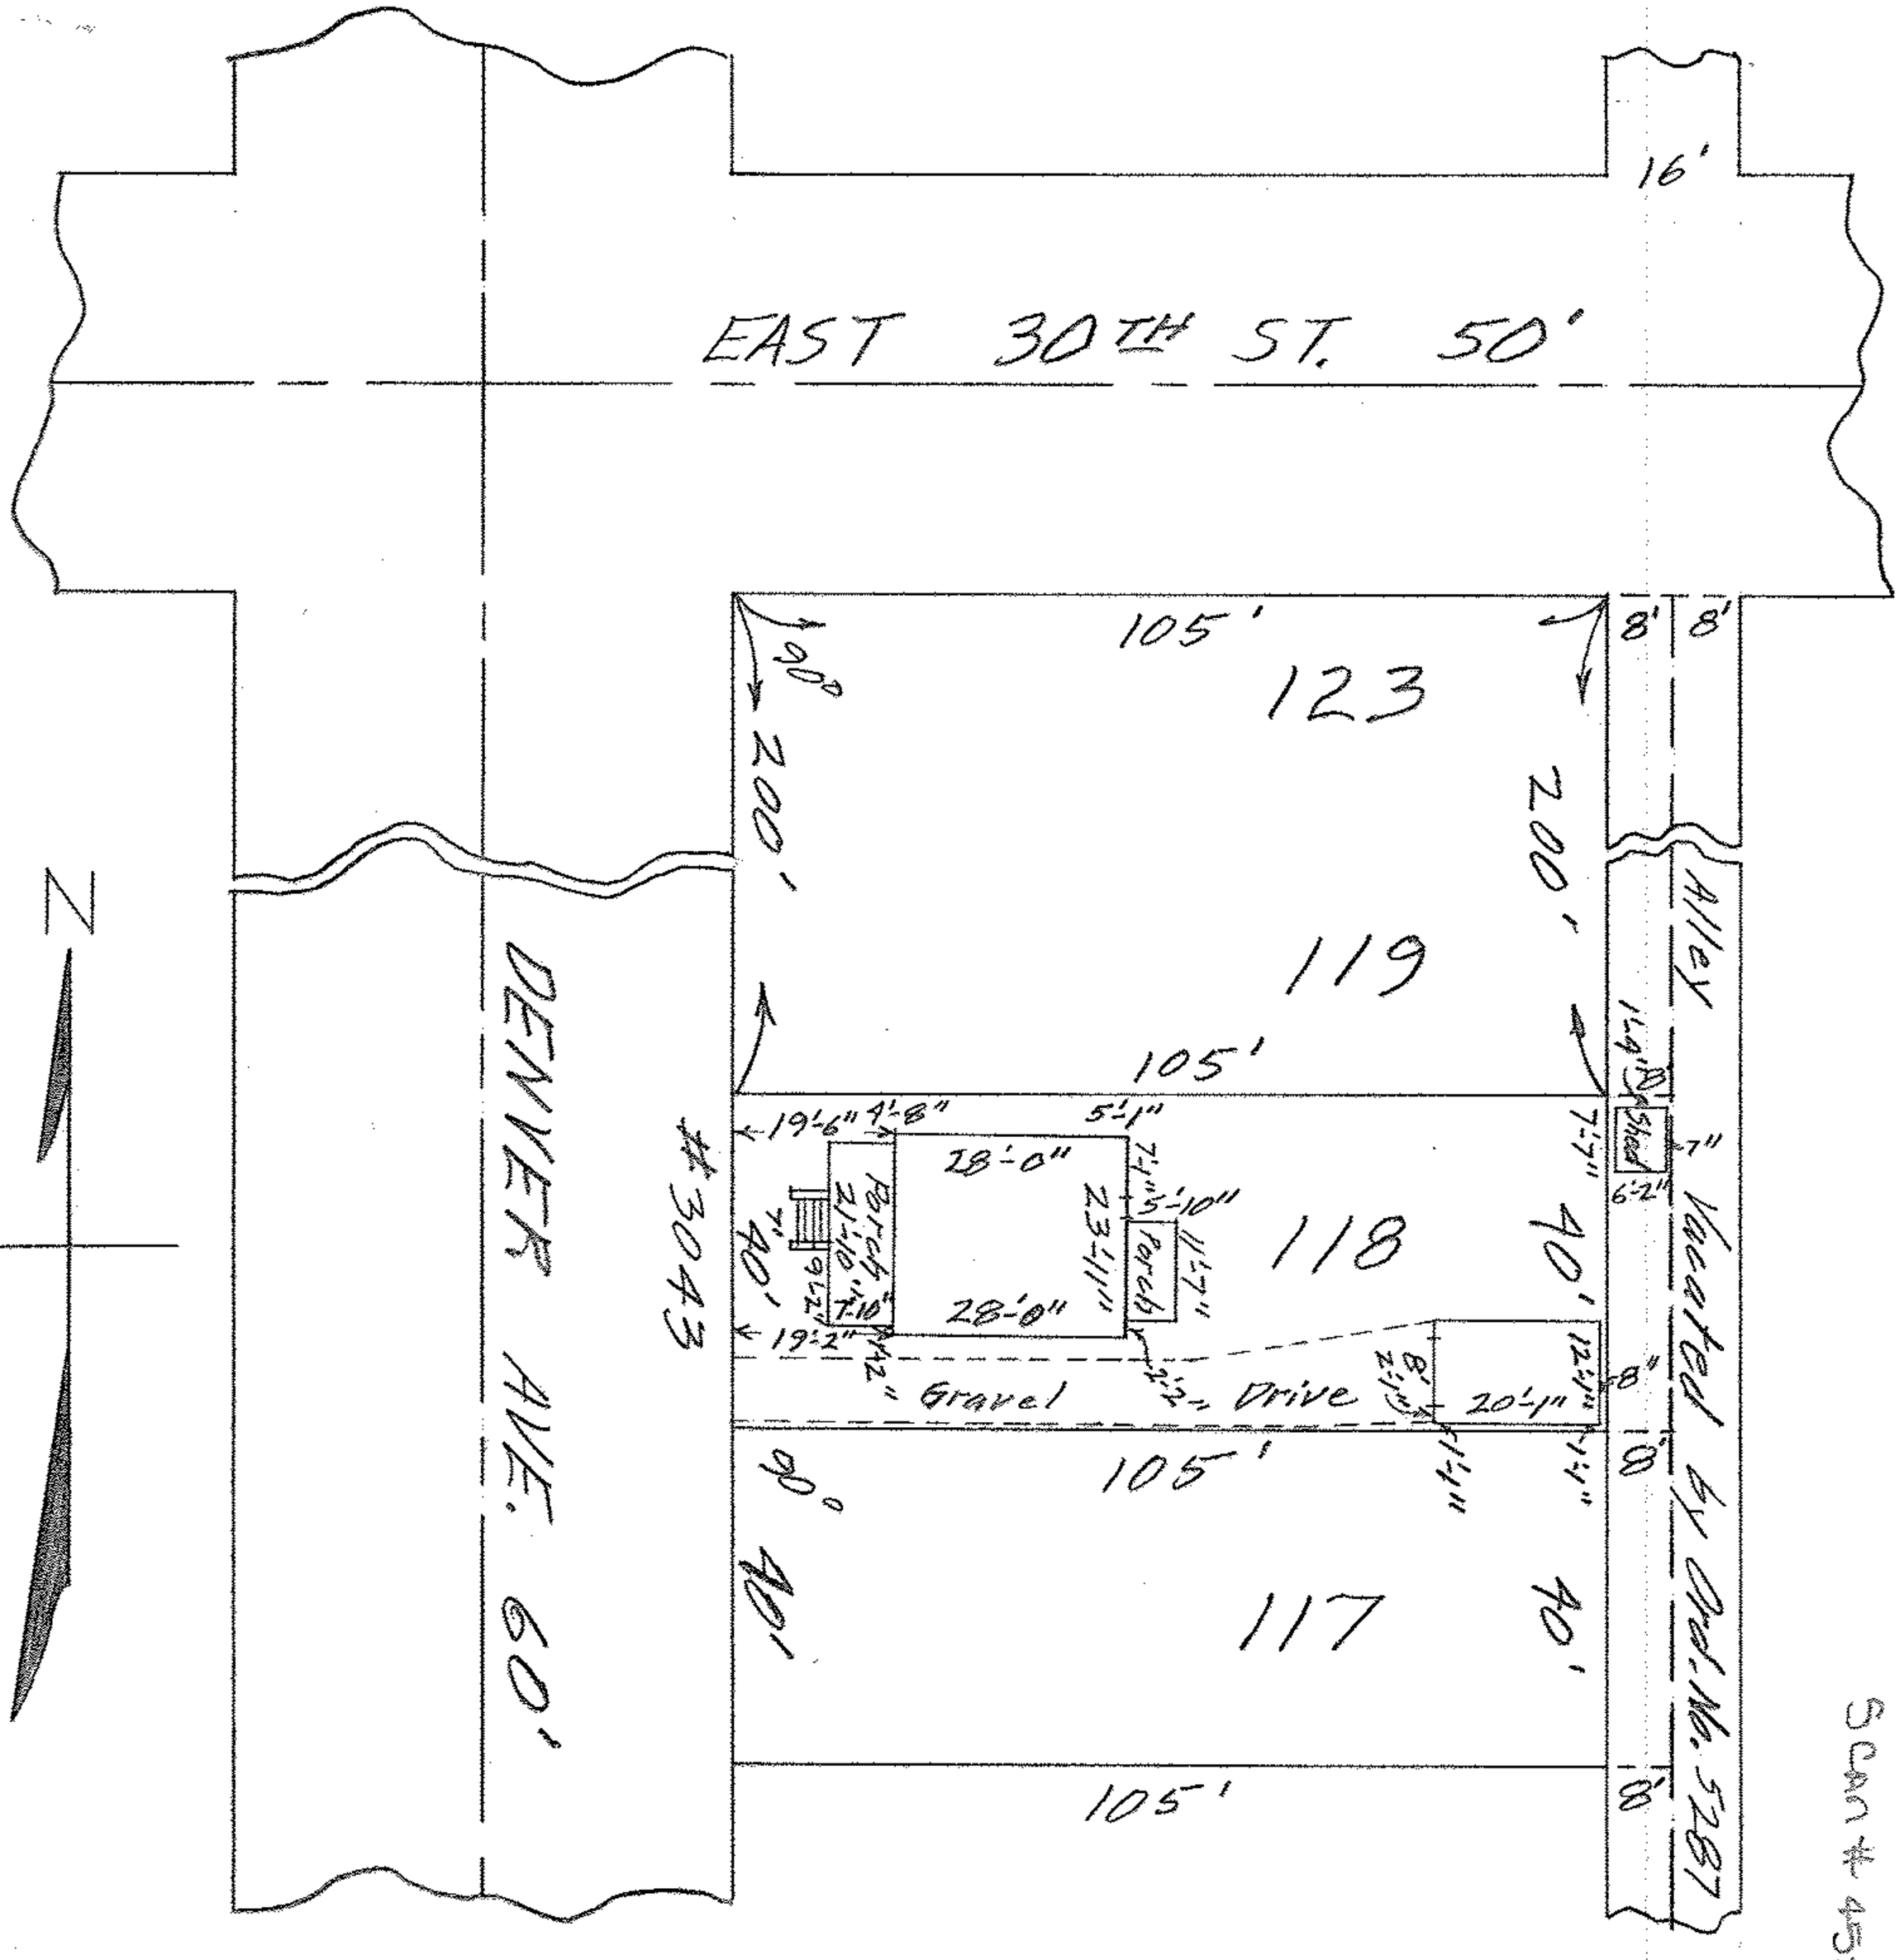

MAP OF SUB-LOT NO. 118
STECK'S TENTH AVE. ALL'T. VOL. 6 PG. 17
LORAIN CITY - LORAIN COUNTY - OHIO
SCALE: 1" = 30' DEC. 3-1963 1:30 P.M.
Surv E. Benfound REG. SURVEYOR

BY

Clarence R. & Mary G. Wandel

03-00-098-B
Scan # 45841

03-00-098