03-00-111-104-002

03-00-111-A 30

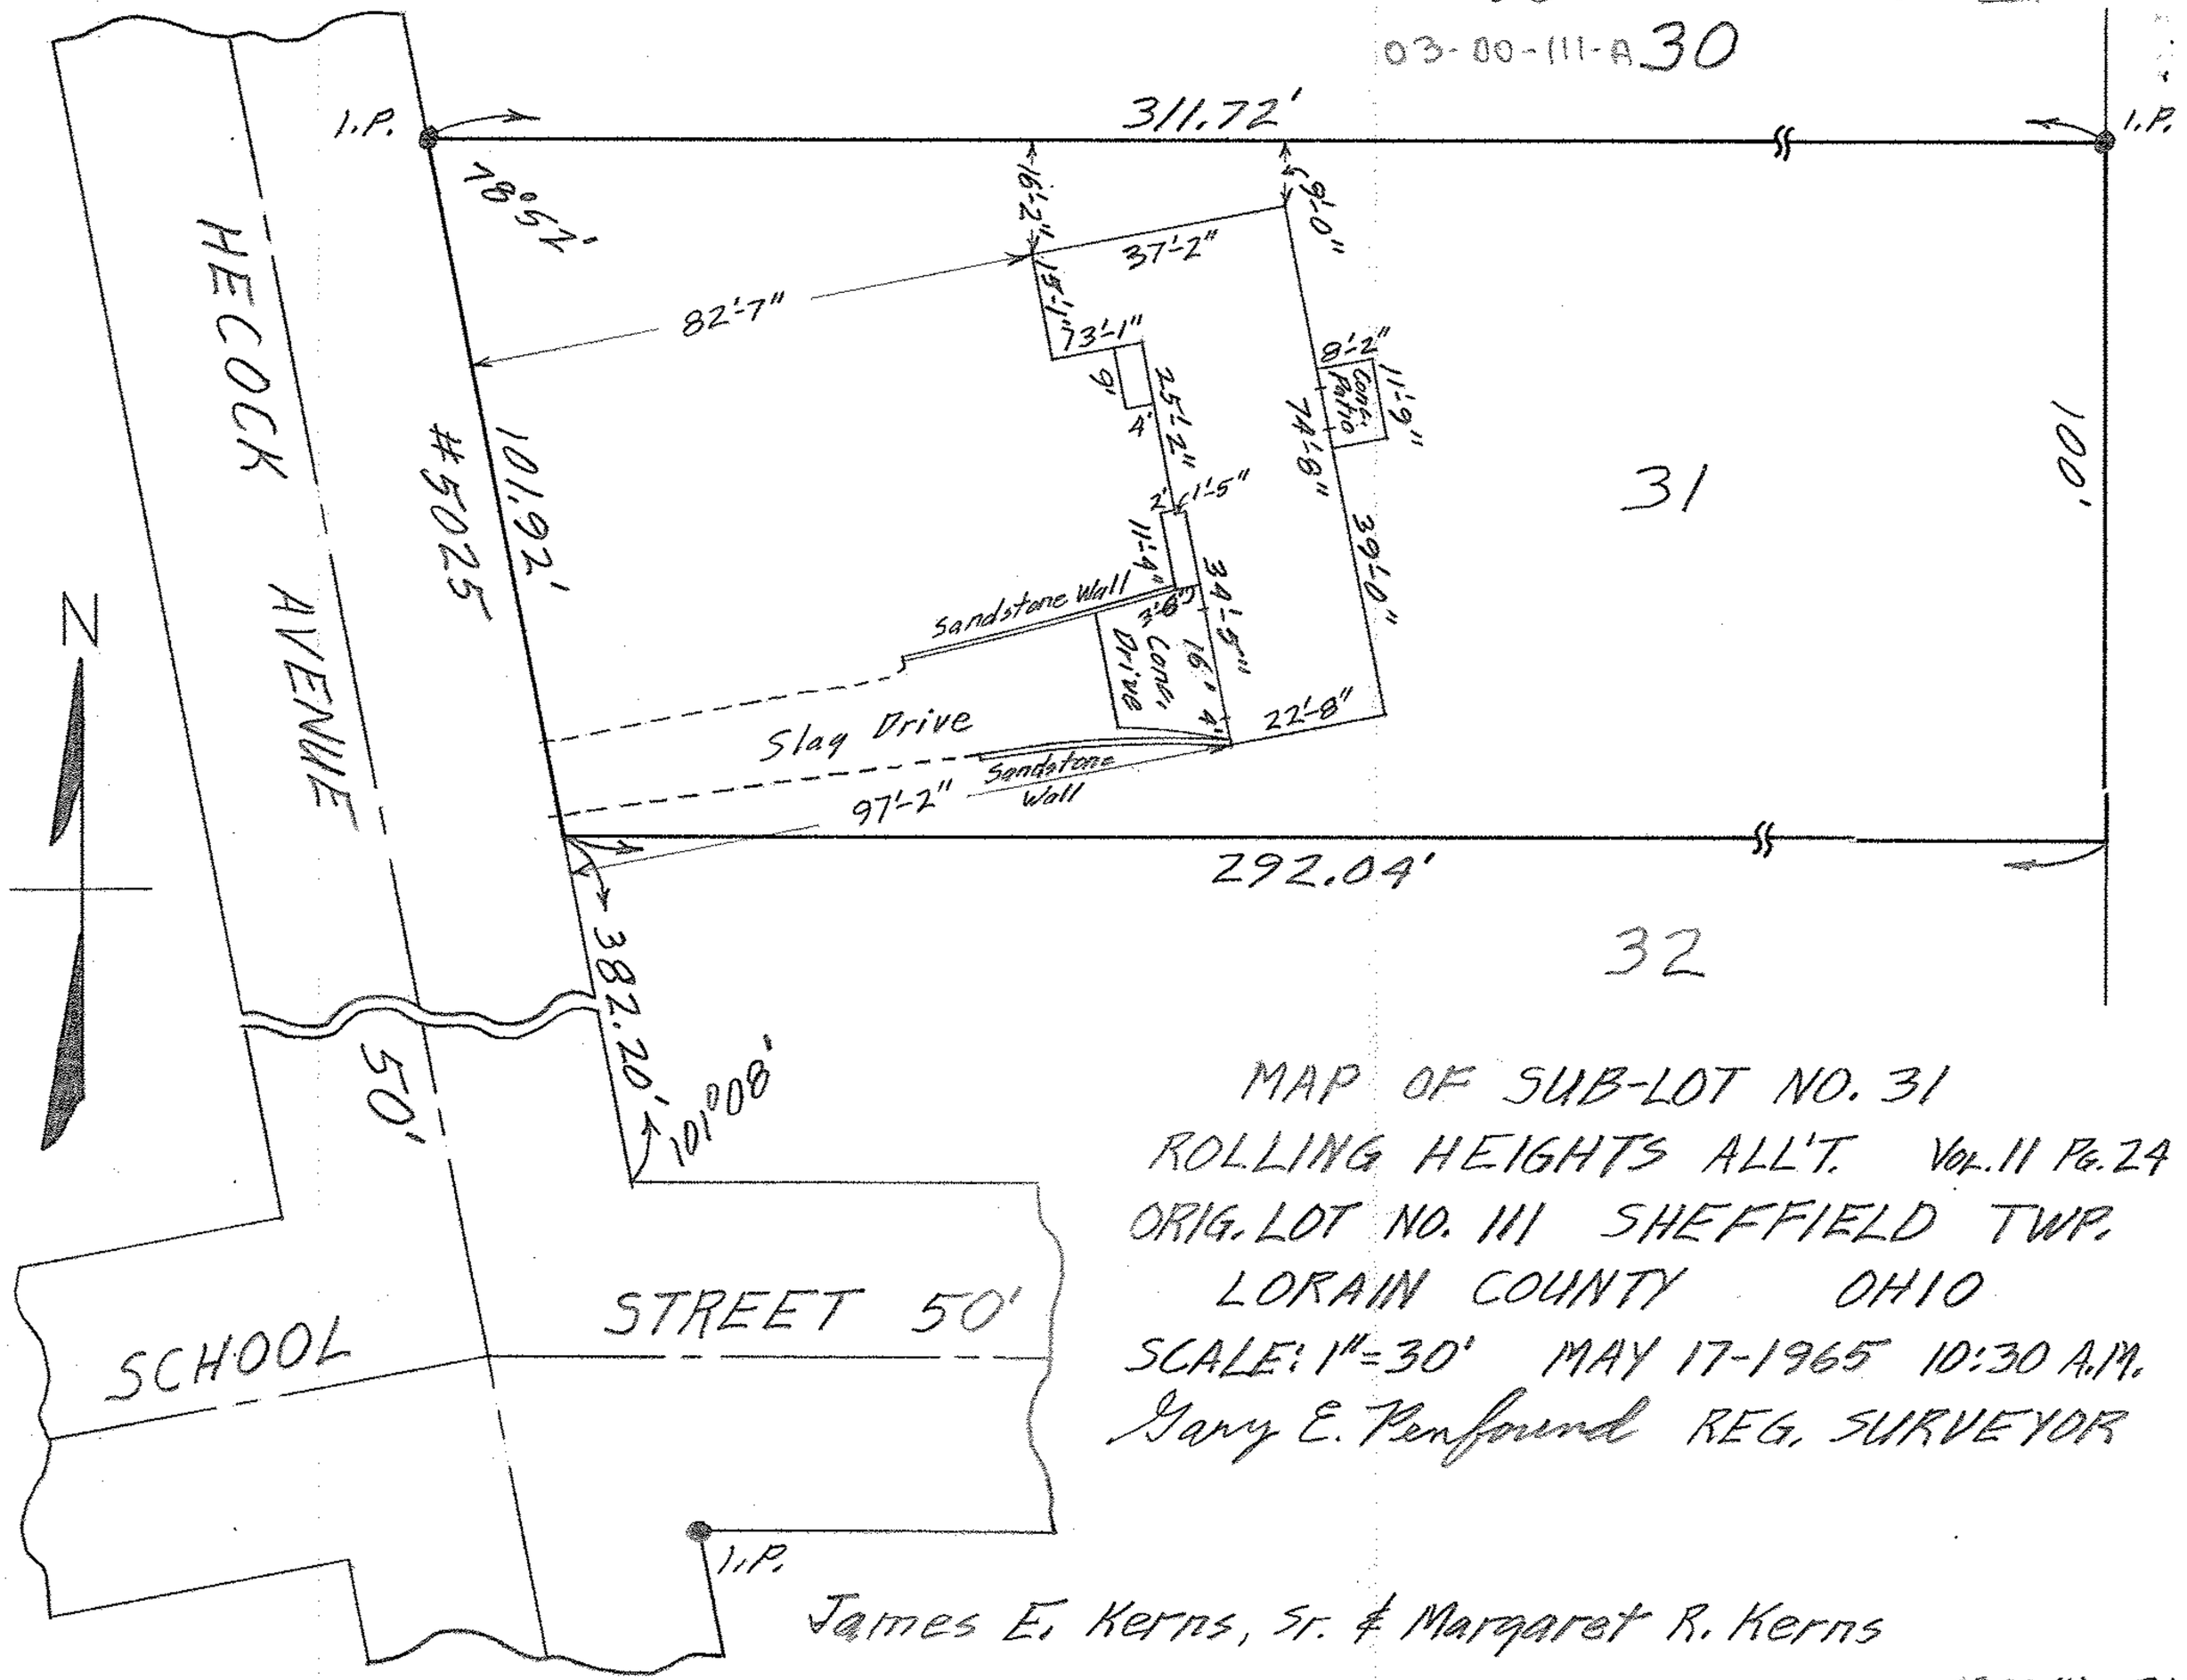

MAP OF SUB-LOT NO. 31
ROLLING HEIGHTS ALL'T. Vol. 11 Pg. 24
ORIG. LOT NO. 111 SHEFFIELD TWP.
LORAIN COUNTY OHIO
SCALE: 1"=30' MAY 17-1965 10:30 A.M.
Gary E. Penfound REG. SURVEYOR

James E. Kerns, Sr. & Margaret R. Kerns

03-00-111 BH