BOUNDARY SURVEY

FOR

HUNTINGTON WOODS BUILDING CO.

&

ALLAN F. SCOTT

SITUATED IN THE CITY OF AVON, COUNTY OF LORAIN AND STATE OF OHIO AND KNOWN AS BEING PART OF ORIGINAL AVON TOWNSHIP LOT NO. 1

SCALE: 1" = 120'

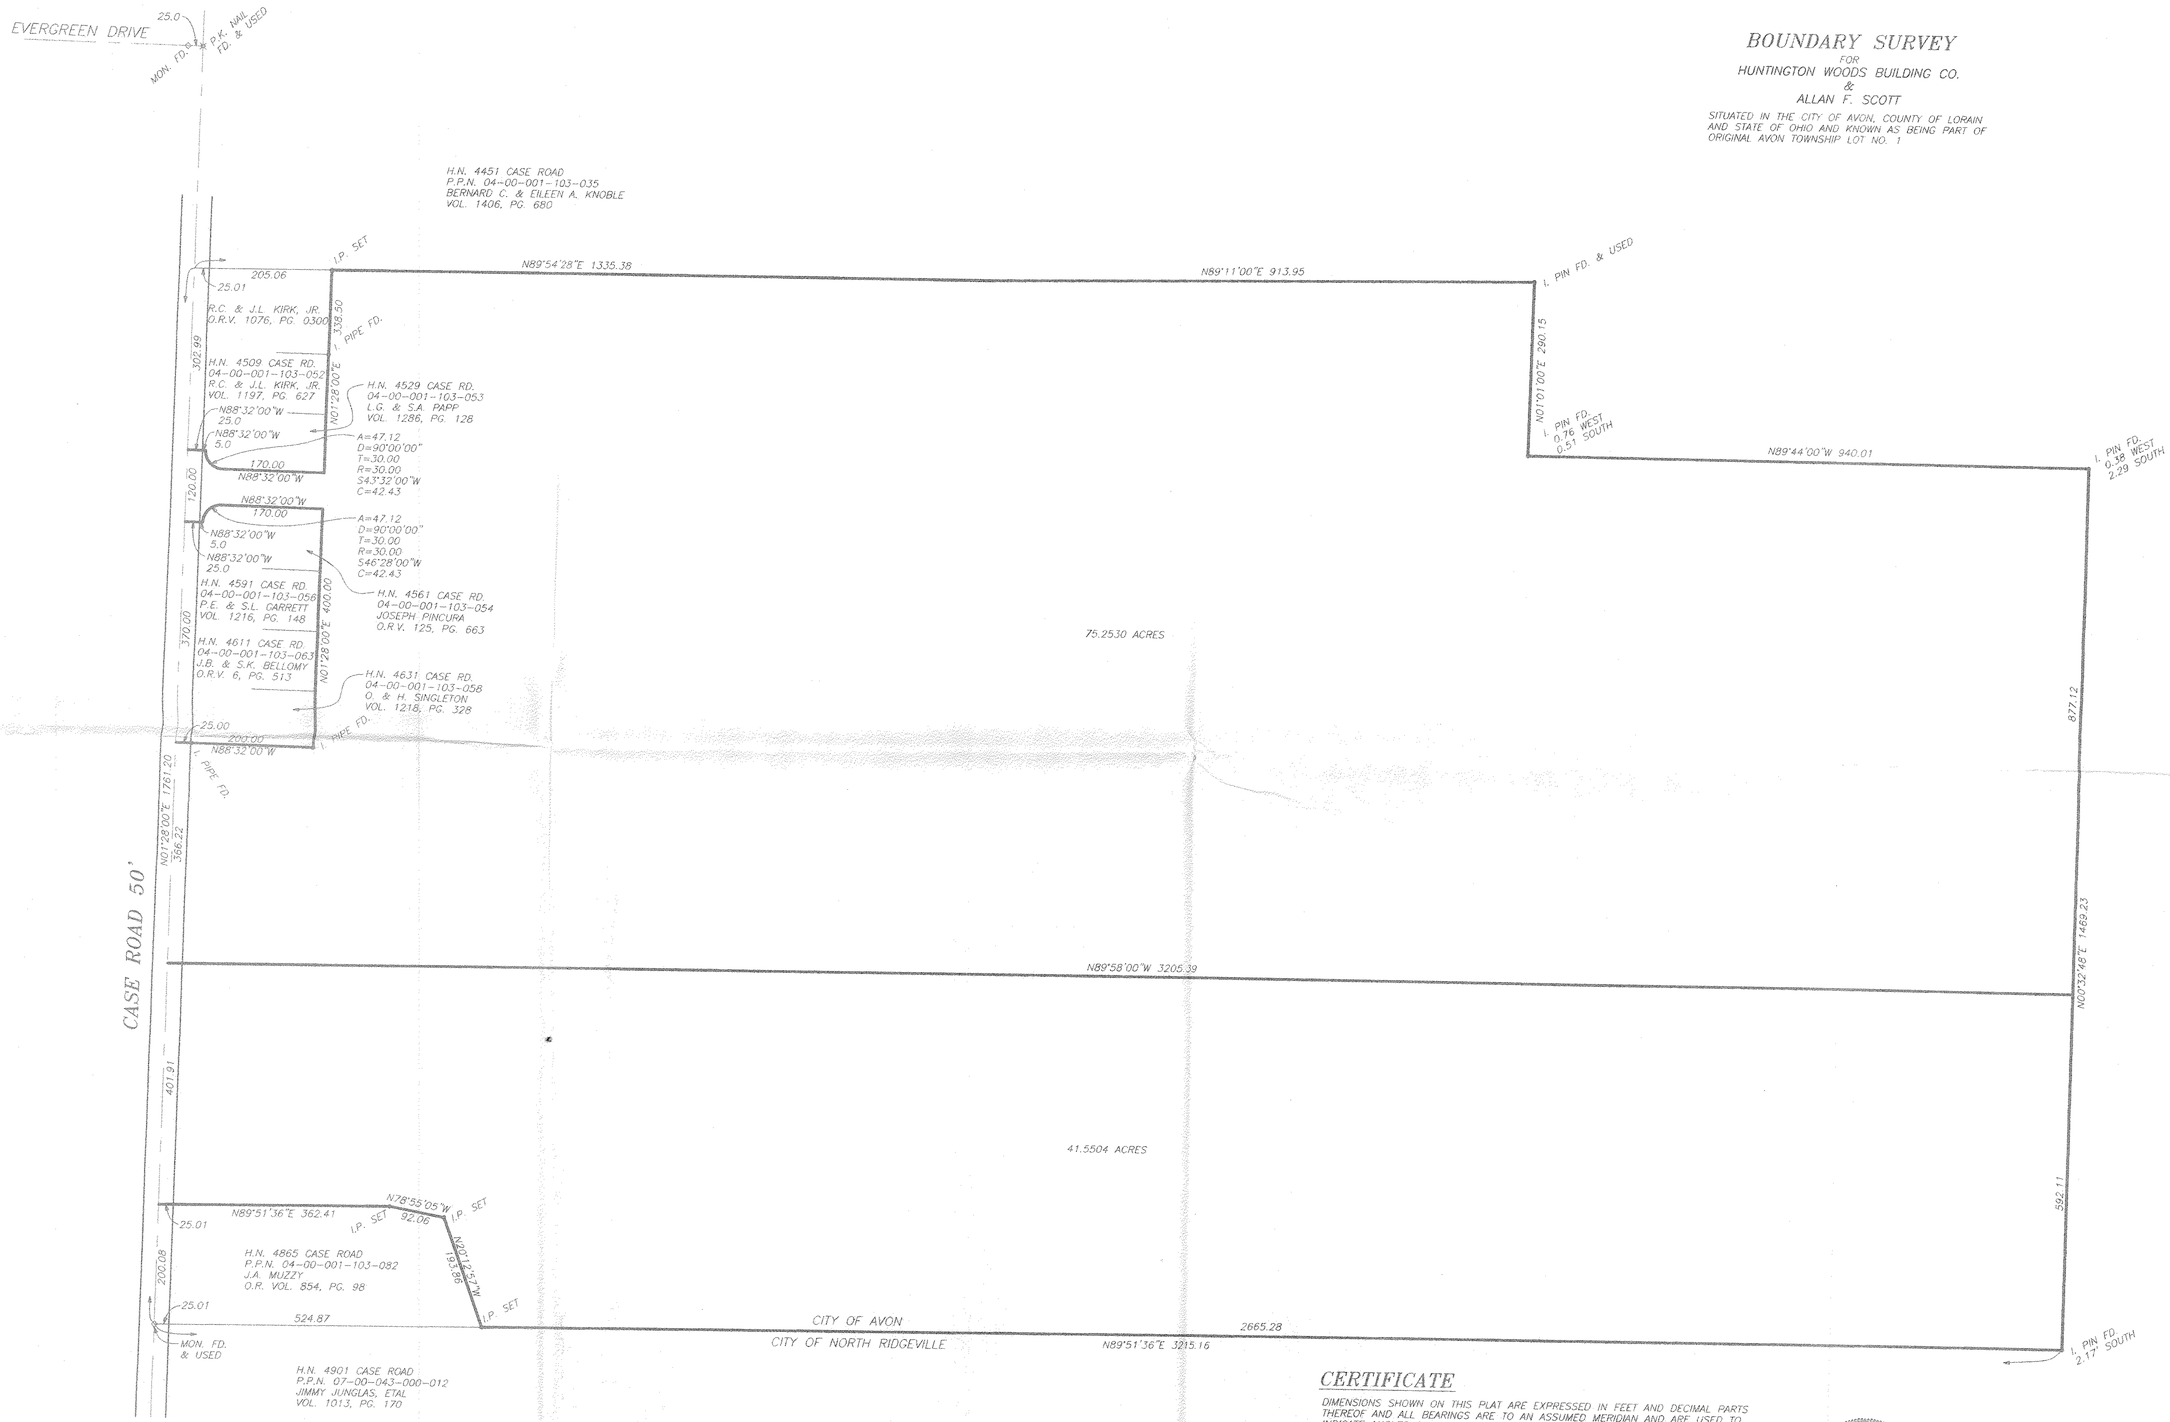

CERTIFICATE

DIMENSIONS SHOWN ON THIS PLAT ARE EXPRESSED IN FEET AND DECIMAL PARTS THEREOF AND ALL BEARINGS ARE TO AN ASSUMED MERIDIAN AND ARE USED TO INDICATE ANGLES ONLY. PERMANENT MONUMENTS WERE FOUND OR SET AT ALL POINTS INDICATED HEREON. I HEREBY CERTIFY THAT I HAVE SURVEYED THE PREMISES AND PREPARED THIS PLAT AND THAT SAID PLAT IS CORRECT.

JAMES A. RESAR, P.E., P.S.
REG. OHIO SURVEYOR #6361

STATE OF OHIO
JAMES A. RESAR
6361
REGISTERED SURVEYOR

SEE REV. PG 3 OF 3

J.A.R. Engineering & Surveying, Inc.
CONSULTING ENGINEERS / SURVEYORS
24629 DETROIT ROAD WESTLAKE, OHIO 44145
Phone:(440)-871-8345

1/1

12/98