


Survey Performed for:
 Larry D. Hines & Cheryl A. Hines
 Brighton Congregational Church of Brighton, Ohio
 Danny L. Wright, Jr. & Nicole L. Wright


Plat of Survey
 State of Ohio
 County of Lorain
 Township of Brighton
 Original Lot 17 - Tract 7

 

Note: Right of Way for SR 18 depicted hereon was taken from
 ODOT Right of Way Plan HUR-18-24.17-24.68 - 1954

Legend

- iron pin or pipe found as noted
- Concrete Marker found as noted
- 5/8" rebar w/ plastic cap stamped "RAFTER A LTD"
- Nail or spike set as noted

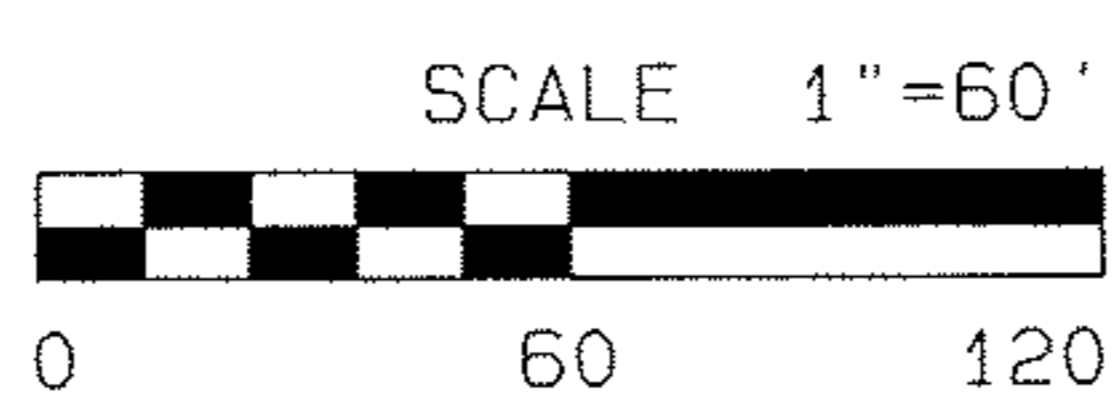

fence line

References

- Recordings listed hereon
- Plat of 3 Parcels Split - Gary Penfound - 1961
 - ODOT Right of Way HUR-18-(24.17- 24.68)
 - PLAT Vol. 17 PG 29A - SR 18 centerline monumentation
 - Plat of Survey - Brighton TWP Cemetary
 - Lorain County Aerial Map - 1966
 - DV Y PG 471-472
 - DV 989 PG 869
 - DV U PG 693
 - DV 818 PG 63
 - DV 26 PG 398
 - DV 33 PG 540
 - DV 5 PG 450

Basis of Bearing is based upon
 Ohio State Plane Coordinates, North Zone (3401) NAD83
 w/ a 2007 adjustment obtained from
 GPS observations made at the survey site

APPROVED
LORAIN CO.
MAP DEPT
DATE 10-28-10
PAGE 17-1F
17-07-017A
BY R. MAINES
*10-02121-D



- PP # 17-07-017-000-023
 retracement survey of
 Parcel # 1 split by Gary Penfound - 1961
 Danny L. Wright Jr. & Nicole L. Wright
 INST # 20090305196
 0.1583 acres as surveyed
- PP # 17-07-017-000-021
 retracement survey of
 Parcel # 2 split by Gary Penfound - 1961
 Roy C. Greene, Jr. & Jane I. Greene
 DV 983 PG 574
 see original Deed Vol. 818 PG 63
 0.1867 acres as surveyed

- PP # 17-07-017-000-024
 retracement survey of
 Parcel # 3 split by Gary Penfound - 1961
 Trustees of the Brighton
 Congregational Church of Brighton, Ohio
 DV 645 PG 179
 0.9166 acres as surveyed
- PP # 17-07-017-000-007
 Larry D. Hines & Cheryl A. Hines
 INST # 2009-0305198
 1.0850 acres as surveyed

Field Survey Performed on 4-23,4-24,5-1,
 5-28, 6-13, 6-23,6-24 of 2009 by Rafter A. LTD.
 under the supervision of Richard A. Fredrickson, P.S.

Redrawn on Oct. 22, 2010 w/ current ownership for
 updated legal description for Parcel # 2

Rafter A. LTD
 Land Surveying & Engineering
 10980 Lagrange Road
 Elyria, OH 44035
 440-309-5275

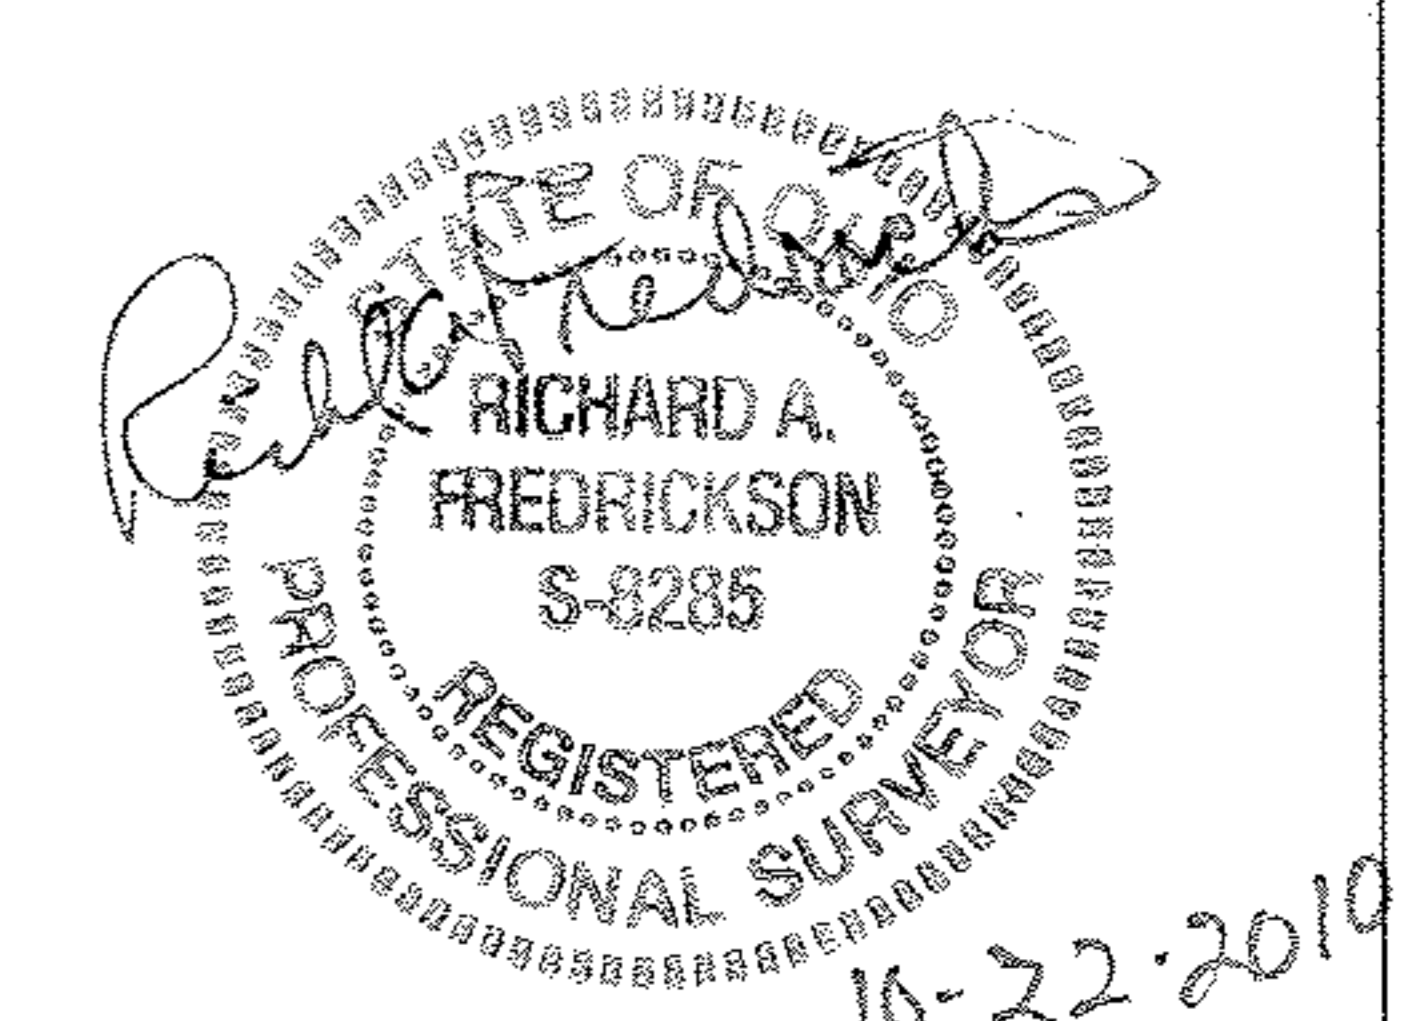 

500
 200-000-810-20-11
 100
 120-000-110-20-11