


04-00-018-13Z-003-005

04-00-018-D

Scan # 45443

LAKE ERIE.

MAP OF SUB-LOTS 45-46-60
GRA-GULL ALLOTMENT PROPOSED
ORIG. AVON TWP. SECTION NO. 18
AYON-LAKE VILLAGE-LORAIN CO. OHIO
SCALE 1" = 30' APRIL 22-1954-530PM
C.E. Perfound Registered Surveyor.

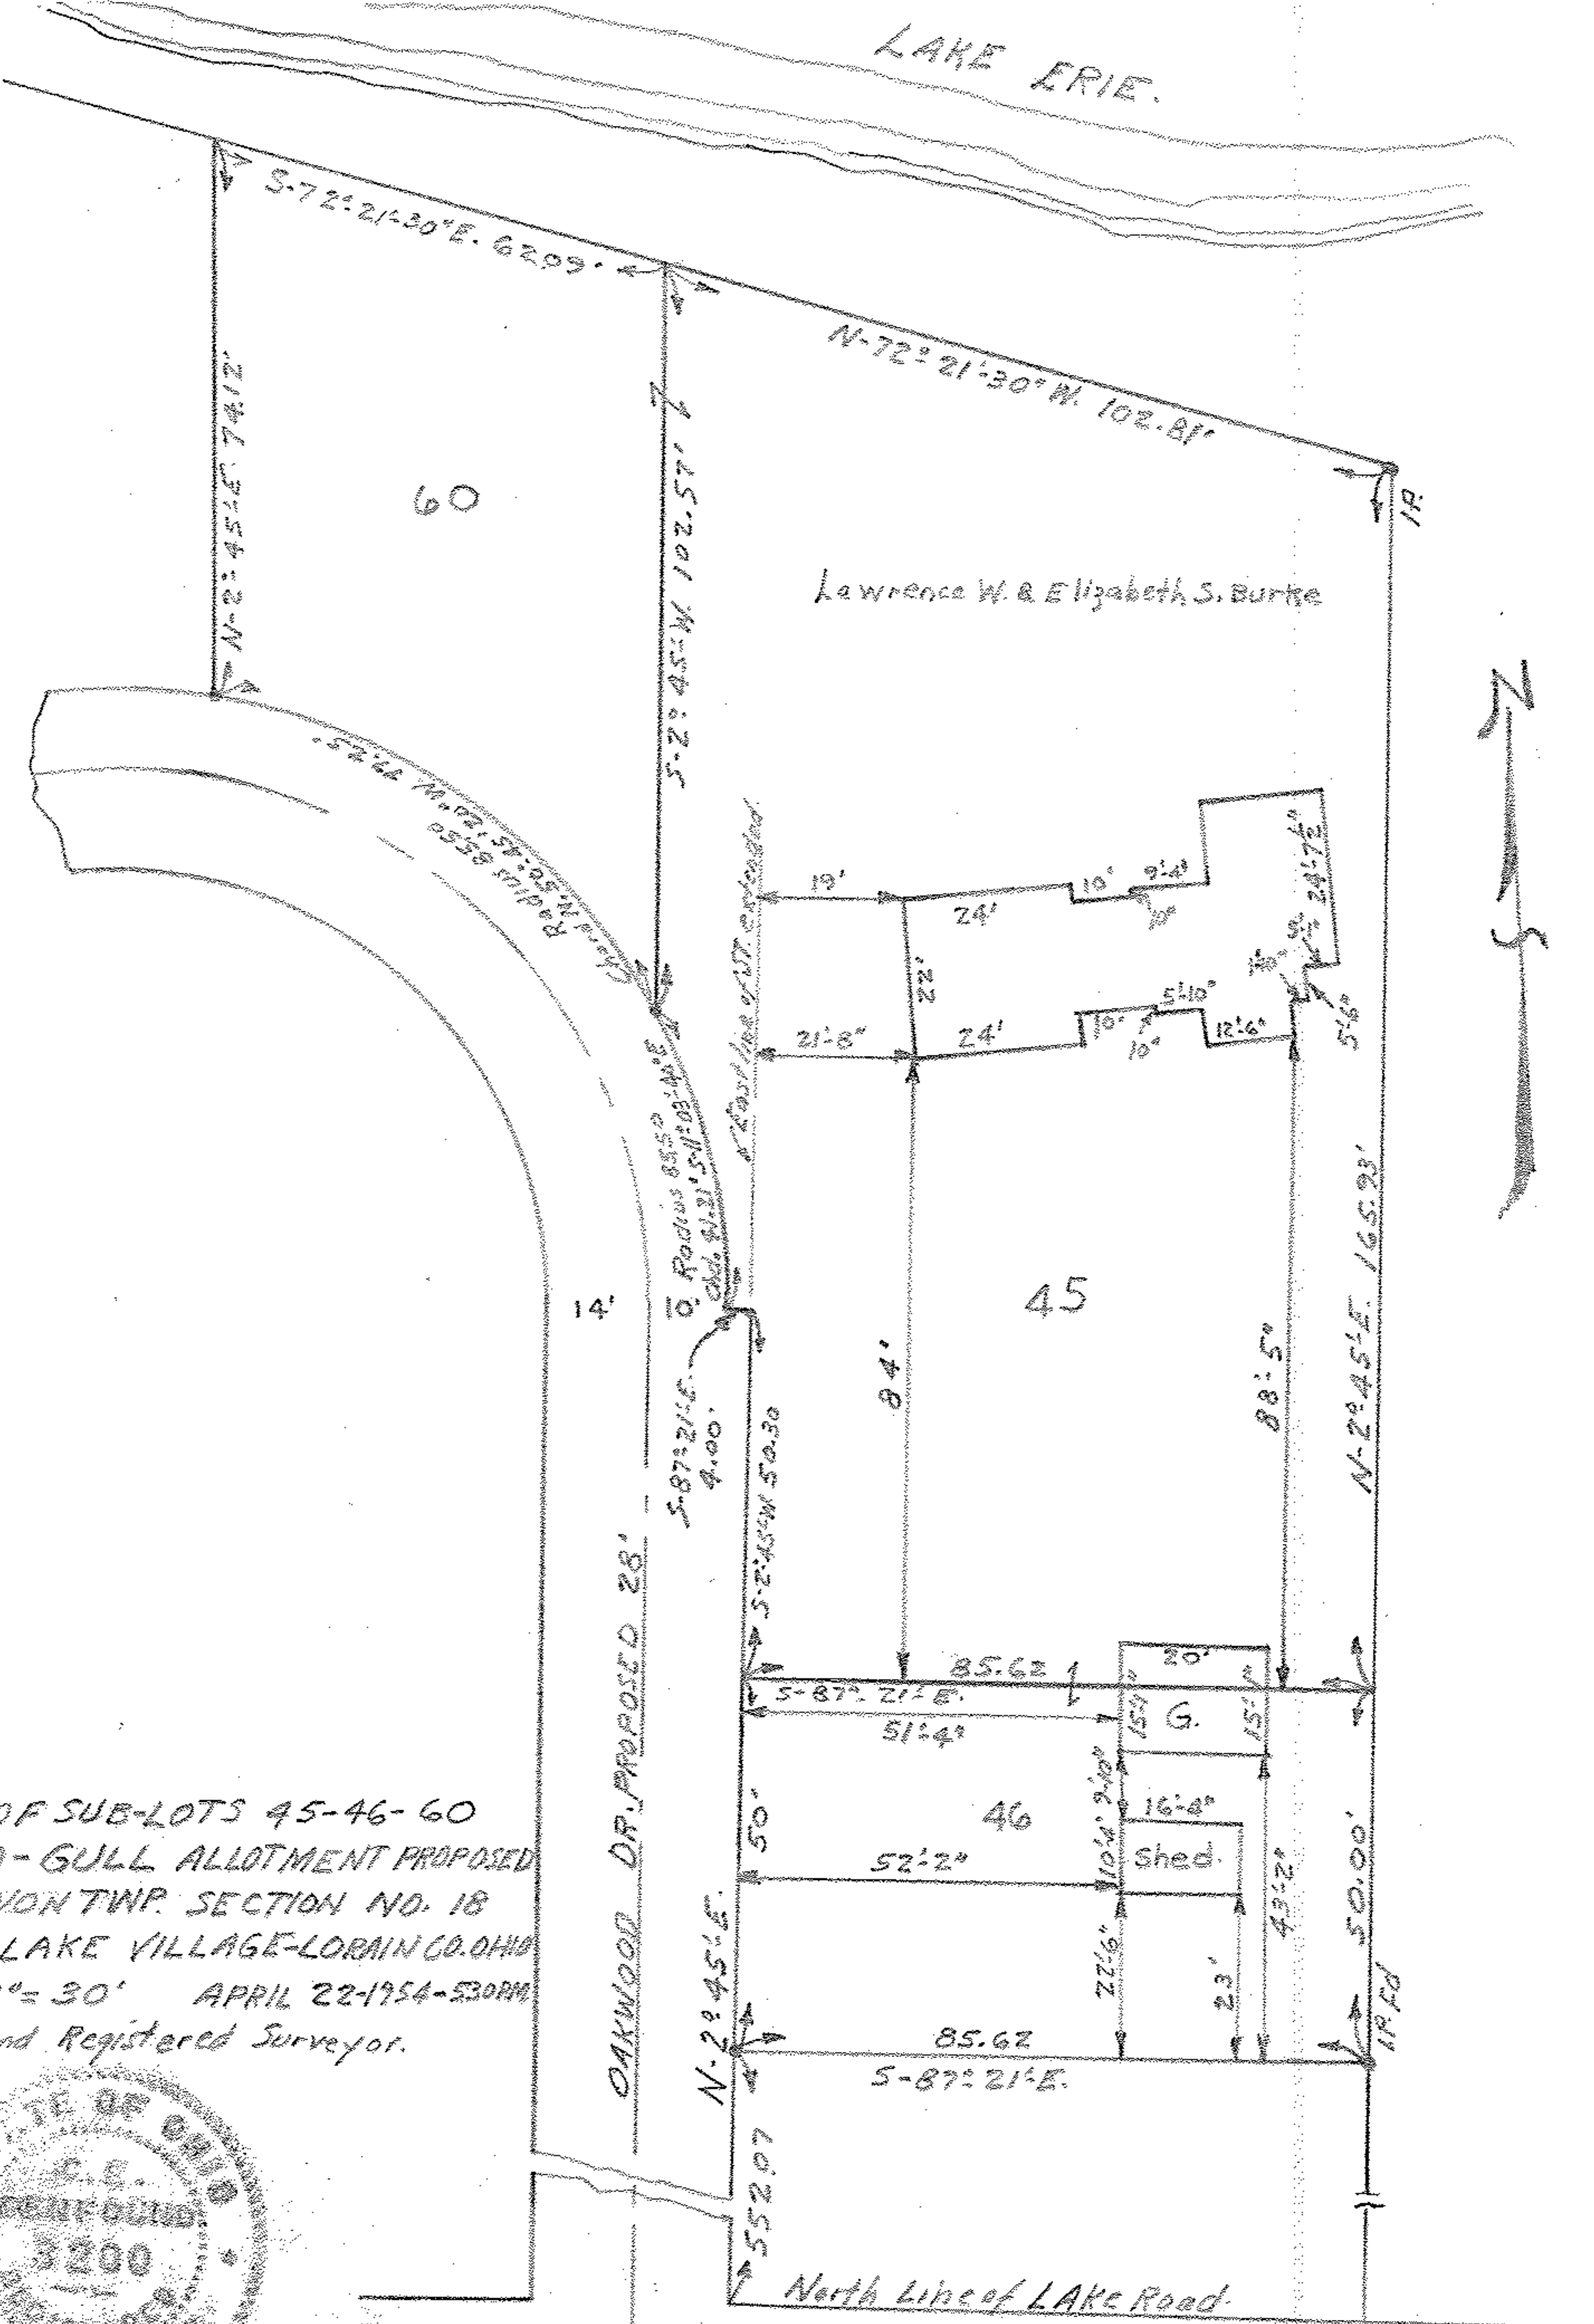

04-00-018

Order No. C-77365