MAP OF PROPERTY SURVEY

PART OF
AVON TOWNSHIP SECTION Nº 19
CITY OF AVON LAKE · COUNTY OF LORAIN · STATE OF OHIO

NORTH
SCALE 1" = 100'

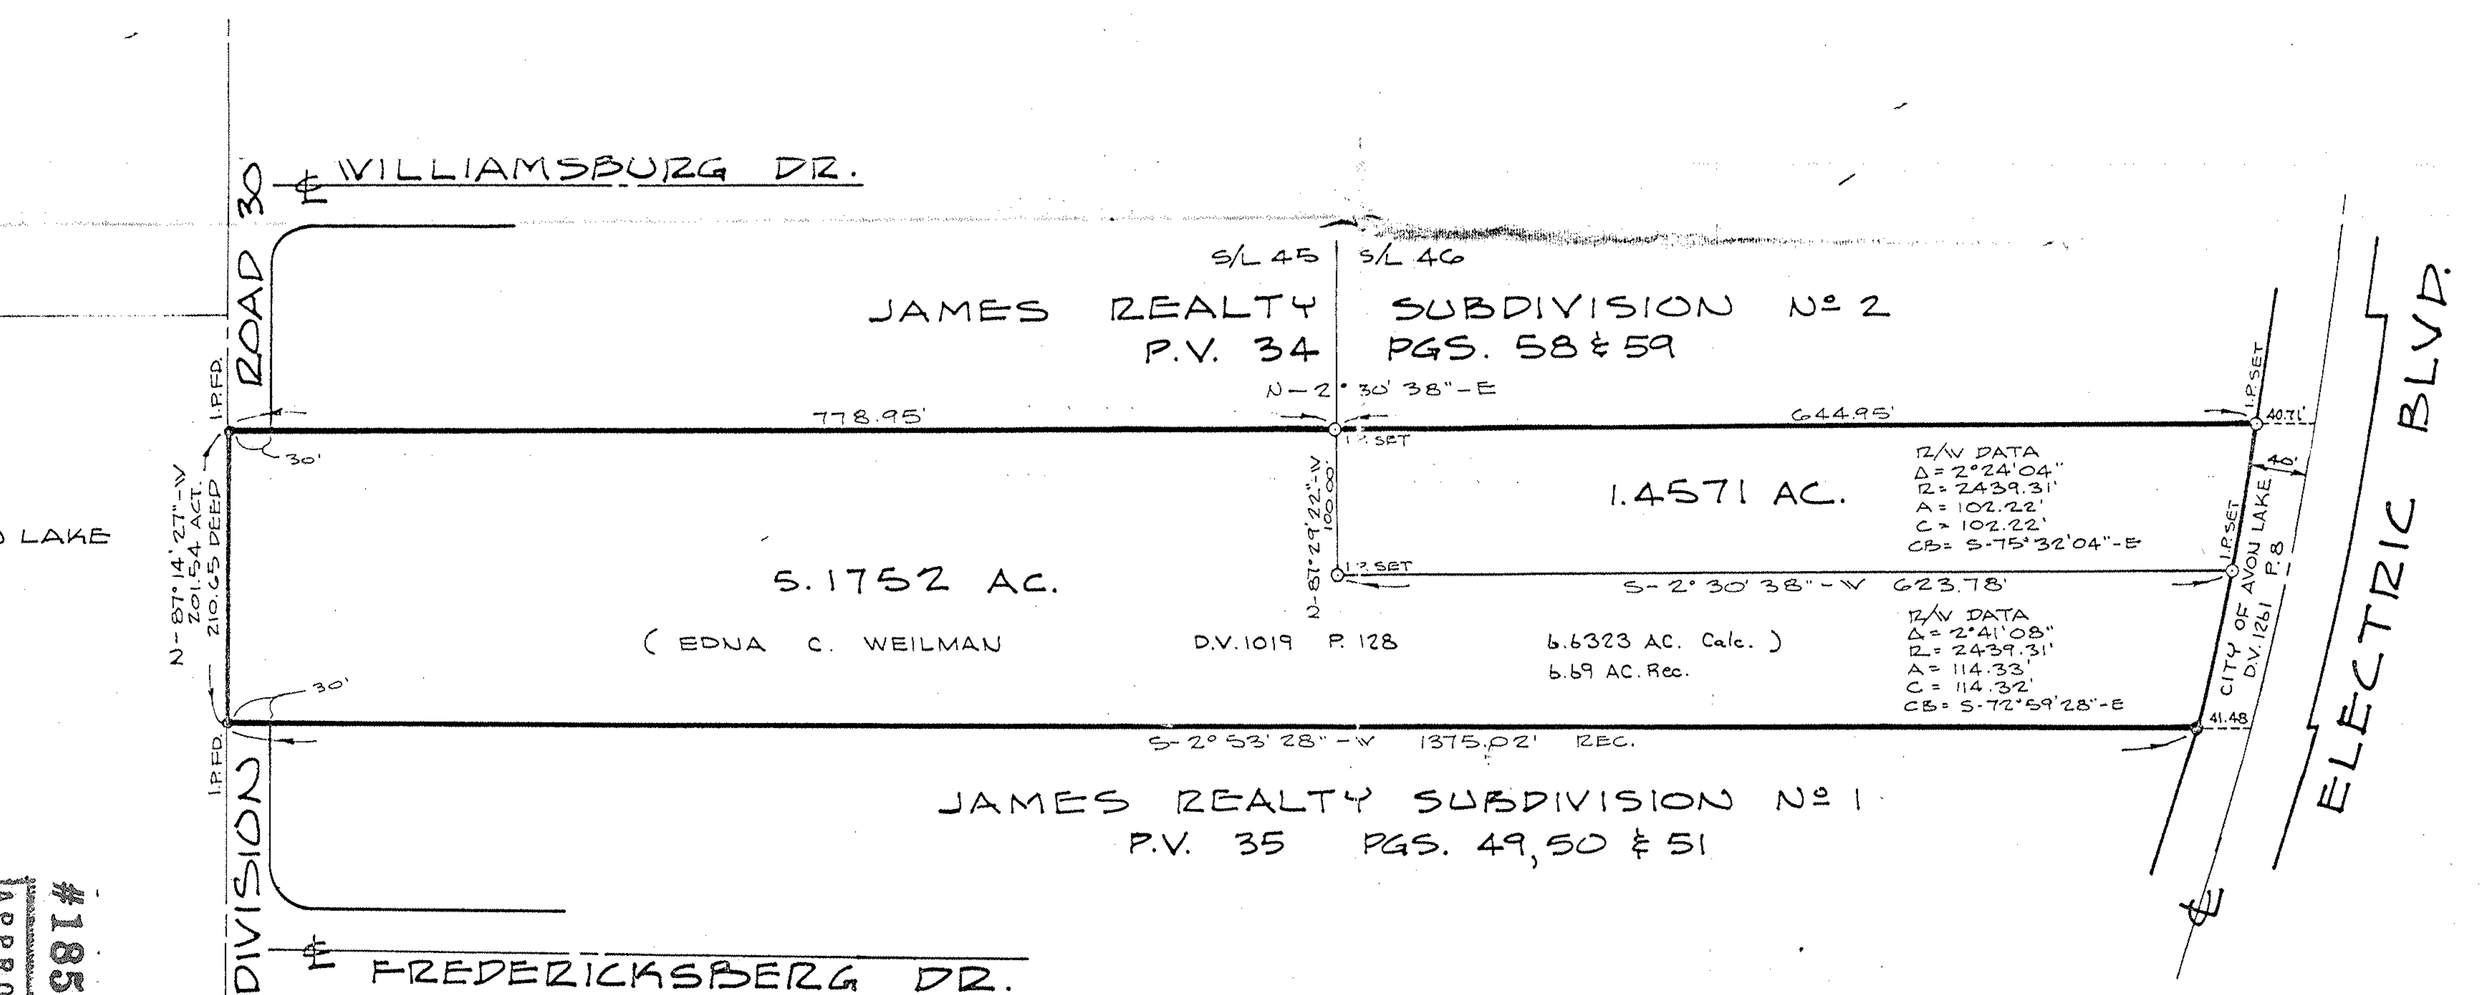

APPROVED
LORAIN CO.
MAP DEPT.
DATE 7-10-89
PAGE Accord.
BY T. Weyland
VOID AFTER
18517

#18517

STATE OF OHIO
DAVID L. ELWELL
6333
REGISTERED SURVEYOR

David L. Elwell
REG. SURVEYOR
2-10-89

ENGINEERS / SURVEYORS
ASSOCIATES
INCORPORATED
424 Middle Avenue
P.O. Box 89
Elyria, Ohio 44036

04-00-019-134-093