04-00-023-105-028-030, 033

MUNICIPAL ENGINEERING SUBDIVISIONS CITY AND FARM SURVEYS

STATE OF OHIO
REGISTERED { PROFESSIONAL ENG. NO. 1580
SURVEYOR NO. 985

RAY E. HOLLIS
CIVIL ENGINEER & SURVEYOR
1796 BROADWAY
LORAIN, OHIO

LORAIN PHONE
CHERRY 4-1557

ELYRIA PHONE
FAIRFAX 2-5117

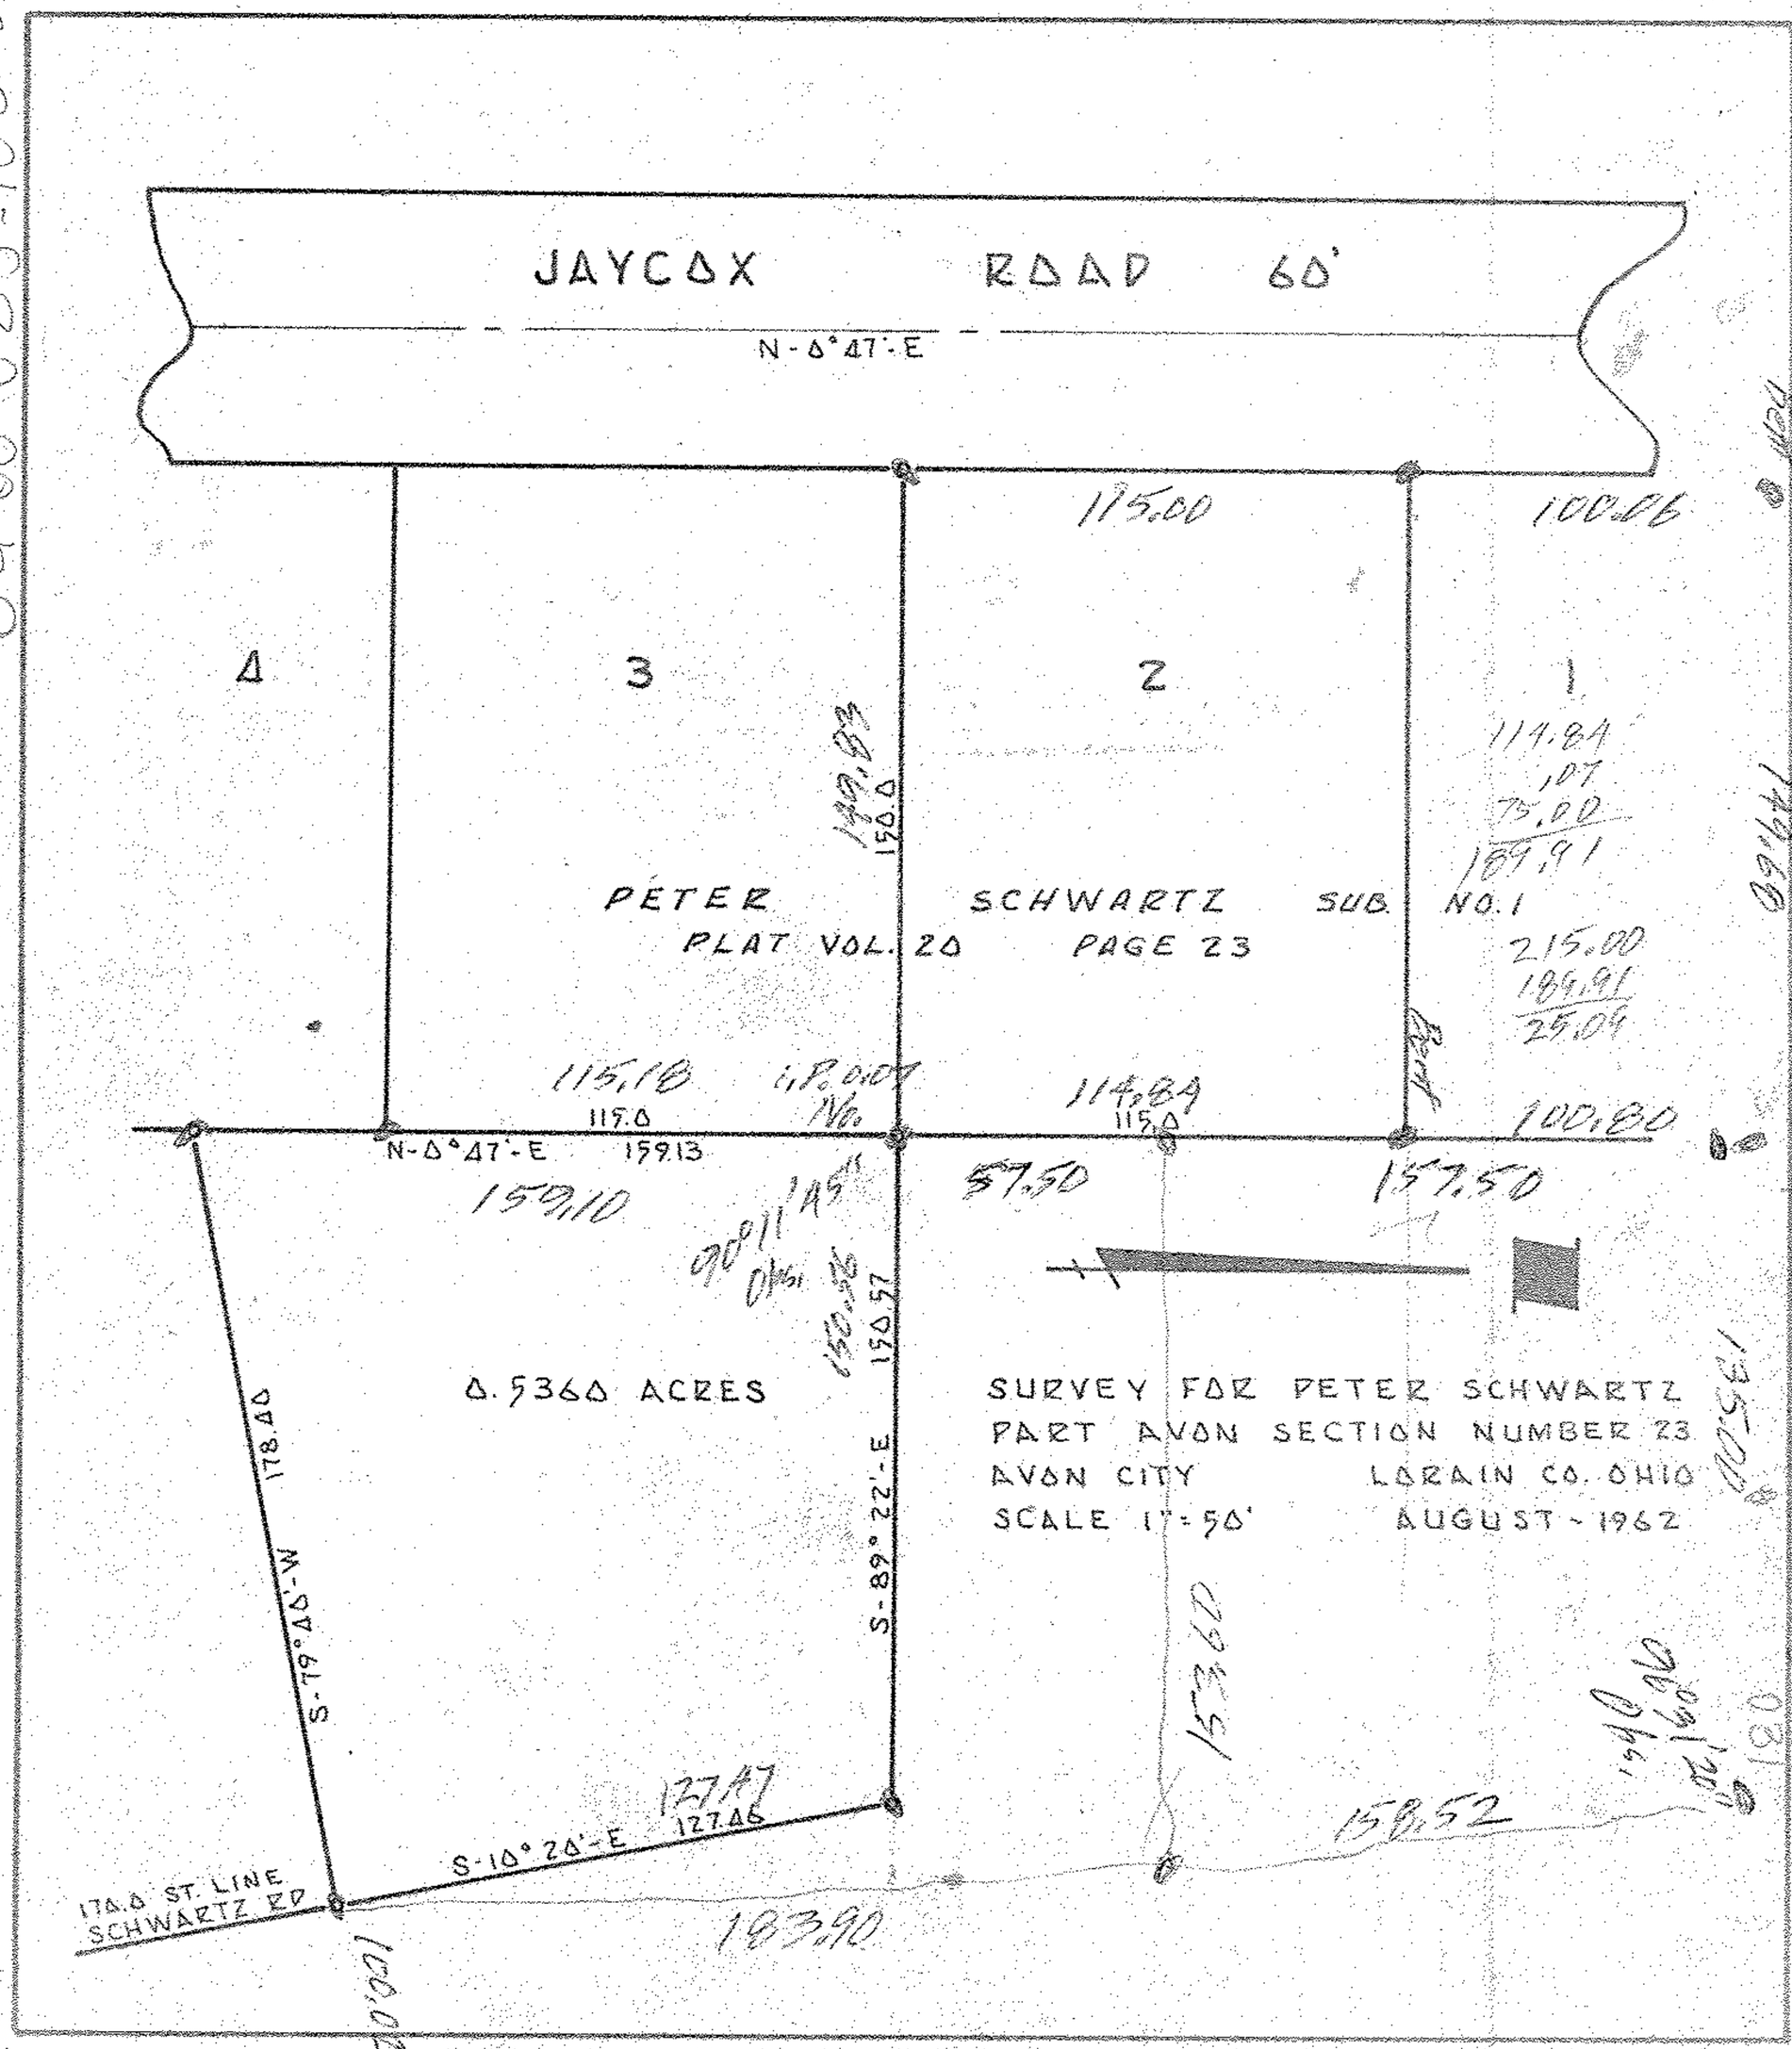

LH 616