
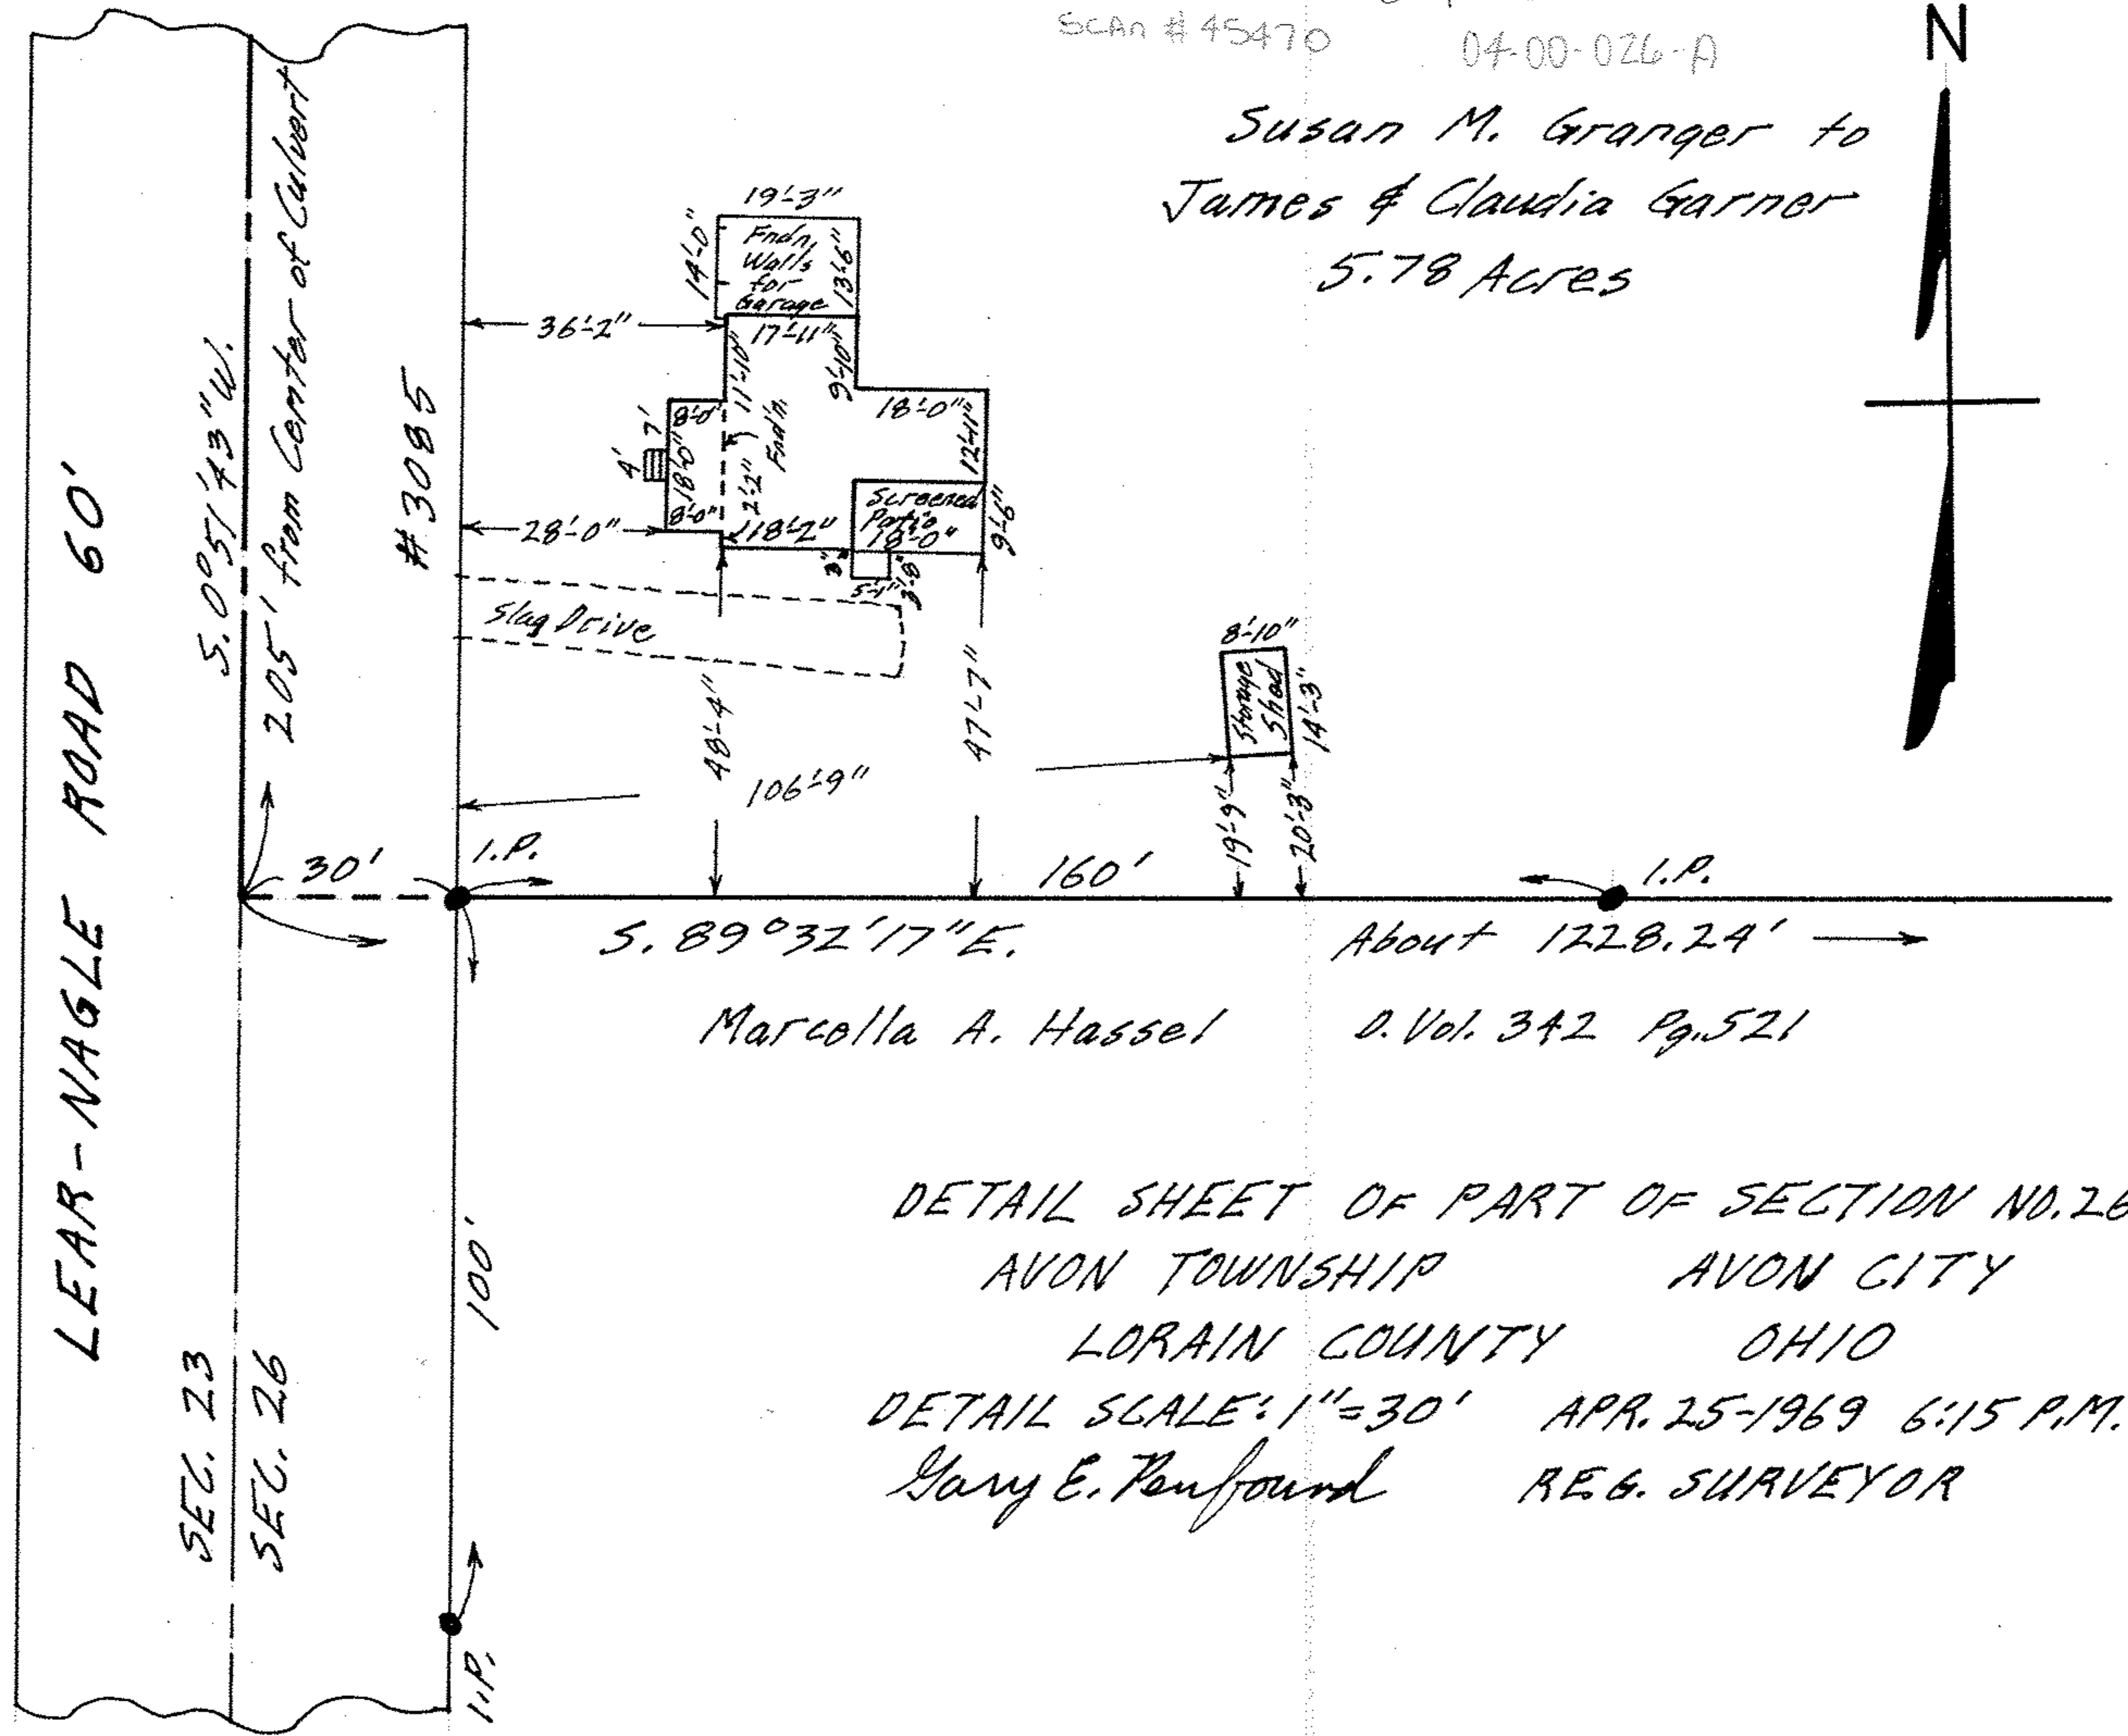


04-00-026-103-040

SCAN # 45470

04-00-026-A

Susan M. Granger to  
James & Claudia Garner  
5.78 Acres

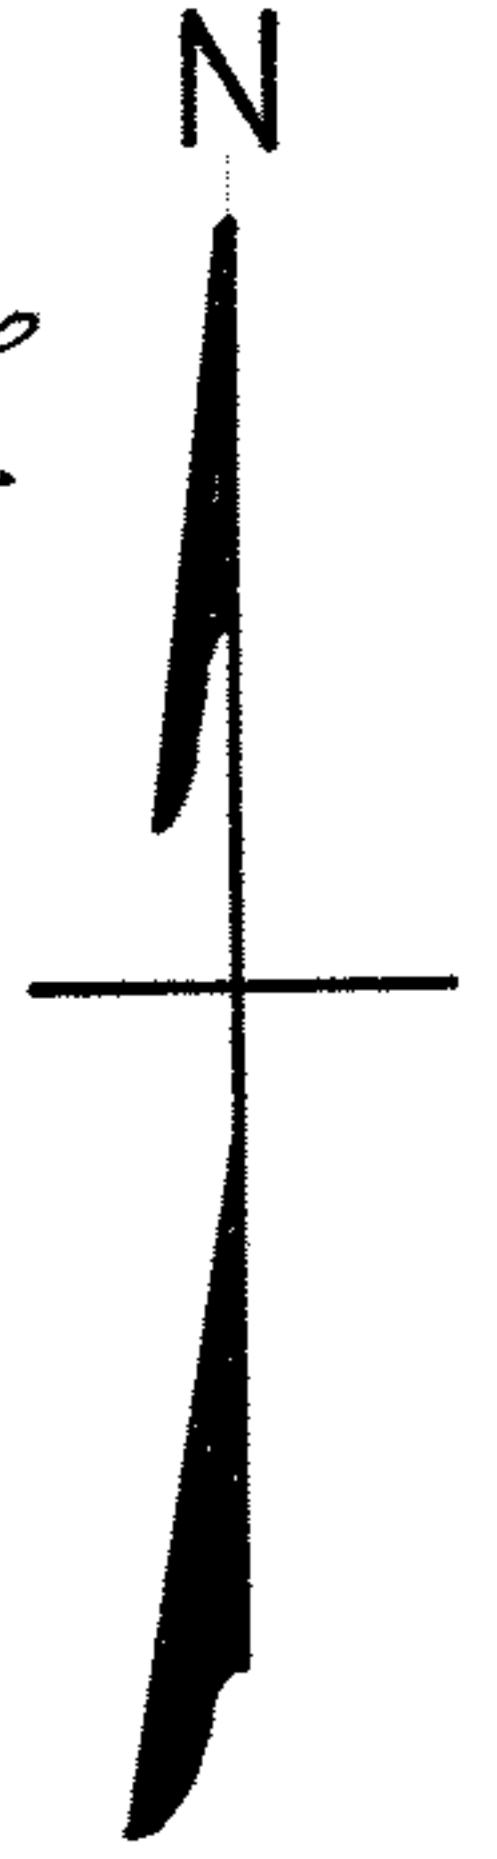

Marcella A. Hassel

D. Vol. 342 Pg. 521

DETAIL SHEET OF PART OF SECTION NO. 26  
 AVON TOWNSHIP AVON CITY  
 LORAIN COUNTY OHIO  
 DETAIL SCALE: 1" = 30' APR. 25-1969 6:15 P.M.  
 Gary E. Penfound REG. SURVEYOR