04-00-030-002.019
04-00-030-A Sch # 45477

MAP OF SUB-LOTS 261 & 262
EAGLE POINT ON THE LAKE VOL. 8 PG. 19
SECTION 30 AVON TWP. — AVON LAKE CITY
LORAIN COUNTY OHIO
SCALE: 1"=30' JANUARY 22-1972 5:30 P.M.
NOTE: There are no encroachments on this property.
Gary E. Penfound Reg. Surveyor No. 4457
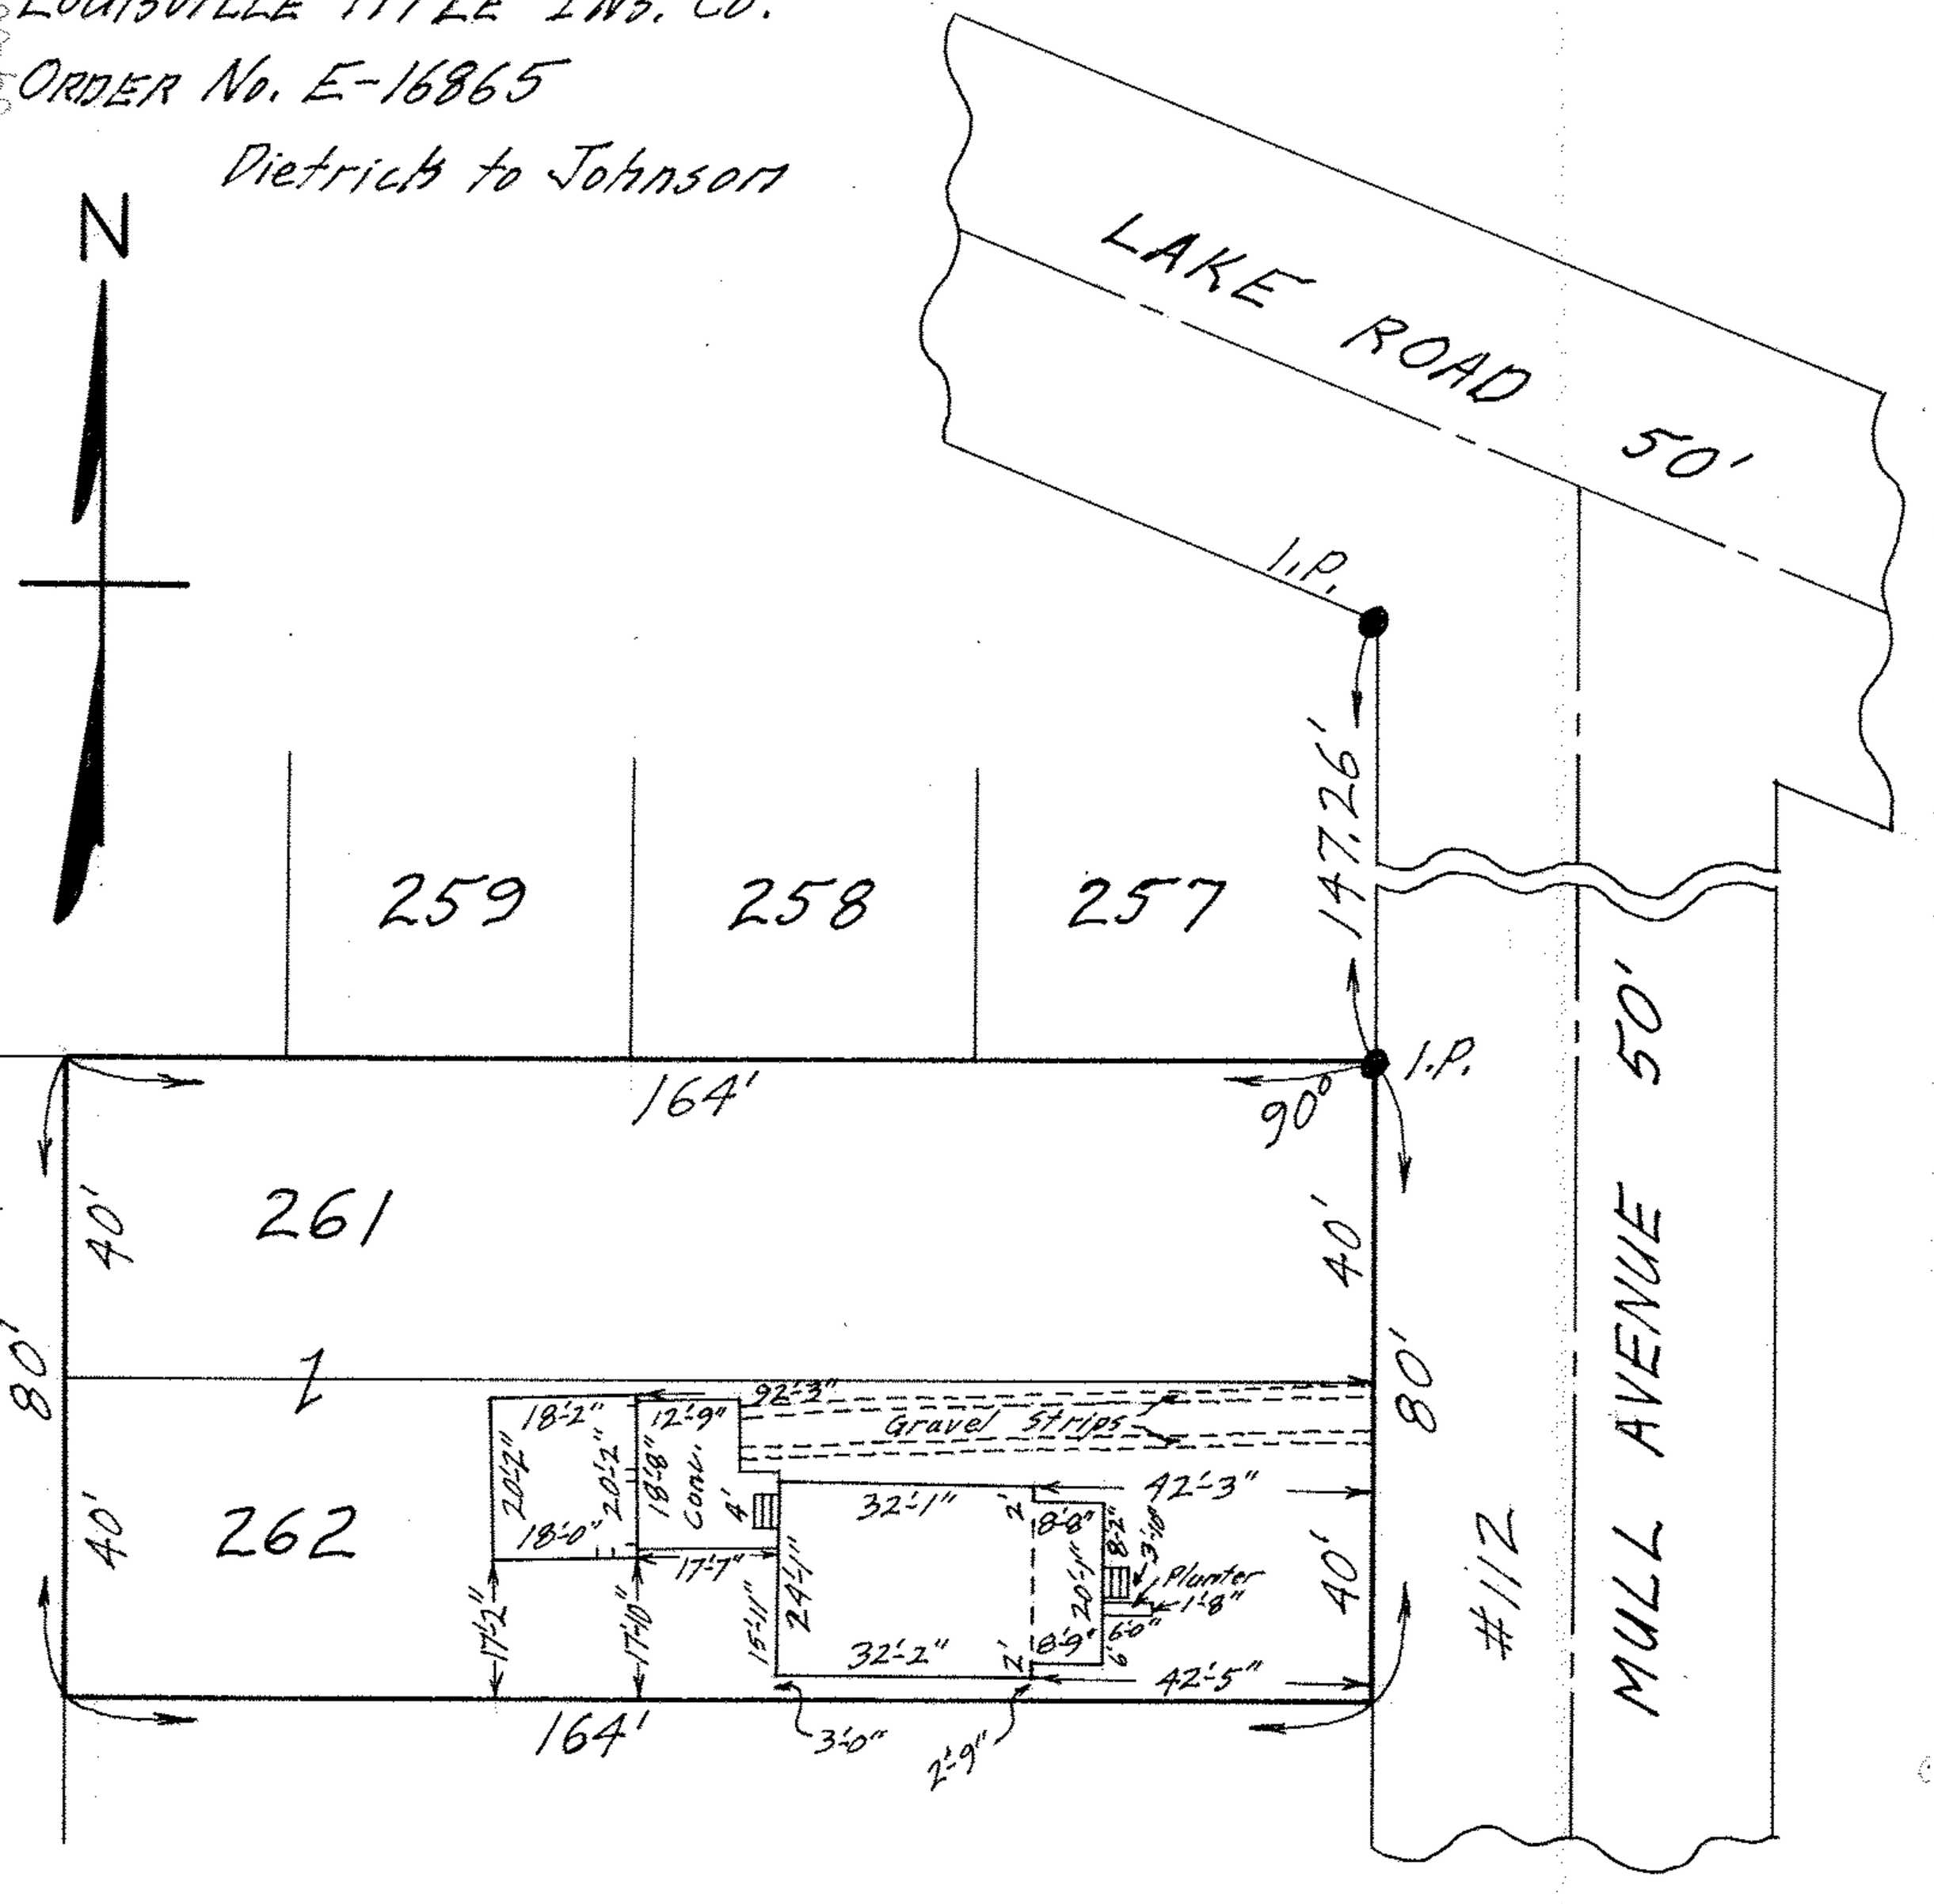
LOUISVILLE TITLE INS. CO.
ORDER No. E-16865
Dietrichs to Johnson