04-00-030-121-024

04-00-030.A

SCAN # 45480

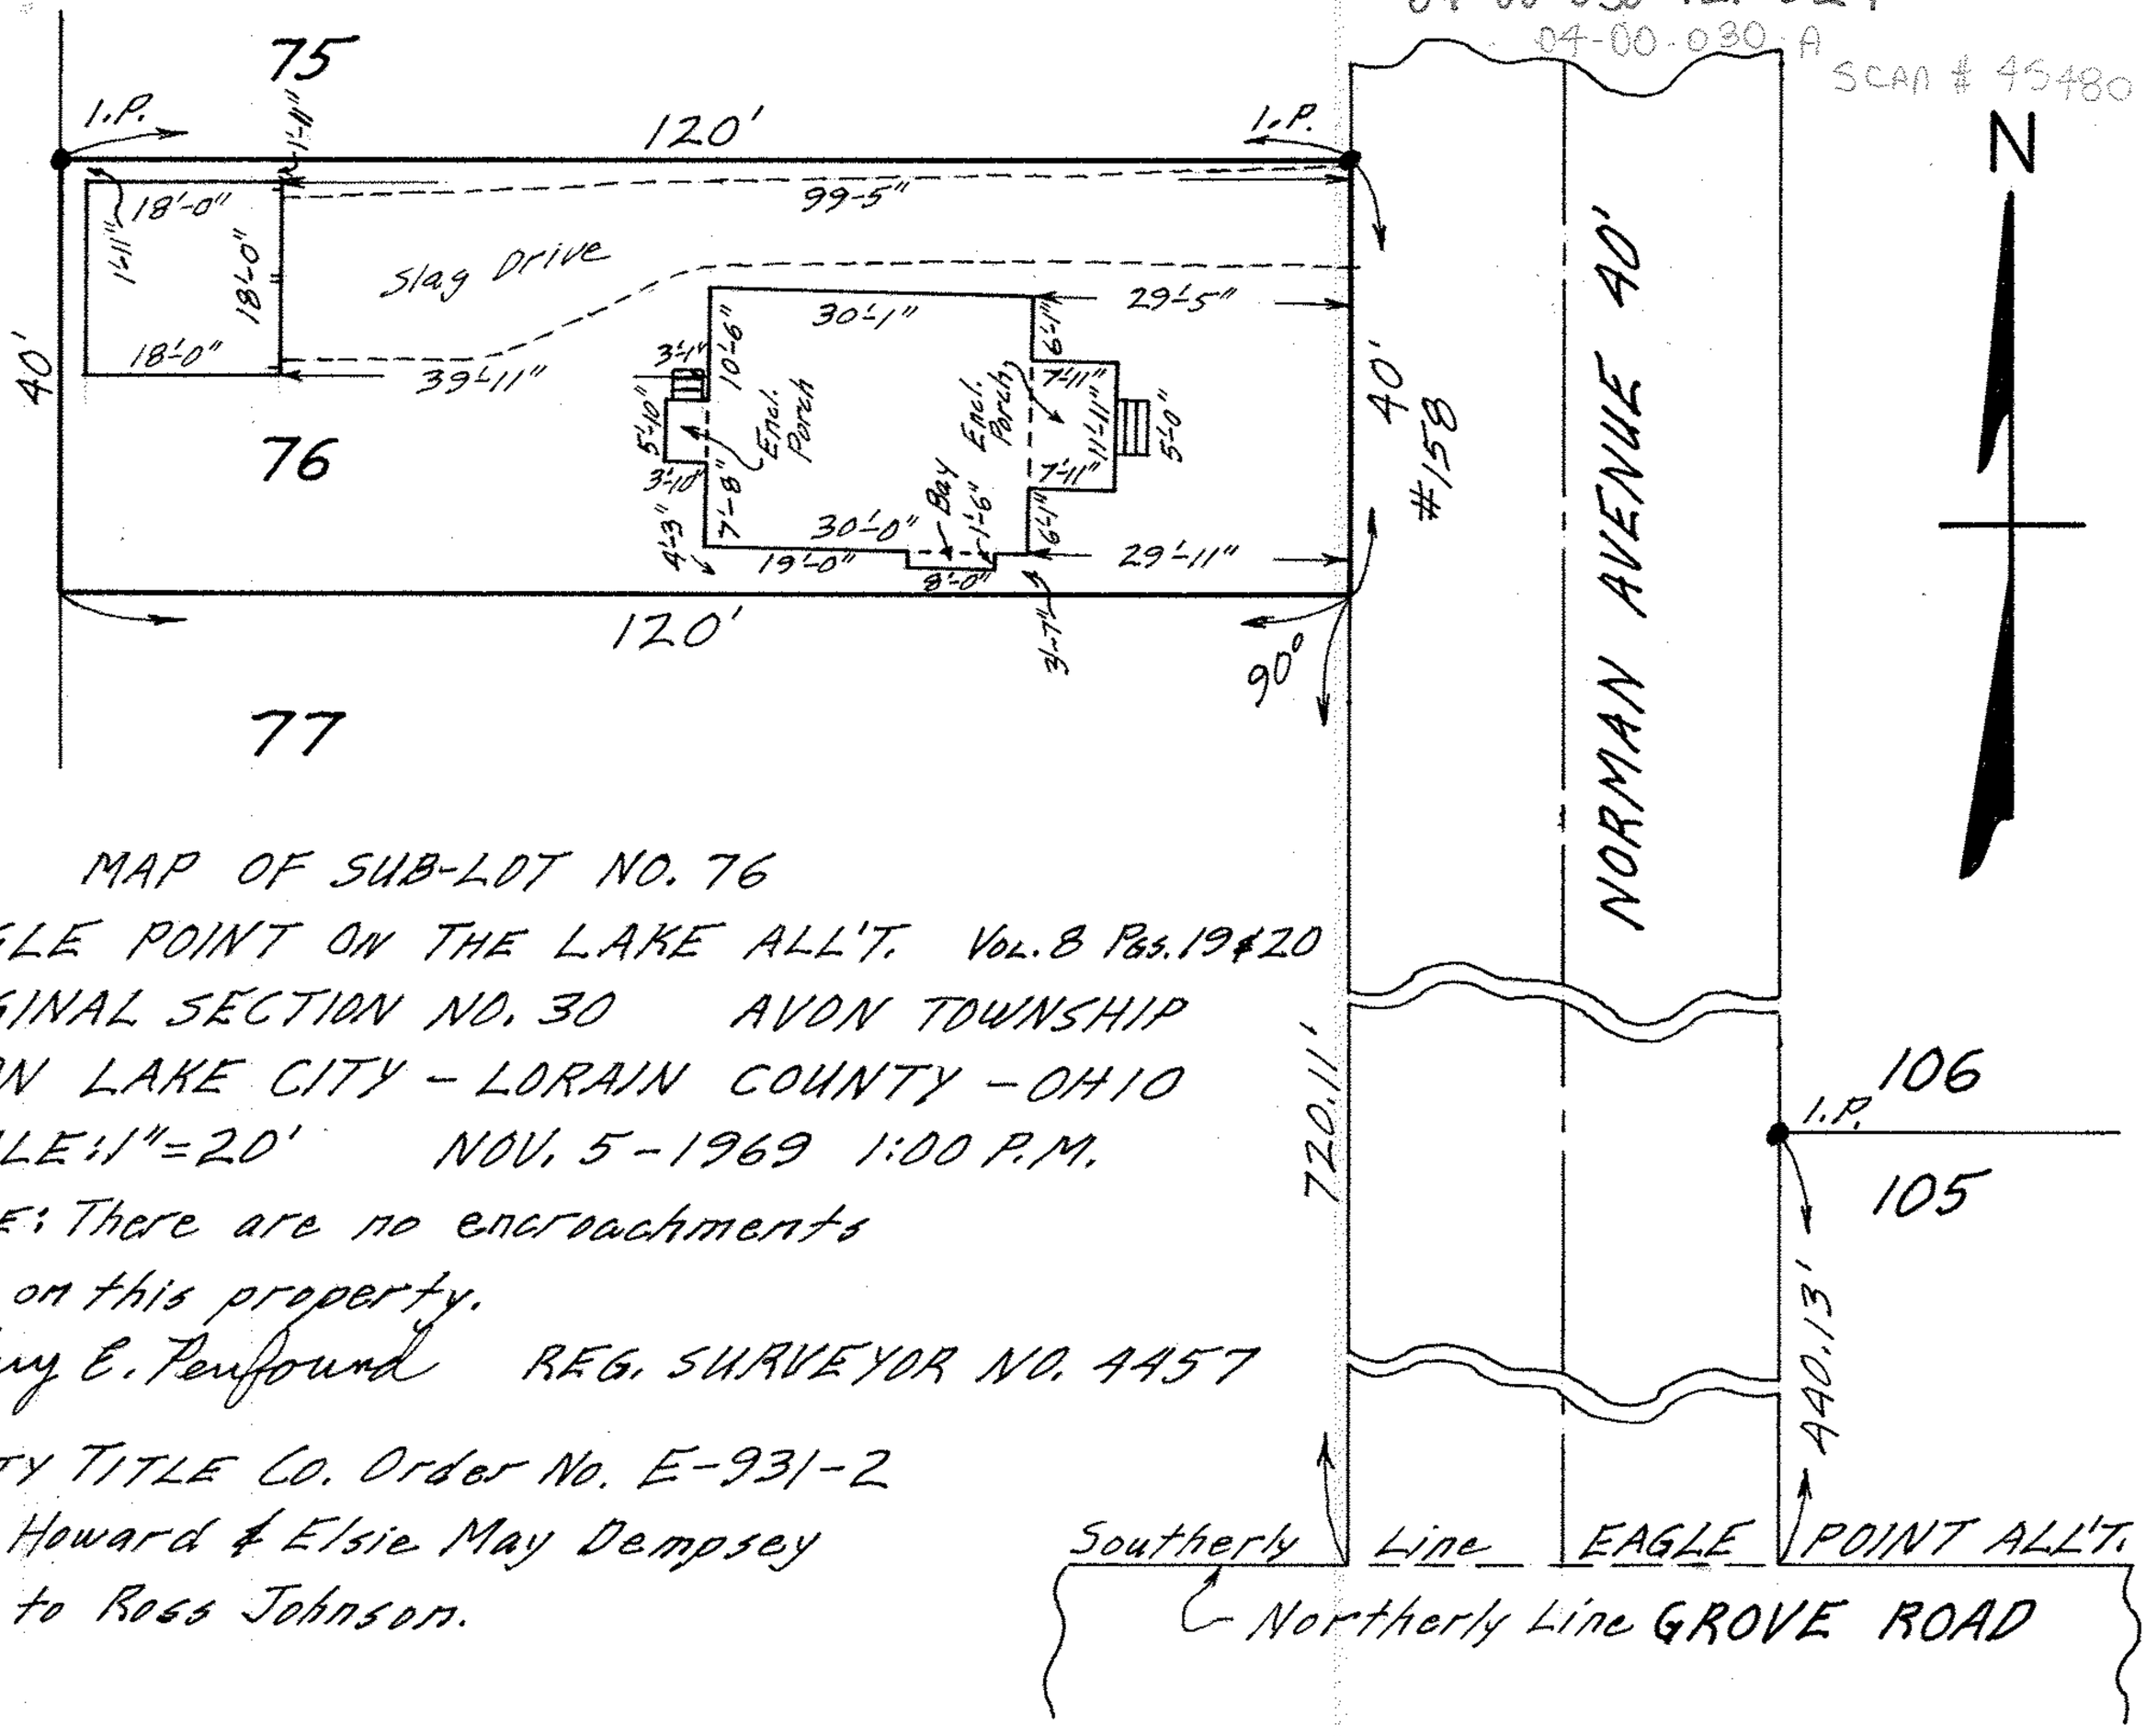

MAP OF SUB-LOT NO. 76

EAGLE POINT ON THE LAKE ALL'T. VOL. 8 PGS. 19 & 20

ORIGINAL SECTION NO. 30 AVON TOWNSHIP

AVON LAKE CITY - LORAIN COUNTY - OHIO

SCALE: 1" = 20' NOV. 5 - 1969 1:00 P.M.

NOTE: There are no encroachments on this property.

Gary E. Penfound REG. SURVEYOR NO. 4457

CITY TITLE CO. Order No. E-931-2

Howard & Elsie May Dempsey to Ross Johnson.