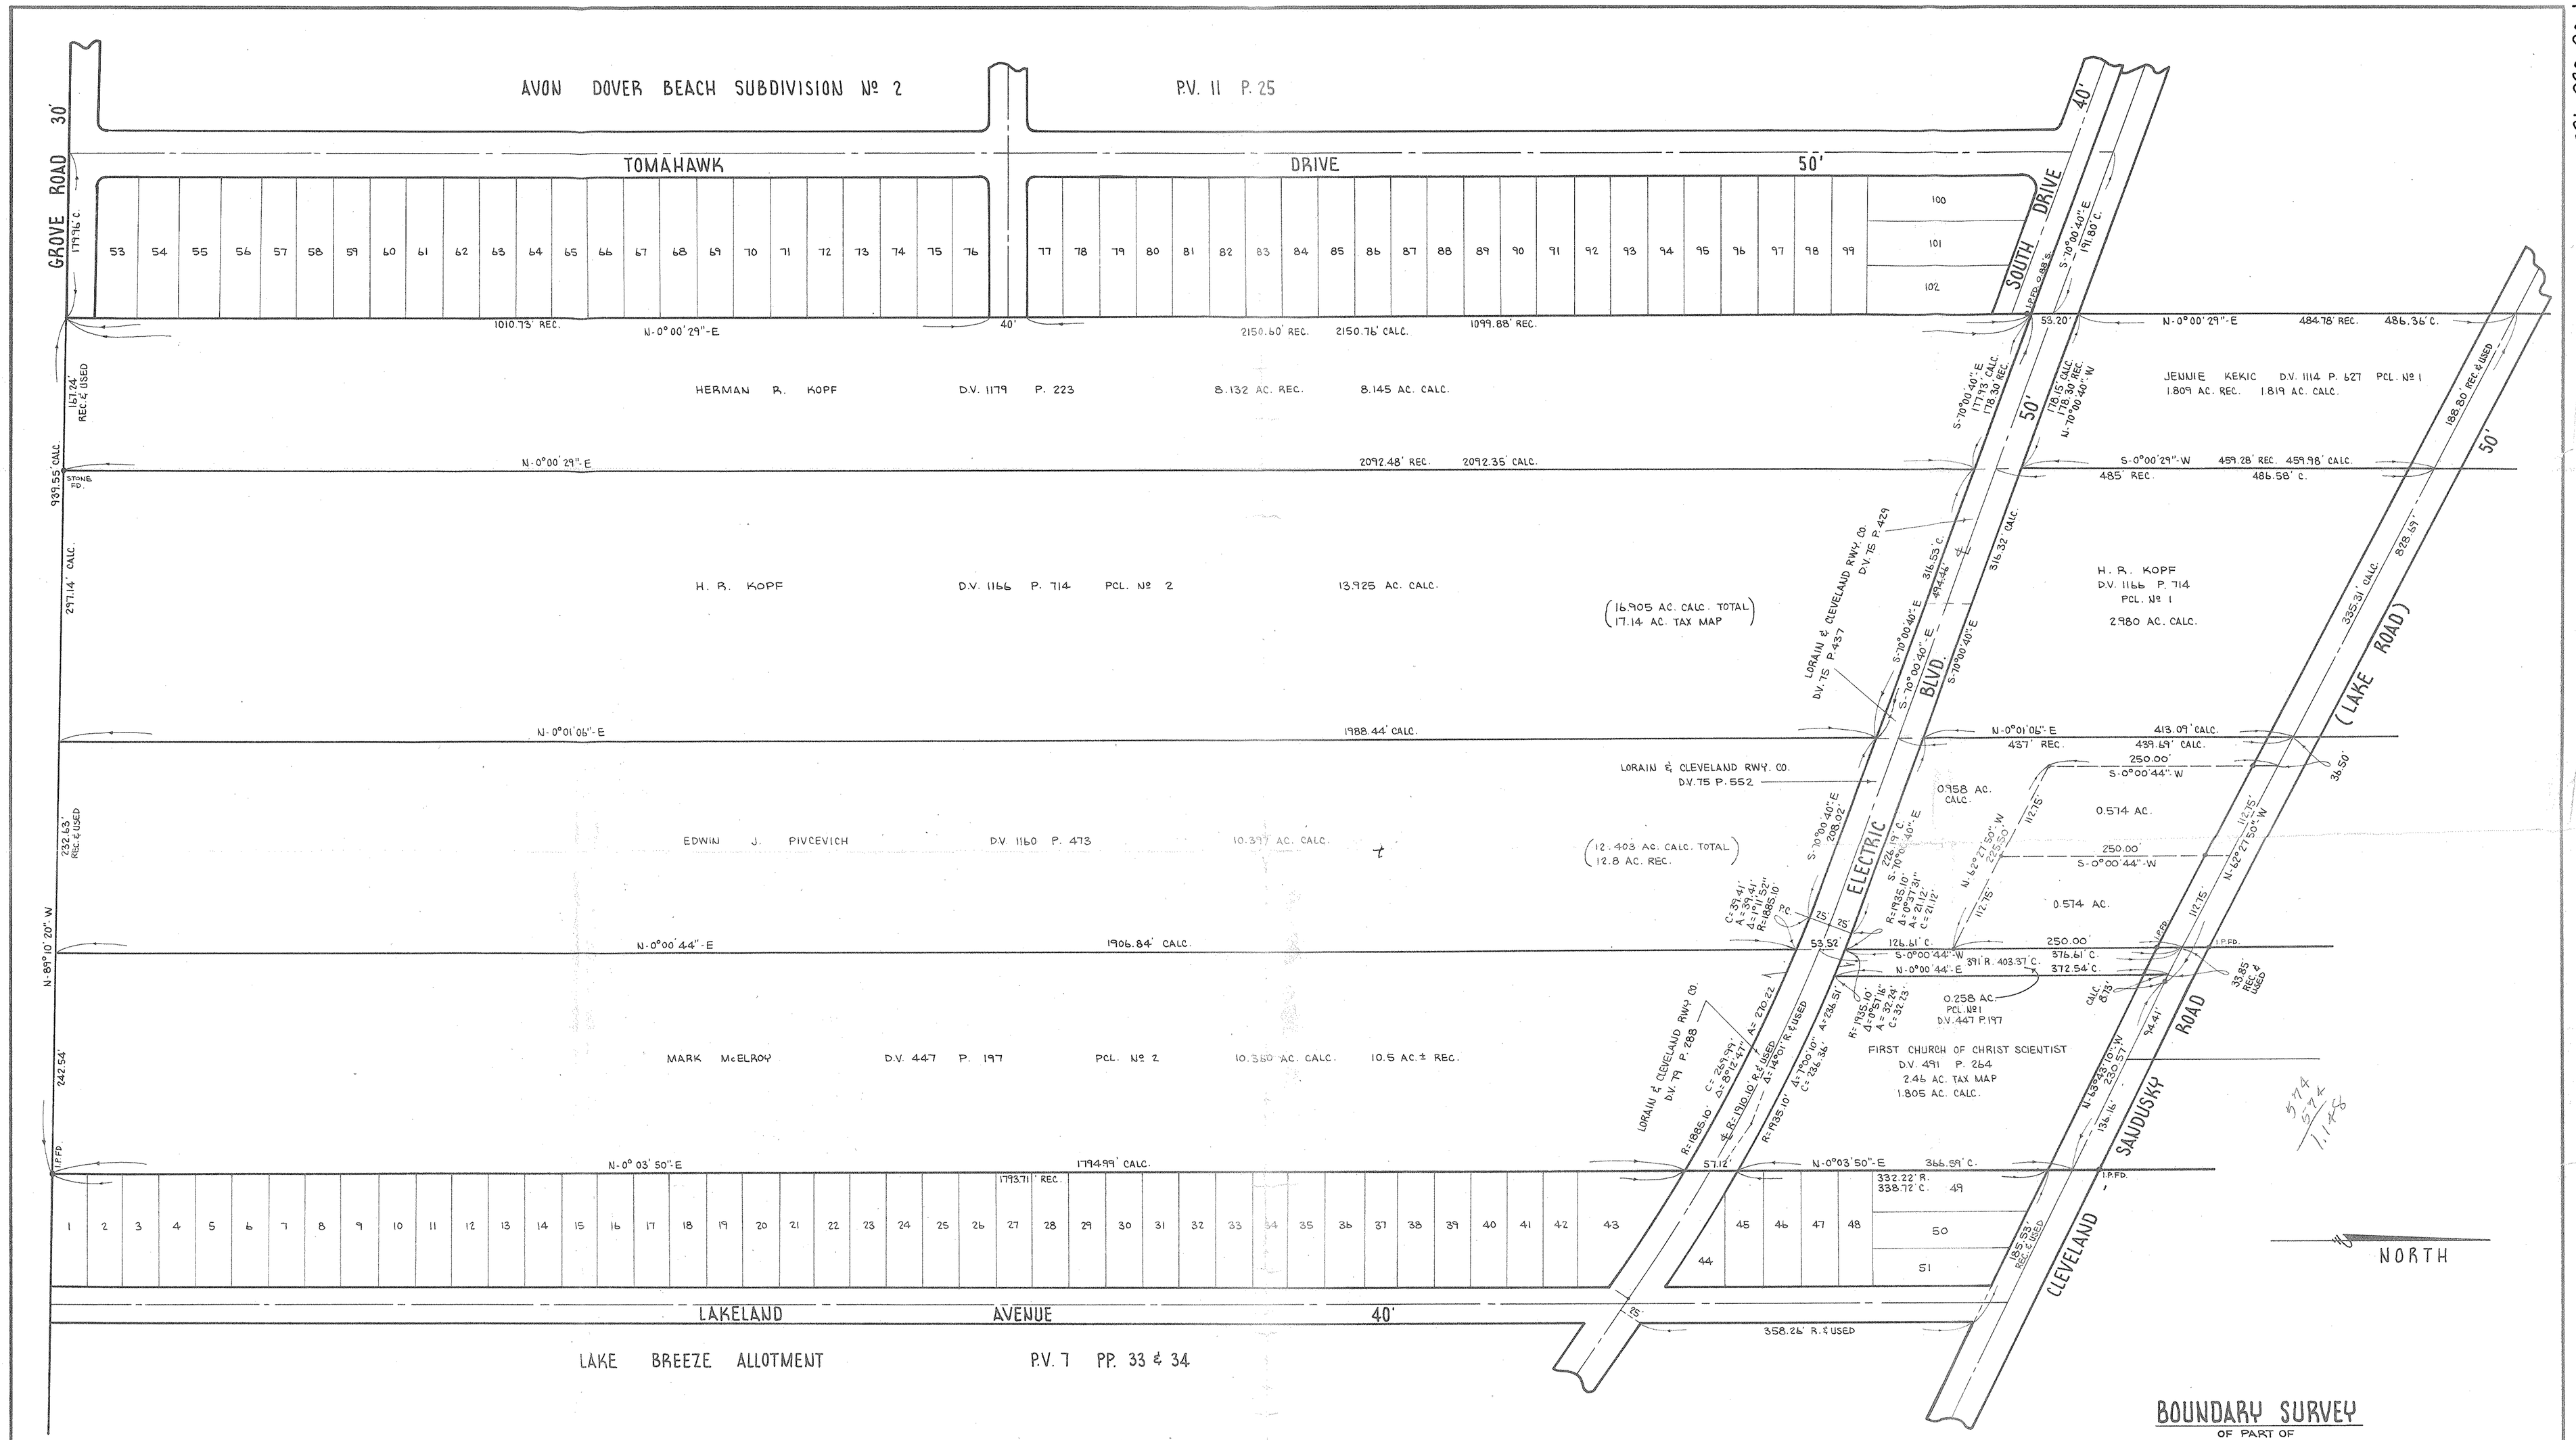

BOUNDARY SURVEY

OF PART OF

AVON TOWNSHIP SECTION Nº 30

CITY OF AVON LAKE COUNTY OF LORAIN

STATE OF OHIO

SCALE: 1" = 80' JAN. 10, 1978

PREPARED BY

KLEINOEDER - SCHMIDT & ASSOCIATES

CONSULTING ENGINEERS & SURVEYORS

APPROVED LORAIN CO. MAP DEPT.
DATE 3-22-78
PAGE 4-00-030-B
BY C.H. Kleinoeder
VOID AFTER 1/1/80

77-267

04-00-030-B