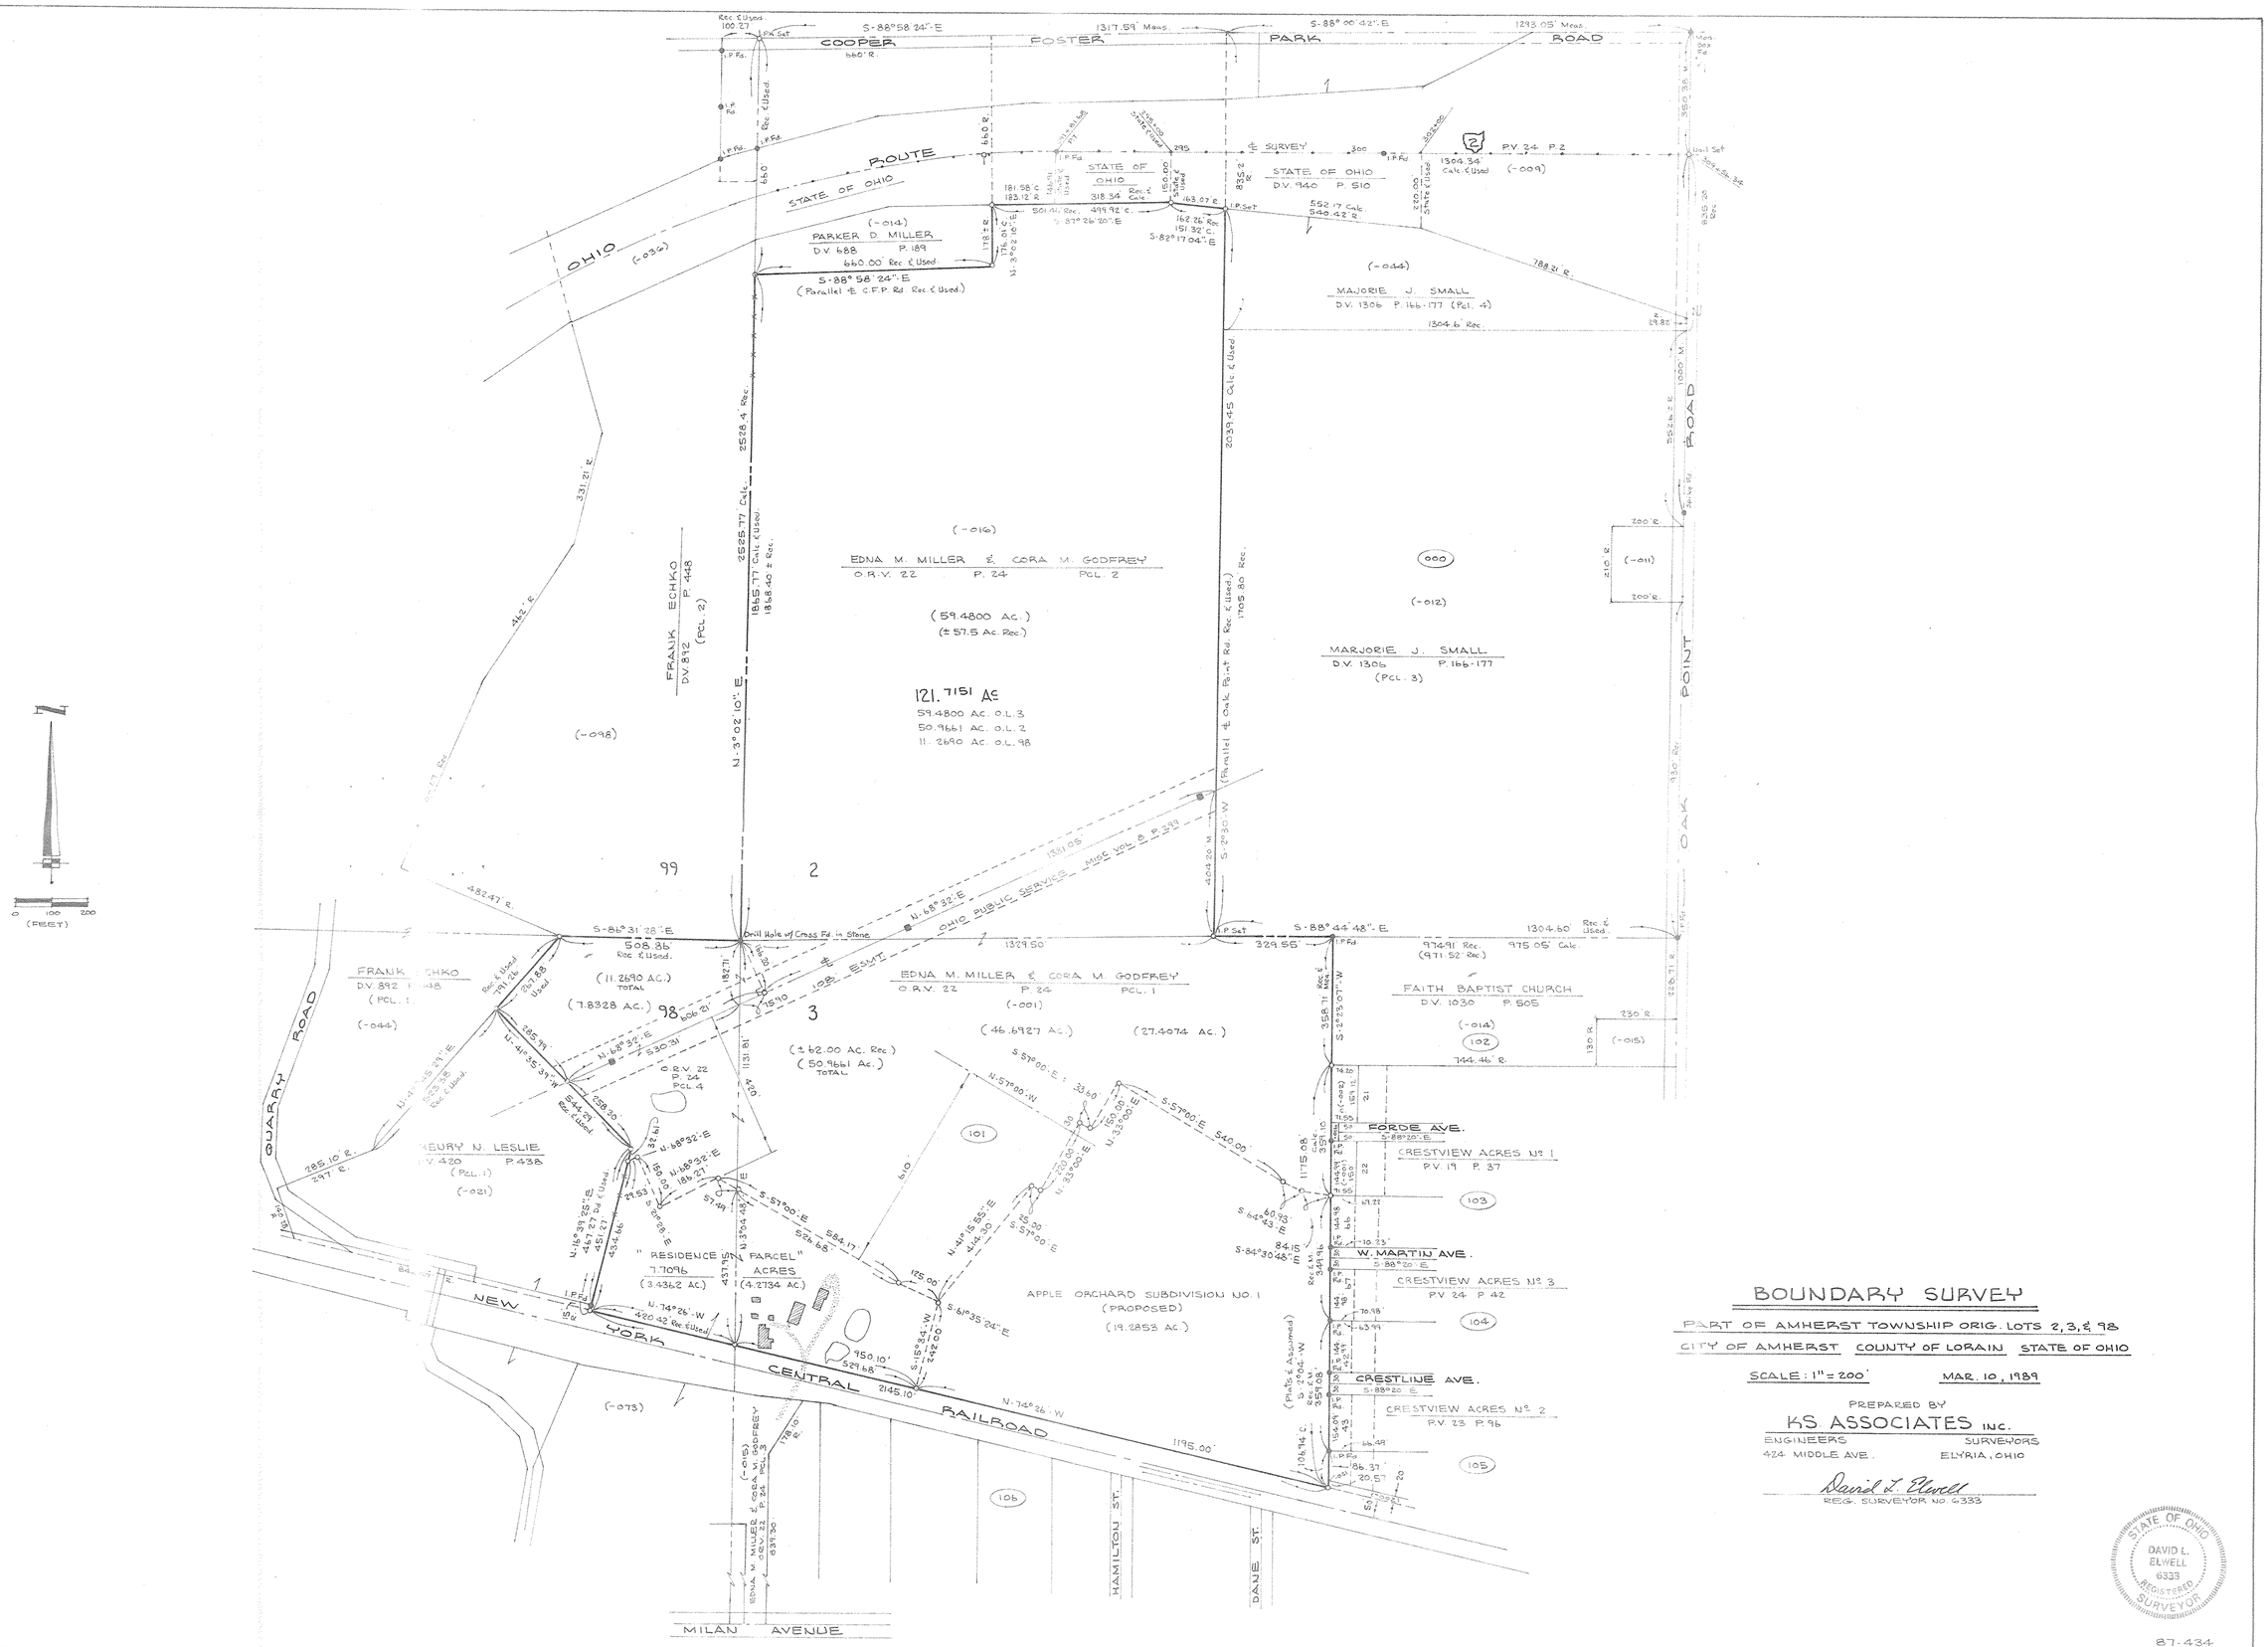

BOUNDARY SURVEY

PART OF AMHERST TOWNSHIP ORIG. LOTS 2, 3, & 98

CITY OF AMHERST COUNTY OF LORAIN STATE OF OHIO

SCALE: 1" = 200' MAR. 10, 1989

PREPARED BY

KS ASSOCIATES INC.

ENGINEERS SURVEYORS

424 MIDDLE AVE. ELYRIA, OHIO

David L. Elwell

REG. SURVEYOR NO. 6333

STATE OF OHIO DAVID L. ELWELL 6333 REGISTERED SURVEYOR

87-434