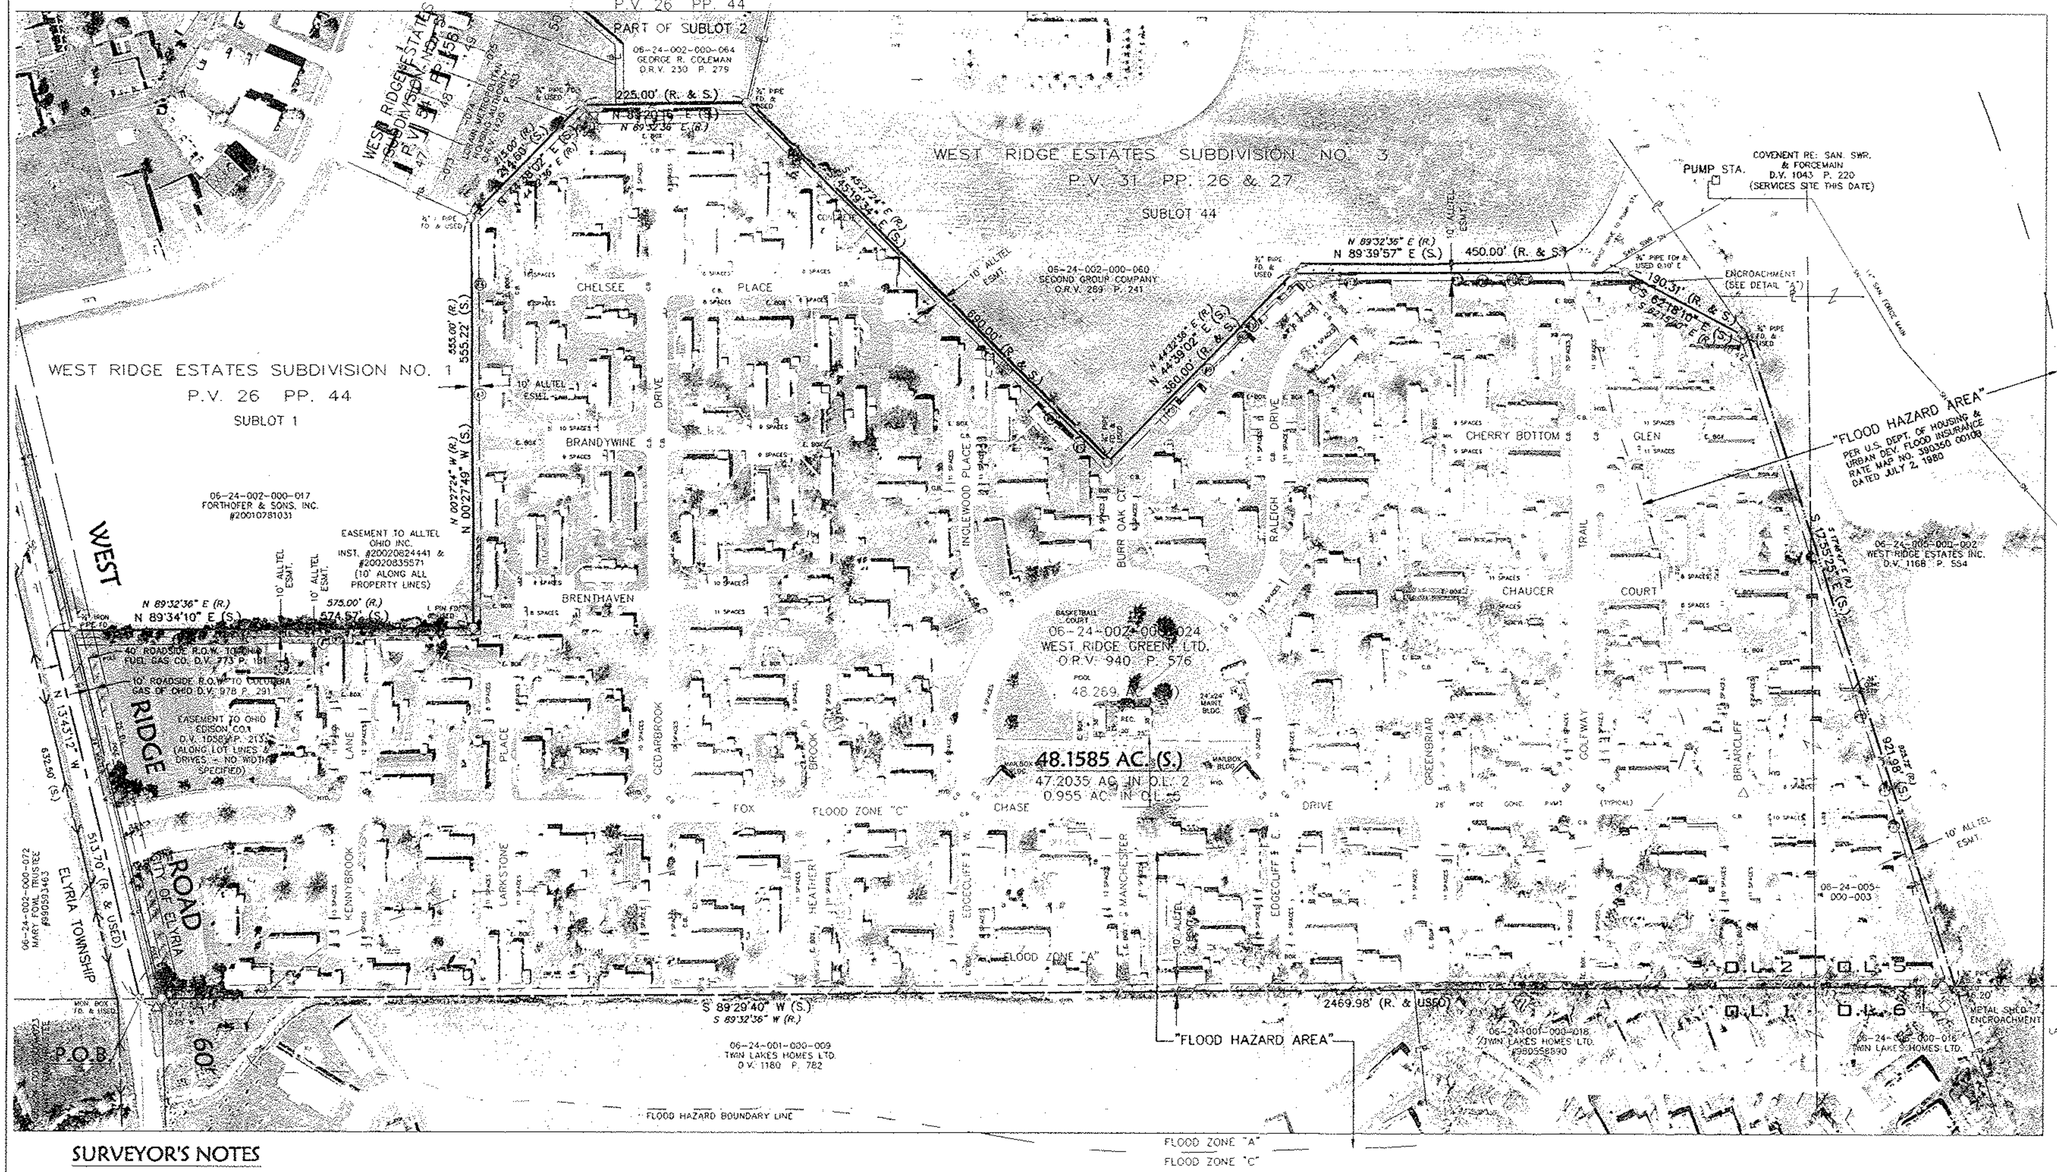

LEGAL DESCRIPTION

Situated in the City of Elyria, County of Lorain, State of Ohio, and being known as part of Original Elyria Township Lot Nos. 2 and 5, West of Black River, and being the same parcel as conveyed to West Ridge Green, Ltd. as recorded in Volume 940, Page 576 of Lorain County Official Records, and more definitely described as follows:

Beginning at an monument found set at the intersection of the centerline of West Ridge Road and the South line of Original Elyria Township Lot No. 5, West of Black River;

Thence North 13°43'12" West, along centerline of West Ridge Road, a distance of 513.70 feet to a point;

Thence North 44°39'02" East, a distance of 360.00 feet to an iron pipe found set;

Thence North 45°19'34" West, a distance of 590.00 feet to an iron pipe found set;

Thence North 89°32'36" East, a distance of 225.00 feet to an iron pipe found set;

Thence North 00°27'24" West, a distance of 555.00 feet to an iron pipe found set;

Thence North 89°39'57" East, a distance of 450.00 feet to an iron pipe found set;

Thence South 62°18'10" East, a distance of 190.31 feet to an iron pipe found set;

Thence South 17°55'25" East, a distance of 921.98 feet to an iron pipe found set;

Thence South 89°29'40" West, a distance of 2469.98 feet to an iron pipe found set;

Thence South 00°27'49" West, a distance of 575.00 feet to an iron pipe found set;

Thence South 89°34'10" West, a distance of 574.57 feet to the place of beginning, containing 48.1585 acres of land, be the same more or less, but subject to all legal highways, as surveyed by KS Associates, Inc., Engineers and Surveyors in May of 2002 and December 5, 2003.

Bearings are based on the centerline of West Ridge Road as being North 13°43'12" West.

Iron pipes found or set are 3/4" I.D. with plastic plug unless otherwise noted.

Enclosing a parcel containing 48.1585 acres of which 47.2035 acres are in Original Elyria Township Lot No. 2, West of Black River and 0.955 acres are in Original Elyria Township Lot No. 5, West of Black River, but subject to all legal highways, as surveyed by KS Associates, Inc., Engineers and Surveyors in May of 2002 and December 5, 2003

ALLTEL EASEMENT ENCROACHMENTS

ITEM 1 - SHED & PAVER EASEMENT
ITEM 2 - UNITS 105 - SHED EASEMENT
ITEM 3 - OVERHANG 1.5' - SHED EASEMENT
ITEM 4 - UNIT 1 & 2 - SHED EASEMENT
ITEM 5 - UNIT 3 & 4 - SHED EASEMENT
ITEM 6 - PORCH 2.5' - SHED EASEMENT
