PLAT OF SURVEY

Situated in the Township of Penfield, County of Lorain and State of Ohio and being part of Original Lot No. 30, Tract No. 2 of said Township

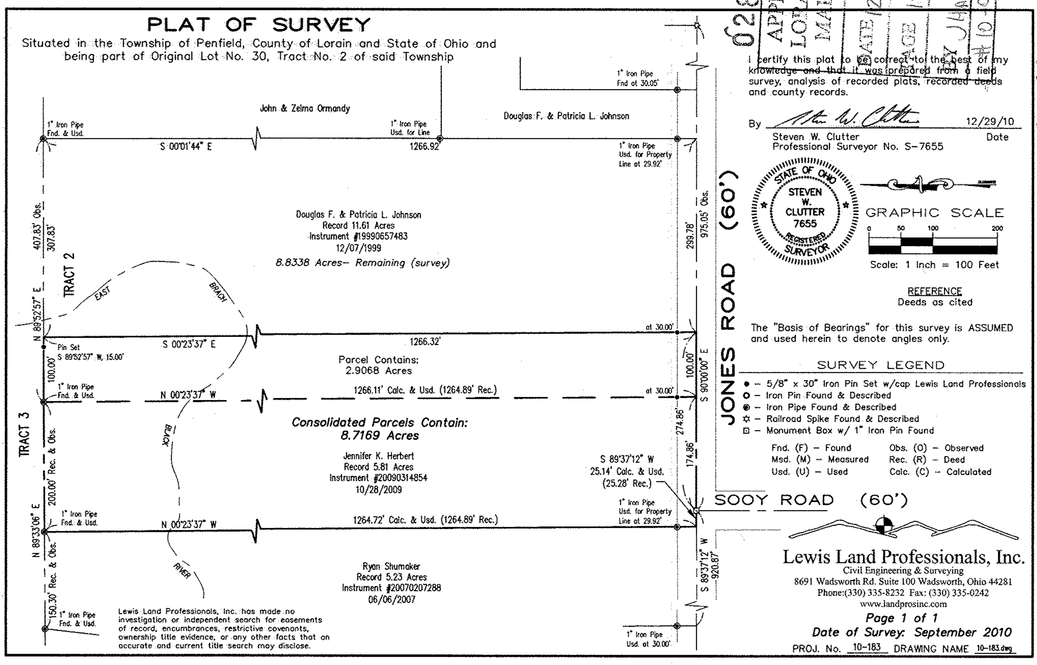

I certify this plat to be correct to the best of my knowledge and that it was prepared from a field survey, analysis of recorded plats, recorded deeds and county records.

By _____ 12/29/10

Steven W. Clutter — Date
Professional Surveyor No. S-7655

STATE OF OHIO · STEVEN W. CLUTTER 7655 · REGISTERED SURVEYOR

GRAPHIC SCALE

0 50 100 200

Scale: 1 Inch = 100 Feet

REFERENCE
Deeds as cited

The "Basis of Bearings" for this survey is ASSUMED and used herein to denote angles only.

SURVEY LEGEND

- ● – 5/8" x 30" Iron Pin Set w/cap Lewis Land Professionals
- ○ – Iron Pin Found & Described
- ◉ – Iron Pipe Found & Described
- ☆ – Railroad Spike Found & Described
- ⊡ – Monument Box w/ 1" Iron Pin Found

Fnd. (F) – Found — Obs. (O) – Observed
Msd. (M) – Measured — Rec. (R) – Deed
Usd. (U) – Used — Calc. (C) – Calculated

Lewis Land Professionals, Inc.
Civil Engineering & Surveying
8691 Wadsworth Rd. Suite 100 Wadsworth, Ohio 44281
Phone:(330) 335-8232 Fax: (330) 335-0242
www.landprosinc.com

Page 1 of 1

Date of Survey: September 2010

PROJ. No. 10-183 DRAWING NAME 10-183.dwg

02886
APPROVED
LORAIN CO.
MAP DEPT
DATE 12-29-10
PAGE 19-G
BY JHatfield
#10-02886
19-02-030-000-057
059
059
See Attached Survey for remainder Acr.

E:\2010\2010 10-19\10-18\10-183\10-183.dwg, 9/28/2010 8:50:10 AM, 1:100