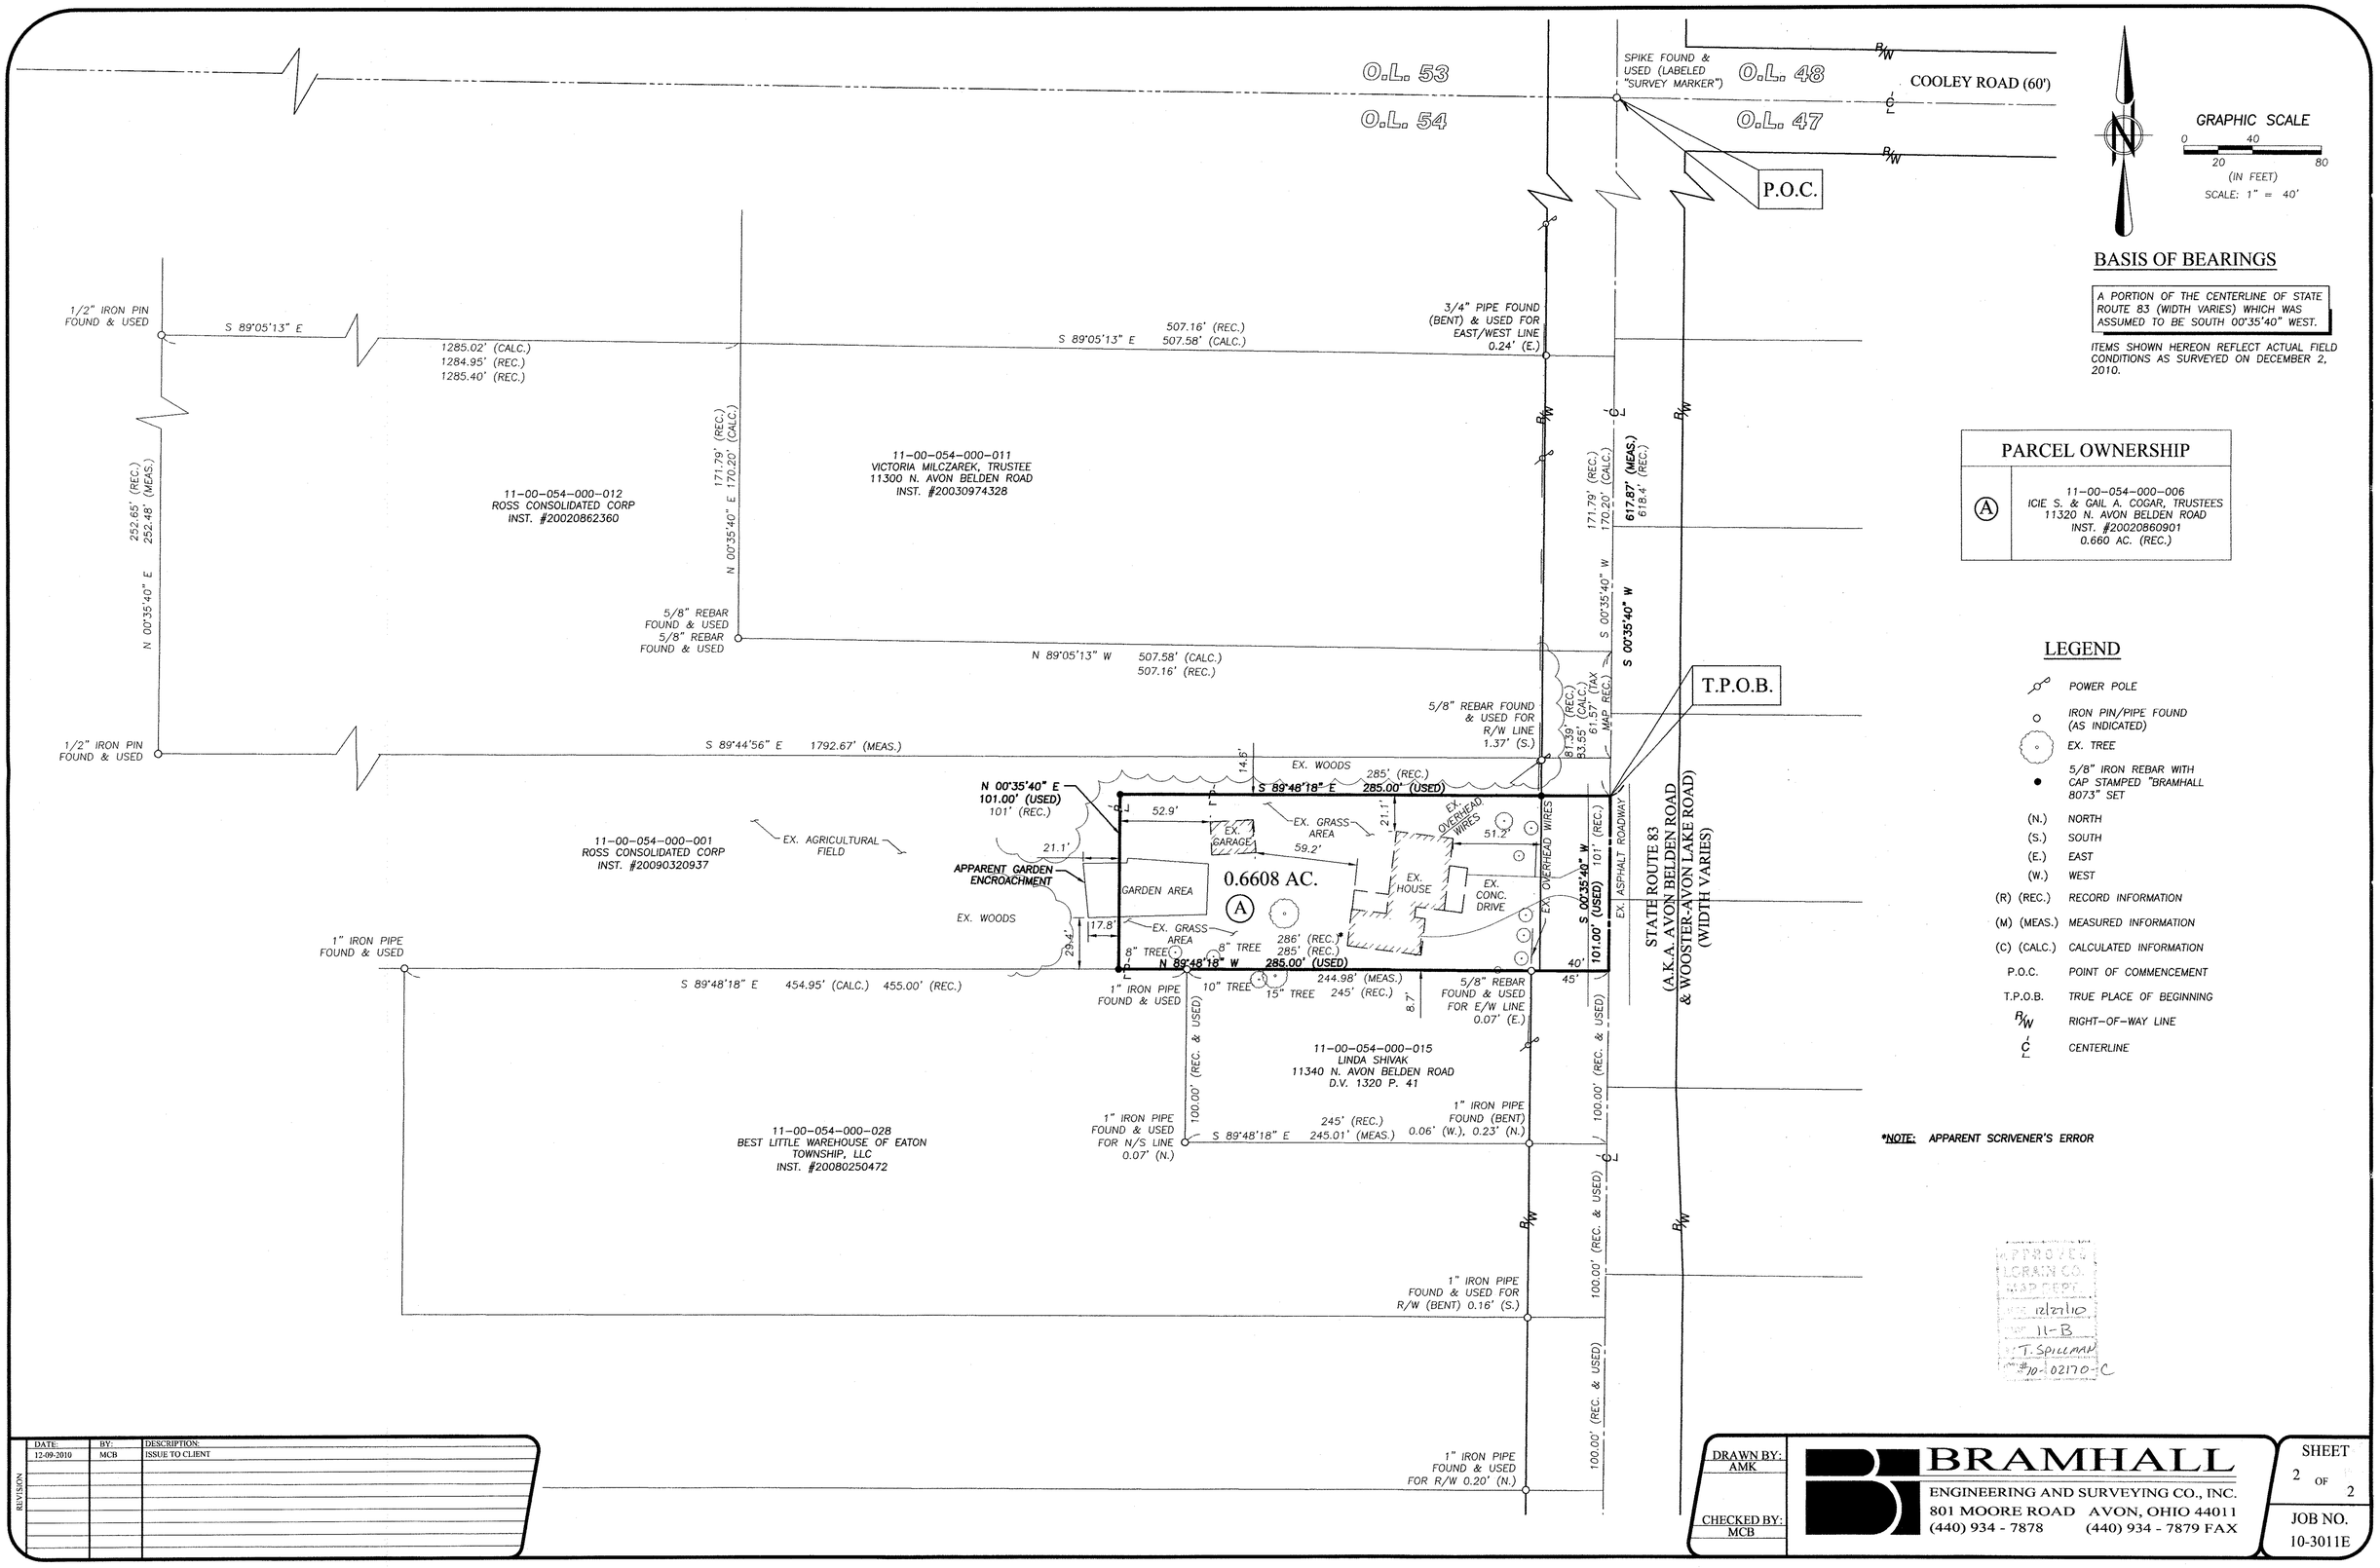

REVISION	DATE:	BY:	DESCRIPTION:
	12-09-2010	MCB	ISSUE TO CLIENT

DRAWN BY: AMK

CHECKED BY: MCB

BRAMHALL
ENGINEERING AND SURVEYING CO., INC.
801 MOORE ROAD AVON, OHIO 44011
(440) 934 - 7878 (440) 934 - 7879 FAX

SHEET 2 OF 2

JOB NO. 10-3011E