PLAT OF SURVEY

FOR

DALE & KATHY BARRIS

SITUATED IN THE CITY OF AMHERST, COUNTY OF LORAIN AND STATE OF OHIO AND KNOWN AS BEING PART OF ORIGINAL AMHERST TOWNSHIP LOTS NO. 19 AND 22.

THE PURPOSE OF THIS SURVEY IS TO CORRECT AND REVISE THE EXISTING LEGAL DESCRIPTIONS OF THE FOUR PARCELS LISTED BELOW

PARCEL NUMBER	CURRENT OWNER	OR VOL. / PAGE
5-00-019-000-055	DALE & KATHY BARRIS	1285 / 125
5-00-019-000-056	DALE & KATHY BARRIS	1285 / 127
5-00-019-000-057	DALE & KATHY BARRIS	1285 / 129
5-00-019-000-058	DALE & KATHY BARRIS	1236 / 679

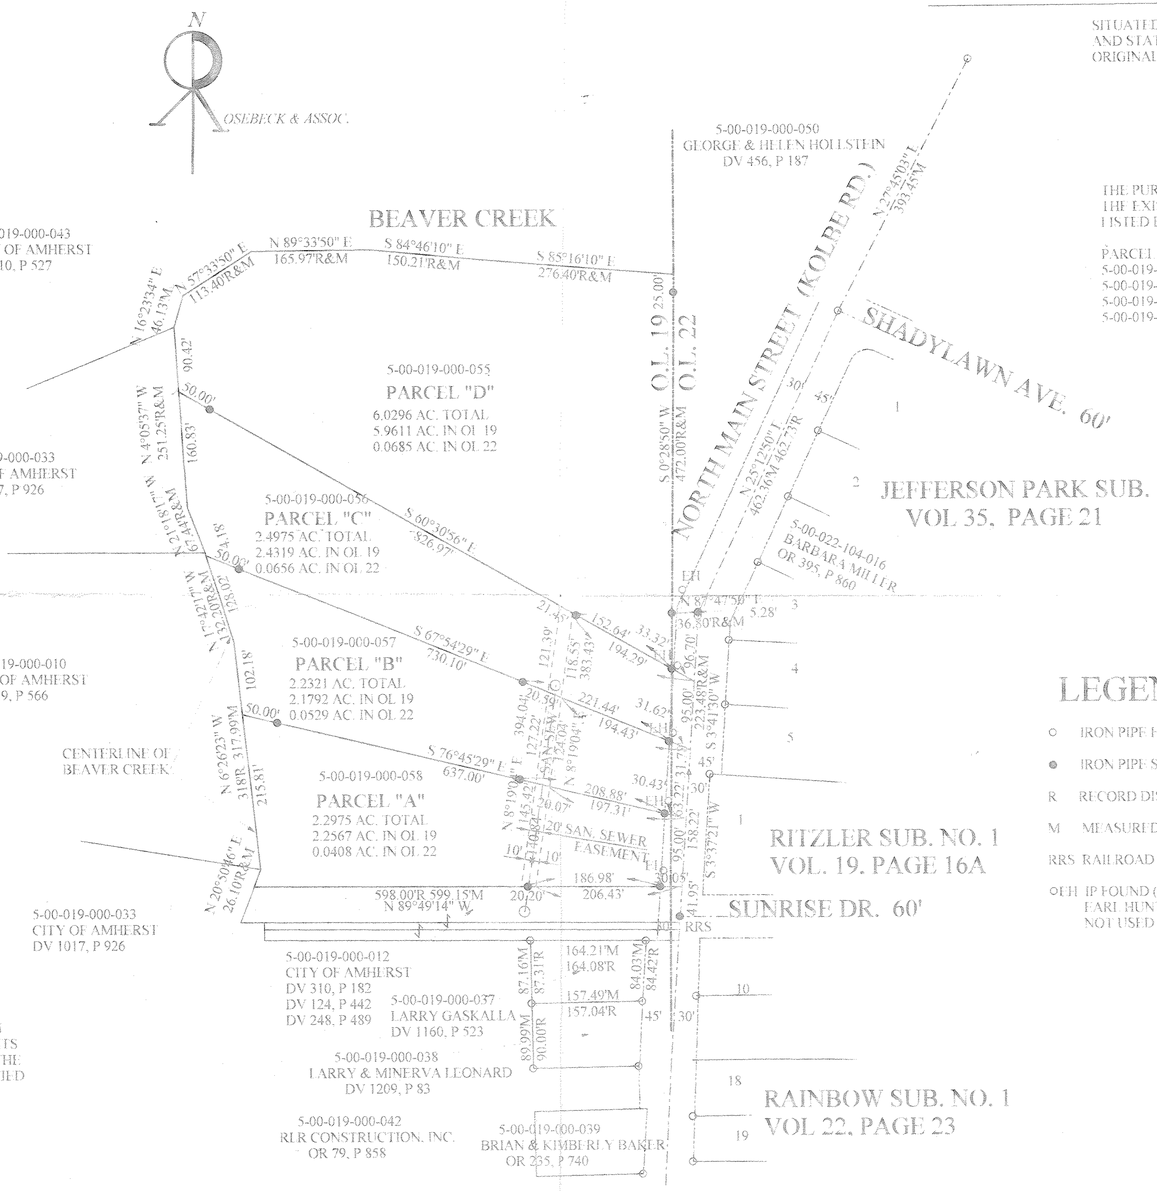

LEGEND

- ○ IRON PIPE FOUND
- ● IRON PIPE SET
- R RECORD DISTANCE
- M MEASURED DISTANCE
- RRS RAILROAD SPIKE
- OFH IP FOUND (SET BY FARL HUNTER) BUT NOT USED

THIS IS TO CERTIFY THAT ALL DISTANCES ARE IN FEET AND DECIMAL PARTS THEREOF. BEARINGS ARE BASED ON AN ASSUMED MERIDIAN AND ARE GIVEN TO DESCRIBE ANGLES ONLY. MONUMENTS WERE FOUND OR SET AT ALL POINTS AS INDICATED IN THE LEGEND, ALL OF WHICH I CERTIFY TO BE CORRECT TO THE BEST OF MY PROFESSIONAL KNOWLEDGE, INFORMATION AND BELIEF. CERTIFIED COPIES ARE ONLY THOSE COPIES SIGNED IN RED INK.

RICHARD ROSEBECK SURVEYOR NO. 7400

STATE OF OHIO
RICHARD A. ROSEBECK
7400
REGISTERED
PROFESSIONAL SURVEYOR

22059

APPROVED
LORAIN CO.
MAP DEPT.
DATE 1-15-97
PAGE 5-00-019B
BY R. BELL
ORDER # 22059

PREPARED BY RICHARD ROSEBECK PE, PS
4511 OAKHILL BLVD.
LORAIN, OHIO 44053
(216) 282-3872

PREPARED FOR DALE & KATHY BARRIS
1423 COOPER FOSTER PARK RD.
AMHERST, OHIO 44001

SCALE 1" = 100'
DATE DECEMBER 1996

SHEET NO. 1 OF 1