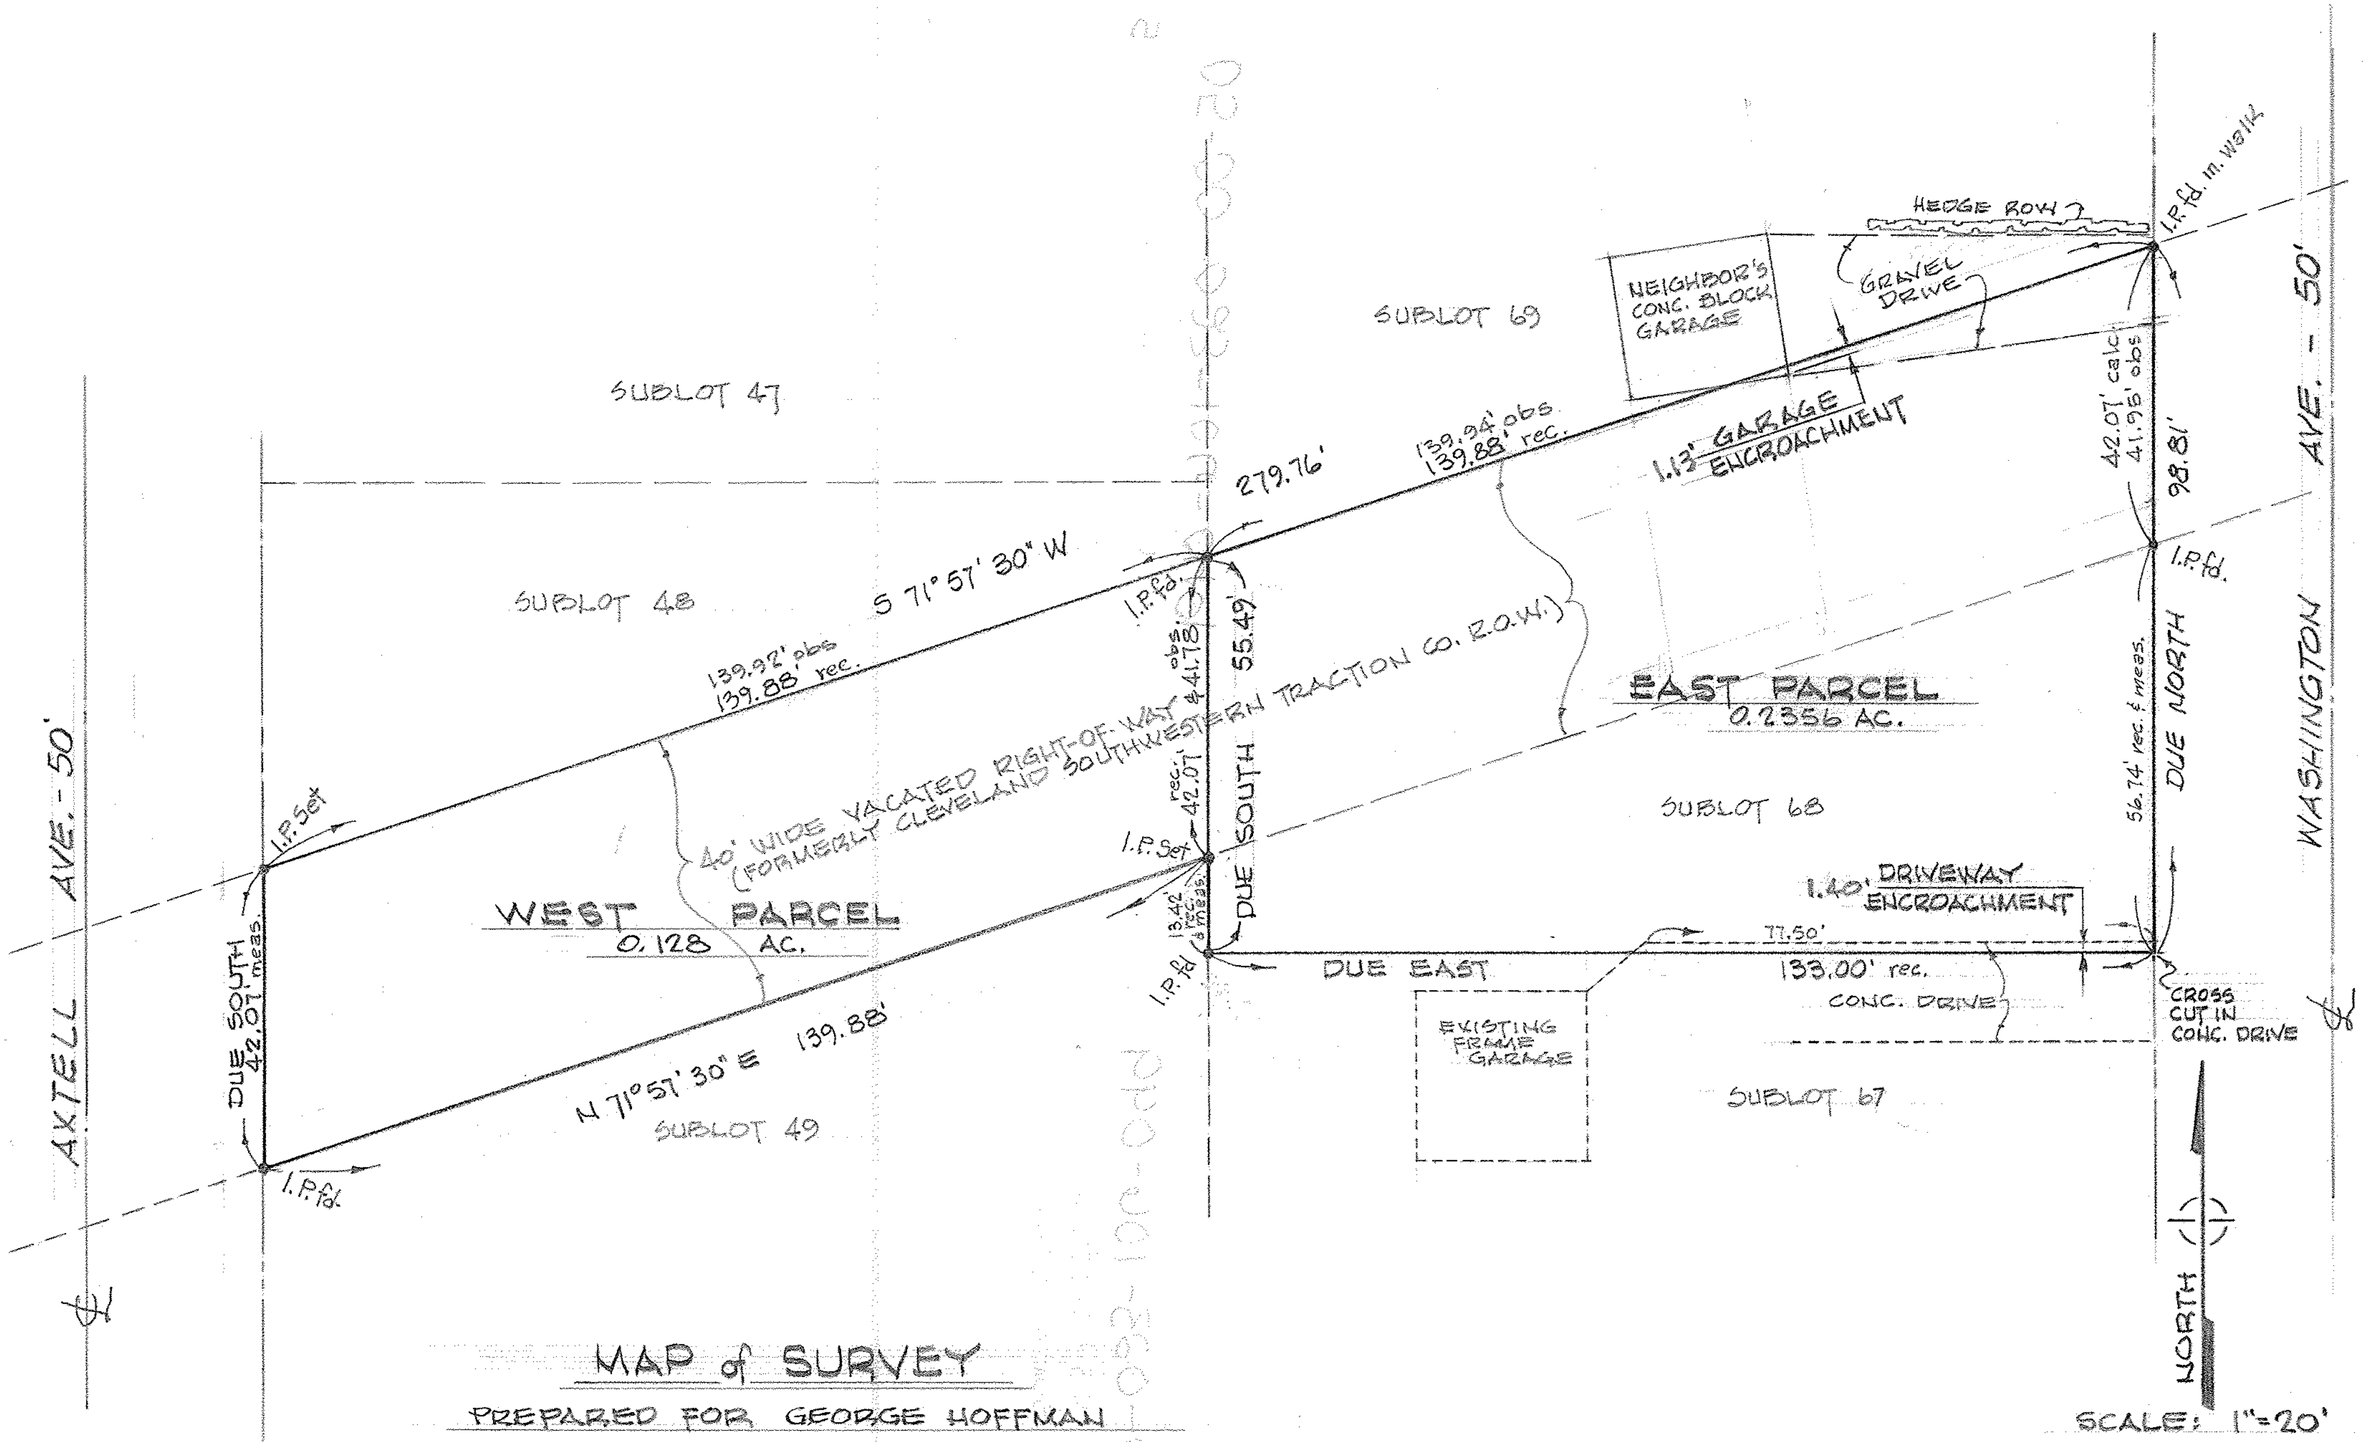

MAP of SURVEY

PREPARED FOR GEORGE HOFFMAN

PART of AXTELL HOMESTEAD ADDITION - PLAT VOL. 7, PG. 9 &
PART of ORIGINAL AMHERST TOWNSHIP LOT No. 23
CITY of AMHERST, LORAIN COUNTY, OHIO

McGLINCHY and ASSOCIATES INC.
PROFESSIONAL ENGINEER and SURVEYORS
ELYRIA OHIO
APRIL, 1979 #795103