05-00-024.118-006

05-00-024-B

Scan # 45548

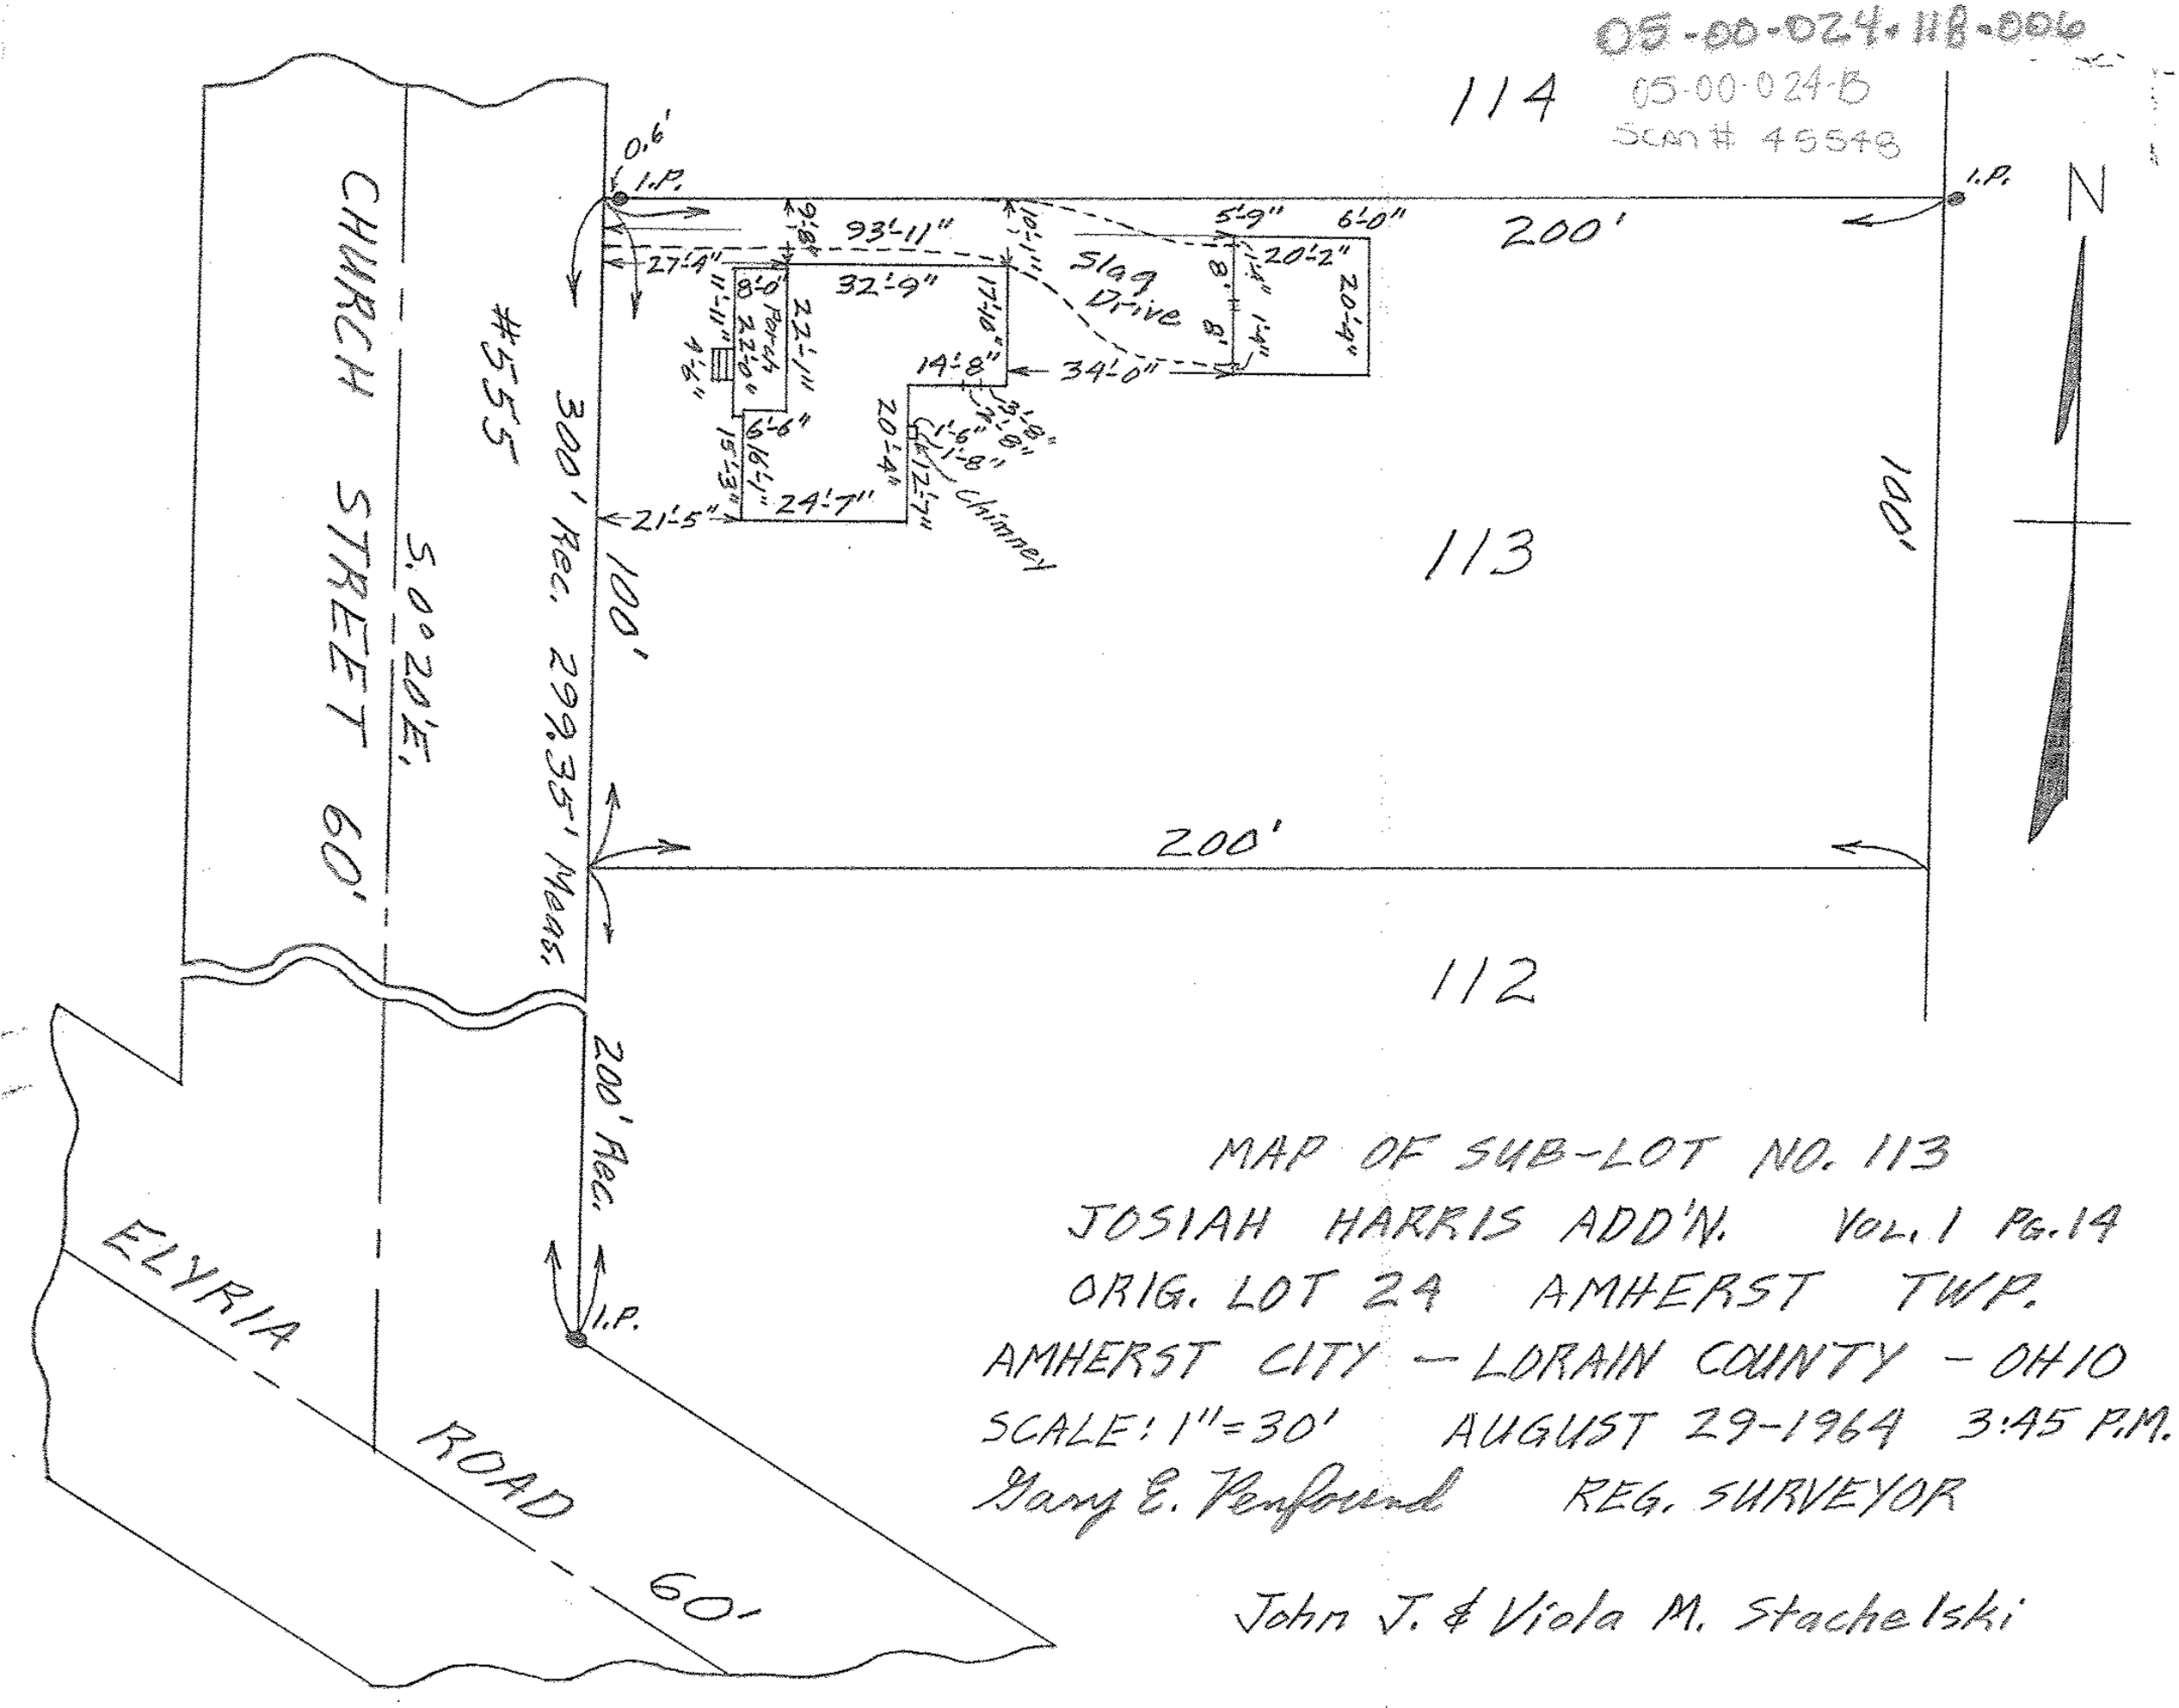

MAP OF SUB-LOT NO. 113
JOSIAH HARRIS ADD'N. VOL. 1 PG. 14
ORIG. LOT 24 AMHERST TWP.
AMHERST CITY — LORAIN COUNTY — OHIO
SCALE: 1" = 30' AUGUST 29-1964 3:45 P.M.
Gary E. Penfound REG. SURVEYOR

John J. & Viola M. Stachelski