FILM NO 1438

77

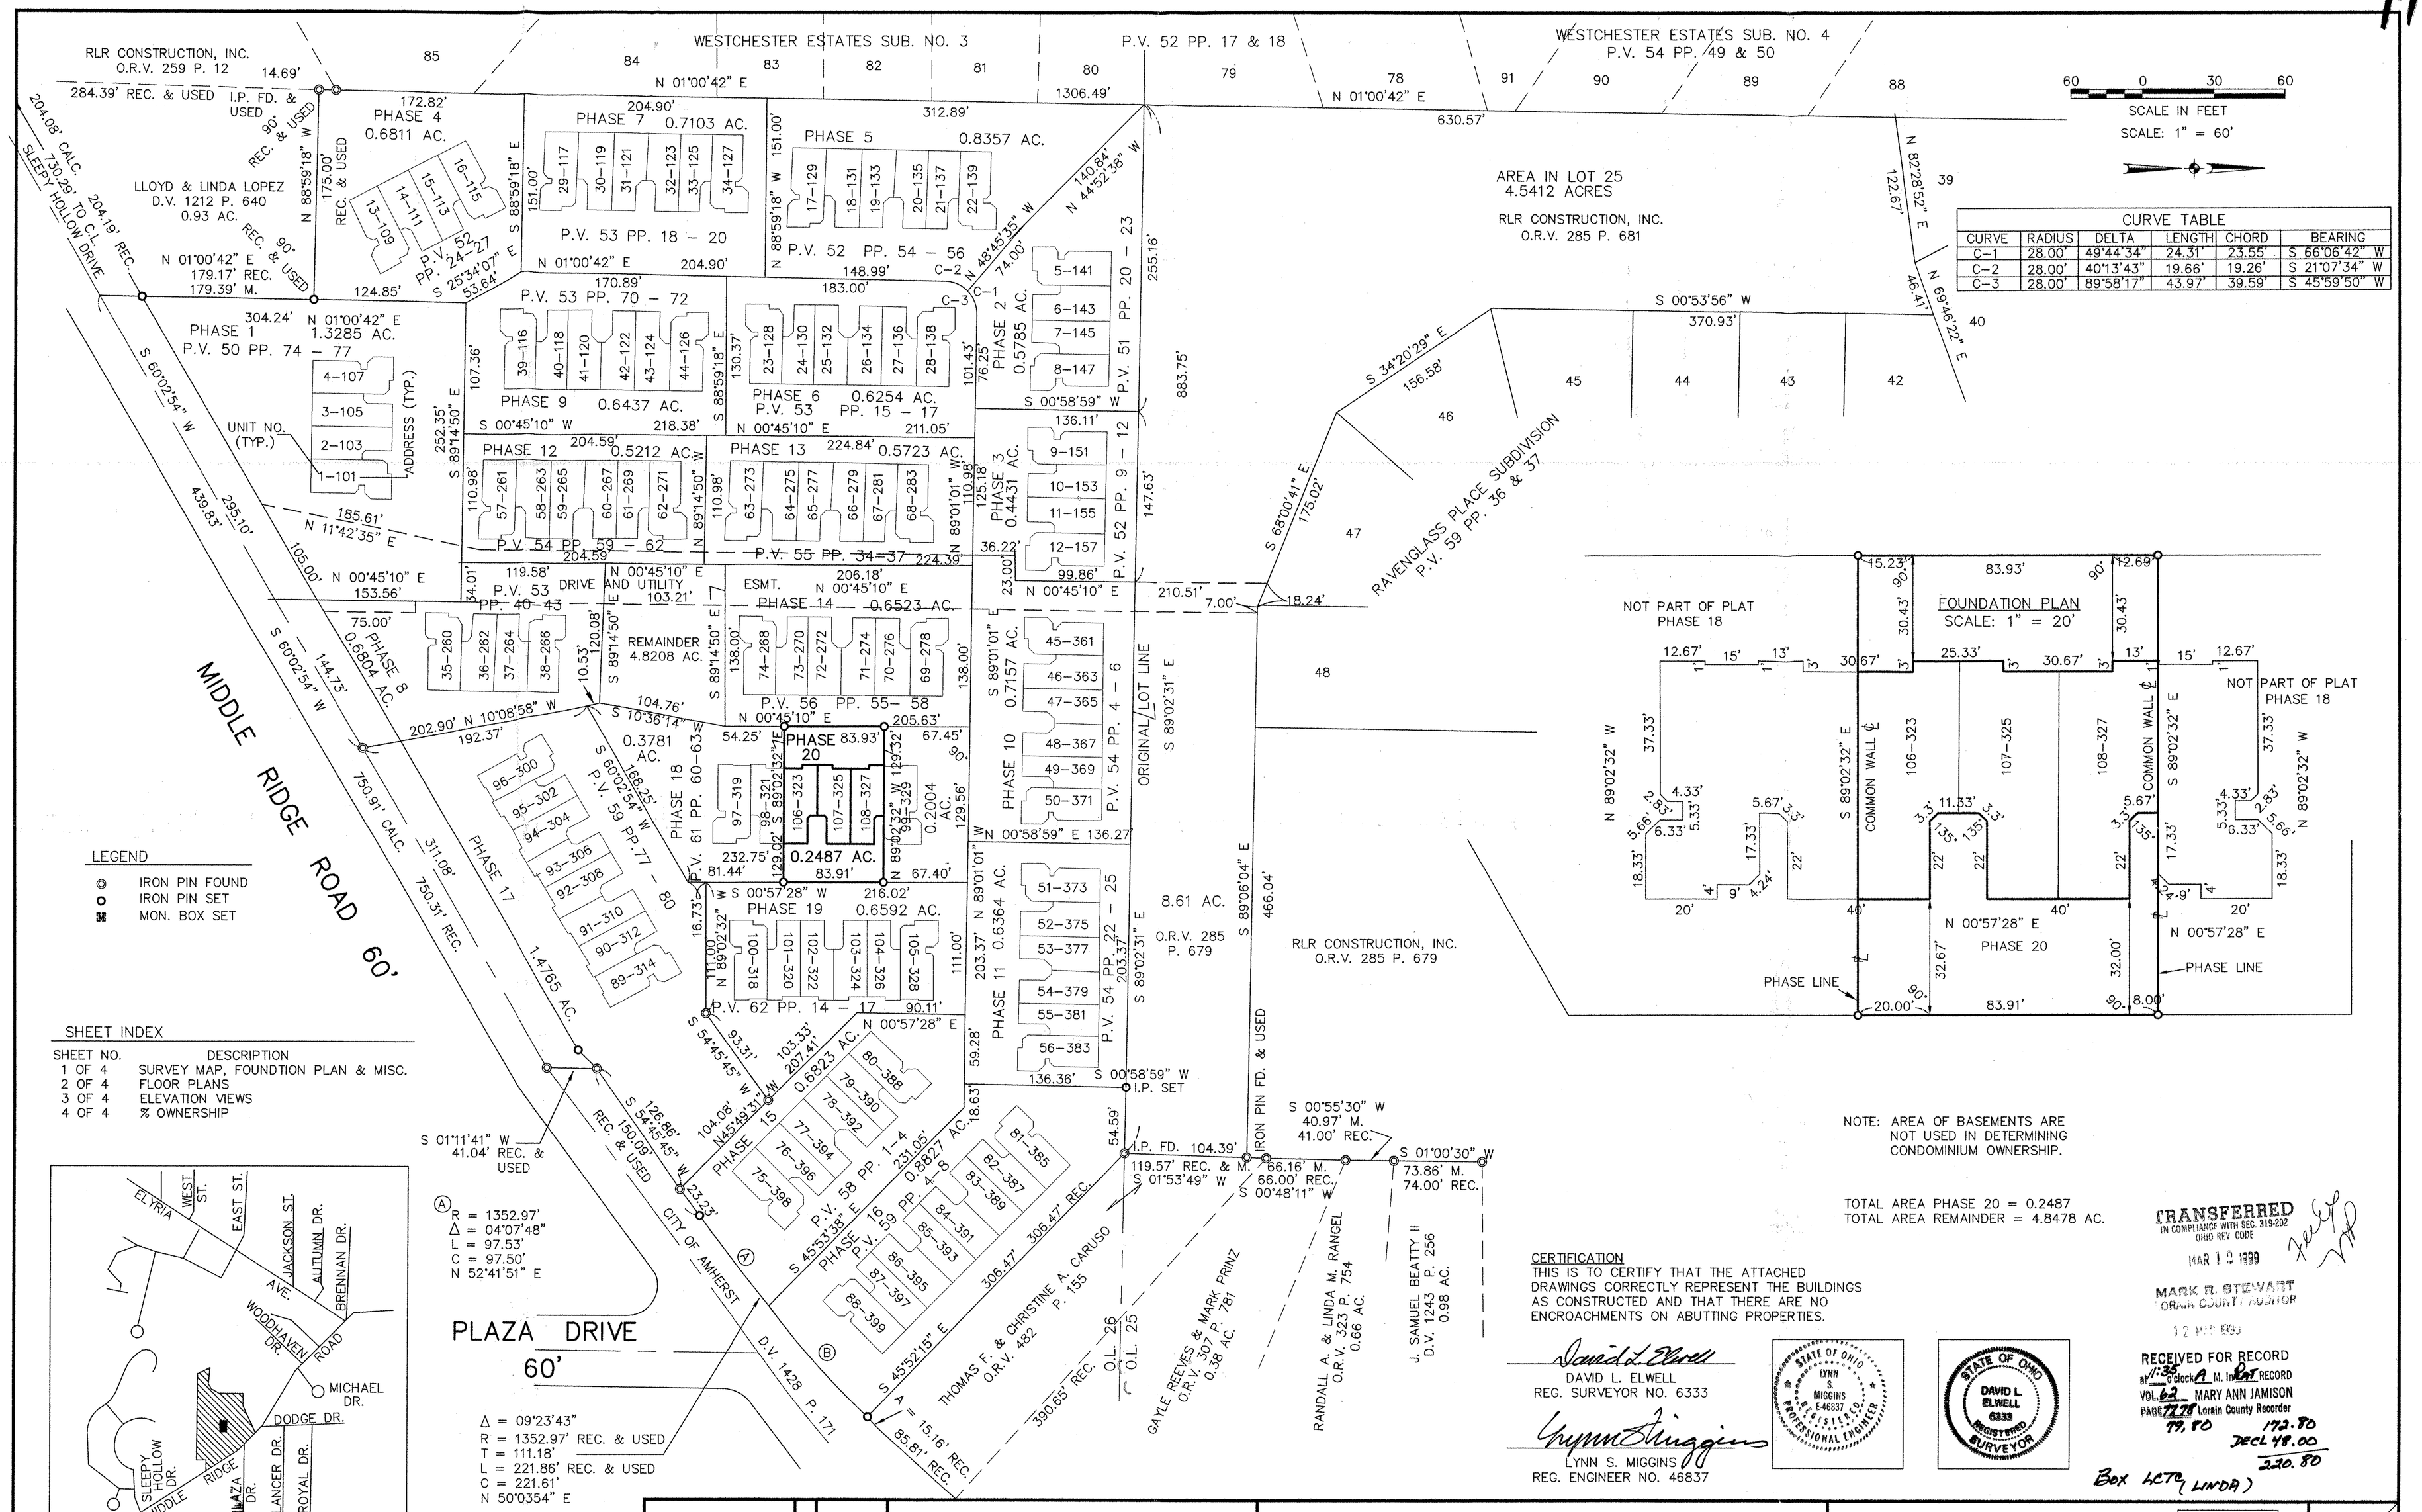

CURVE TABLE					
CURVE	RADIUS	DELTA	LENGTH	CHORD	BEARING
C-1	28.00'	49°44'34"	24.31'	23.55'	S 66°06'42" W
C-2	28.00'	40°13'43"	19.66'	19.26'	S 21°07'34" W
C-3	28.00'	89°58'17"	43.97'	39.59'	S 45°59'50" W

CERTIFICATION
THIS IS TO CERTIFY THAT THE ATTACHED DRAWINGS CORRECTLY REPRESENT THE BUILDINGS AS CONSTRUCTED AND THAT THERE ARE NO ENCROACHMENTS ON ABUTTING PROPERTIES.

DAVID L. ELWELL
REG. SURVEYOR NO. 6333

LYNN S. MIGGINS
REG. ENGINEER NO. 46837

STATE OF OHIO LYNN S. MIGGINS E-46837 REGISTERED PROFESSIONAL ENGINEER

STATE OF OHIO DAVID L. ELWELL 6333 REGISTERED SURVEYOR

TRANSFERRED
IN COMPLIANCE WITH SEC. 319.202 OHIO REV CODE
MAR 12 1999
MARK R. STEWART
LORAIN COUNTY AUDITOR

RECEIVED FOR RECORD
at 11:36 o'clock A M. In Bk RECORD
VOL. 62 MARY ANN JAMISON
PAGE 778 Lorain County Recorder
79.80 172.80
DECL 48.00
220.80

Box LCTC (LINDA)

DATE:	1-8-99
DRAWN BY:	AMK
CH'D BY:	DLE
F.B.	
DWG. NAME:	R:\89224-20\20-SURV01

REVISIONS	
3-10-99	ADDED UNIT NUMBERS TO FOUNDATION PLAN
1-8-99	ORIGINAL ISSUE

THE ENGLISH LAKES CONDOMINIUMS PHASE 20

PART OF AMHERST TOWNSHIP O.L.s 25 & 26
CITY OF AMHERST * COUNTY OF LORAIN * STATE OF OHIO

KS ASSOCIATES, INC.
ENGINEERS/SURVEYORS
424 Middle Avenue
P.O. Box 89
Elyria, Ohio 44036
PHONE: (440) 322-6317 * FAX: (440) 284-0623

ENGINEERS/SURVEYORS KS ASSOCIATES INCORPORATED

SHEET 1 OF 4

JOB NO. 89224-CP20