05-00-037-113-03 /
05-00-037-4
Scan # 45500

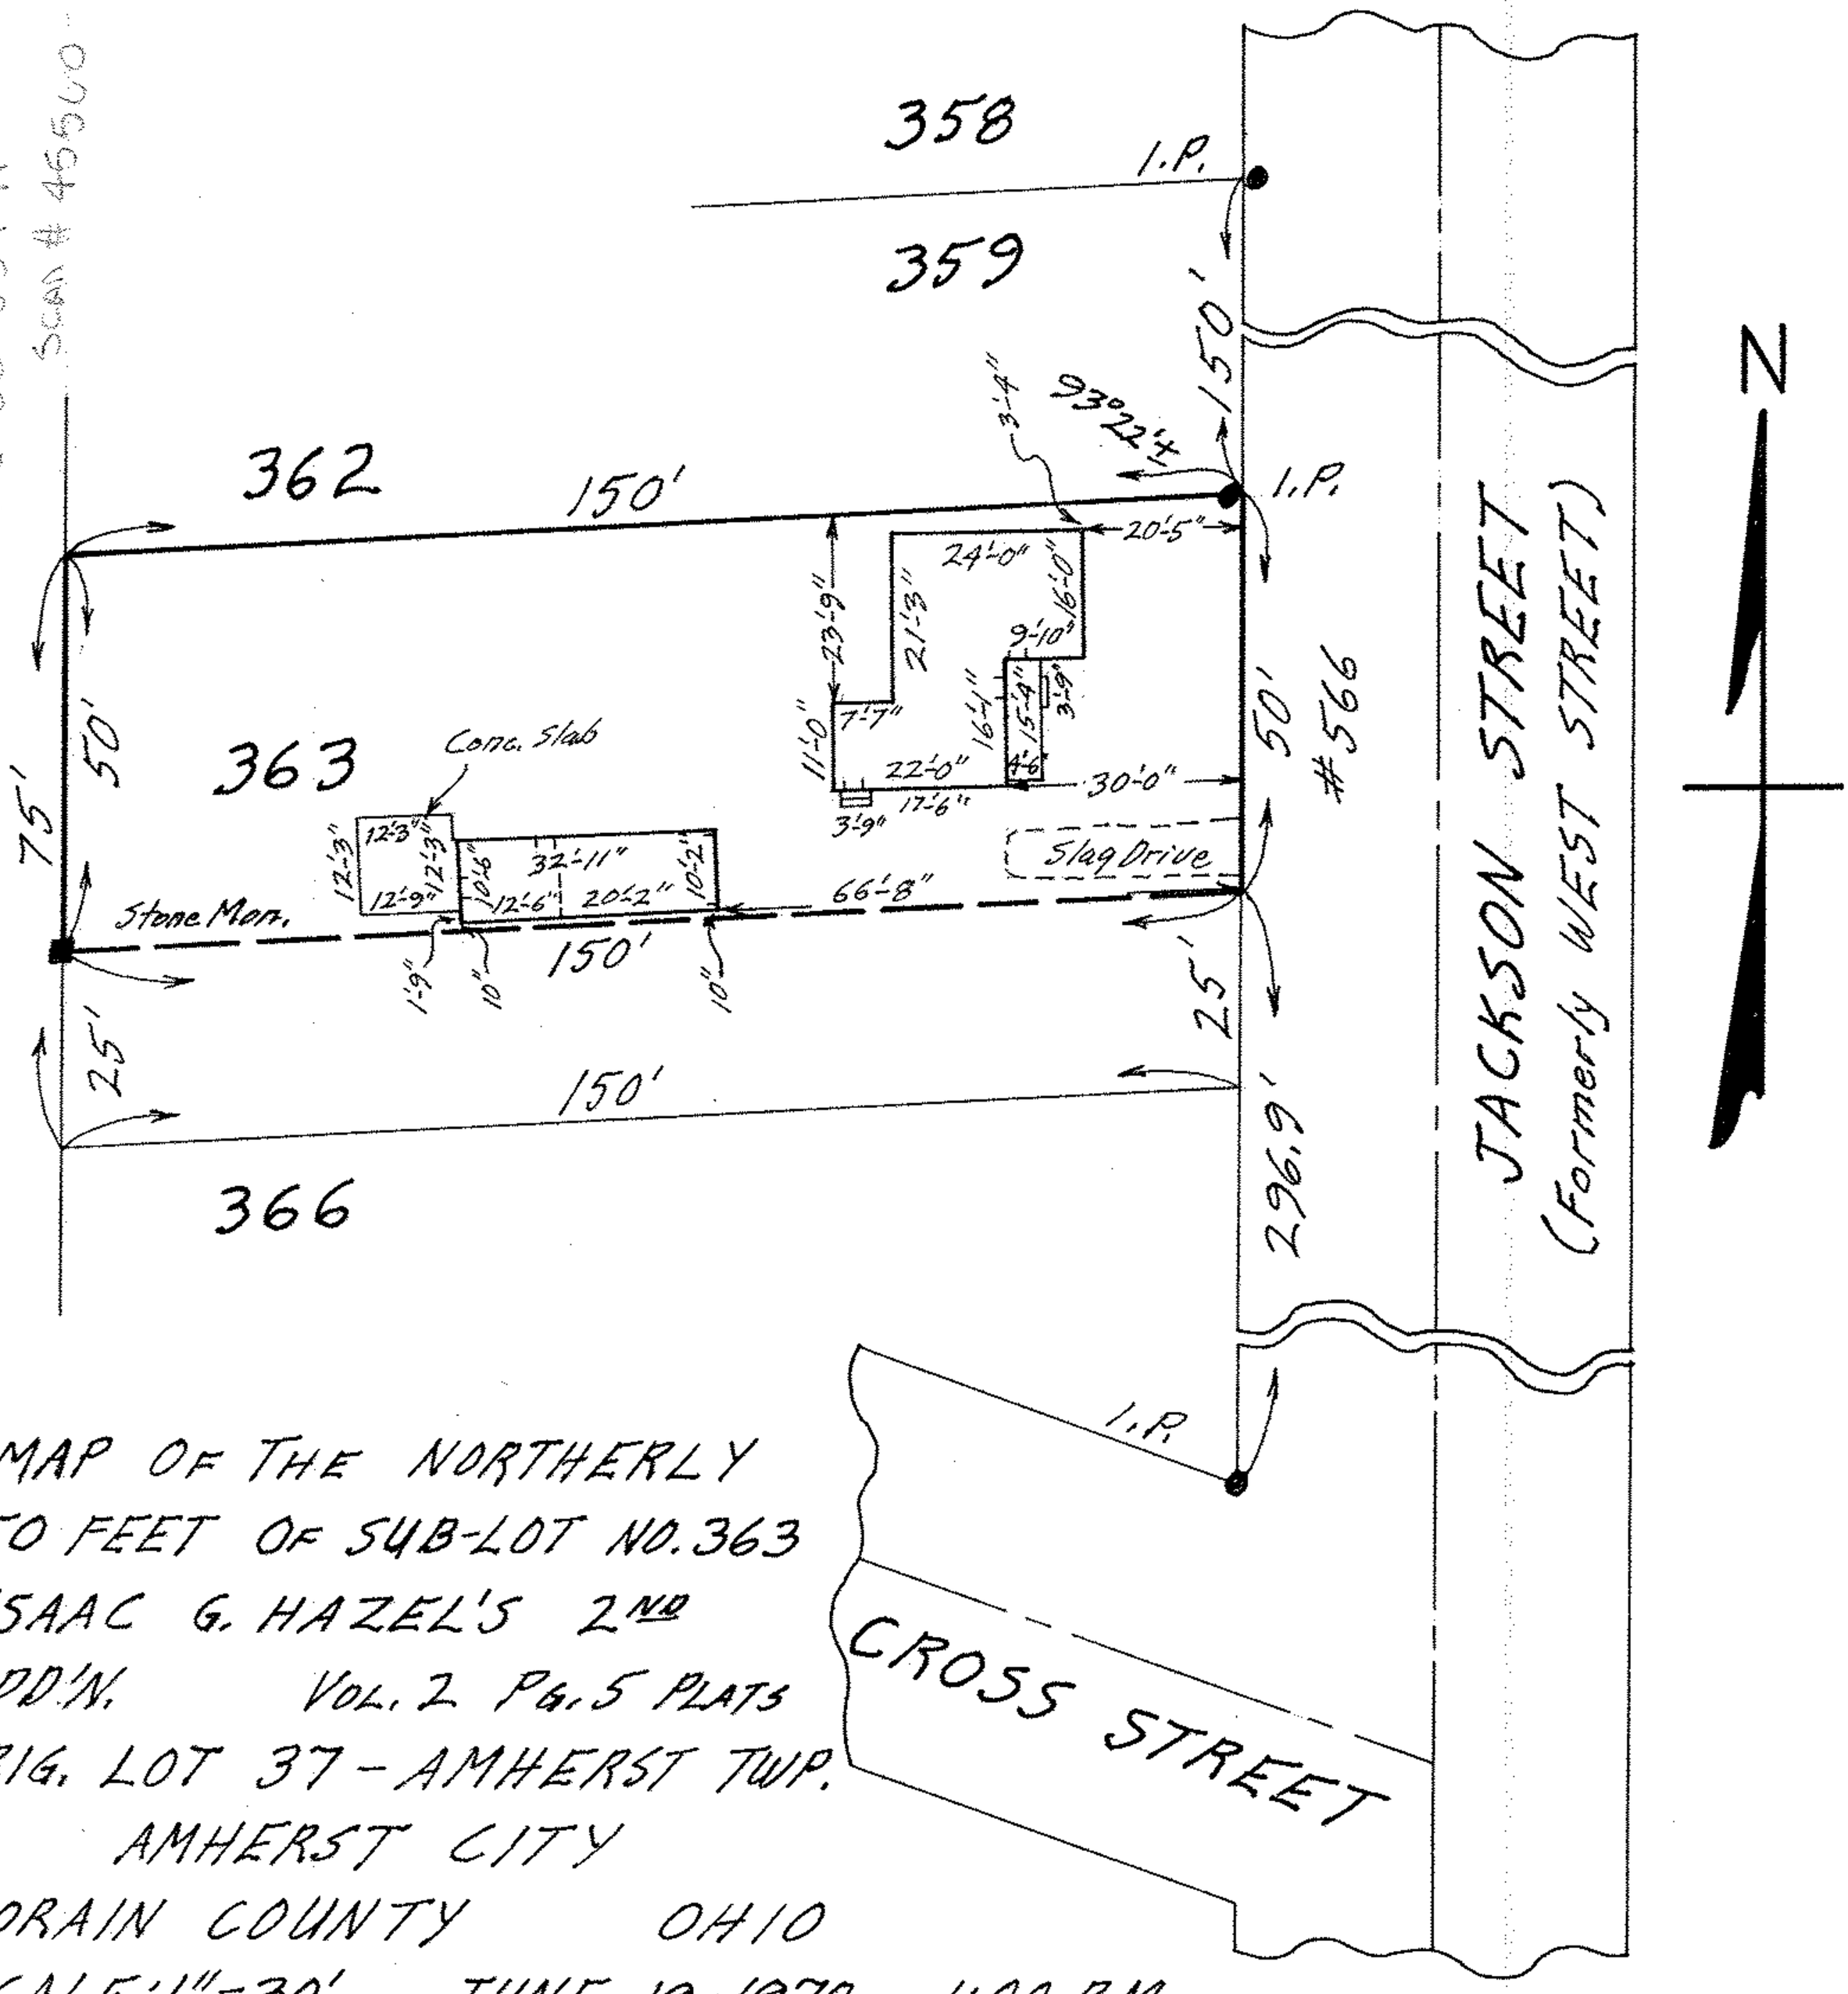

MAP OF THE NORTHERLY
50 FEET OF SUB-LOT NO. 363
ISAAC G. HAZEL'S 2ND
ADD'N. VOL. 2 PG. 5 PLATS
ORIG. LOT 37 - AMHERST TWP.
AMHERST CITY
LORAIN COUNTY OHIO
SCALE: 1"=30' JUNE 19-1970 1:00 P.M.
NOTE: There are no encroachments on this property.
Gary E. Penfound REG. SURVEYOR NO. 4457

CITY TITLE Co. Order No. E-1148-9
Margaret C. Sagert to
David A. & Robin L. Bring