05-00-038-103-

survey map of subdivision of sublot
1 and 2 Gertrude Leuszler Sub.
O.L. 38 Amherst Twp. Now City of
Amherst Lorain Co. Ohio
Scale 1" 50' June 26, 1986
By Arnold F. Koepp Reg. Surveyor
No. 4306

This Corr. done by Ronda From K. S. & Assoc. 7-22-87 with Arnold Koepp Approval

05-00-038-103-023,-024,-003,-004
Scan # 4556

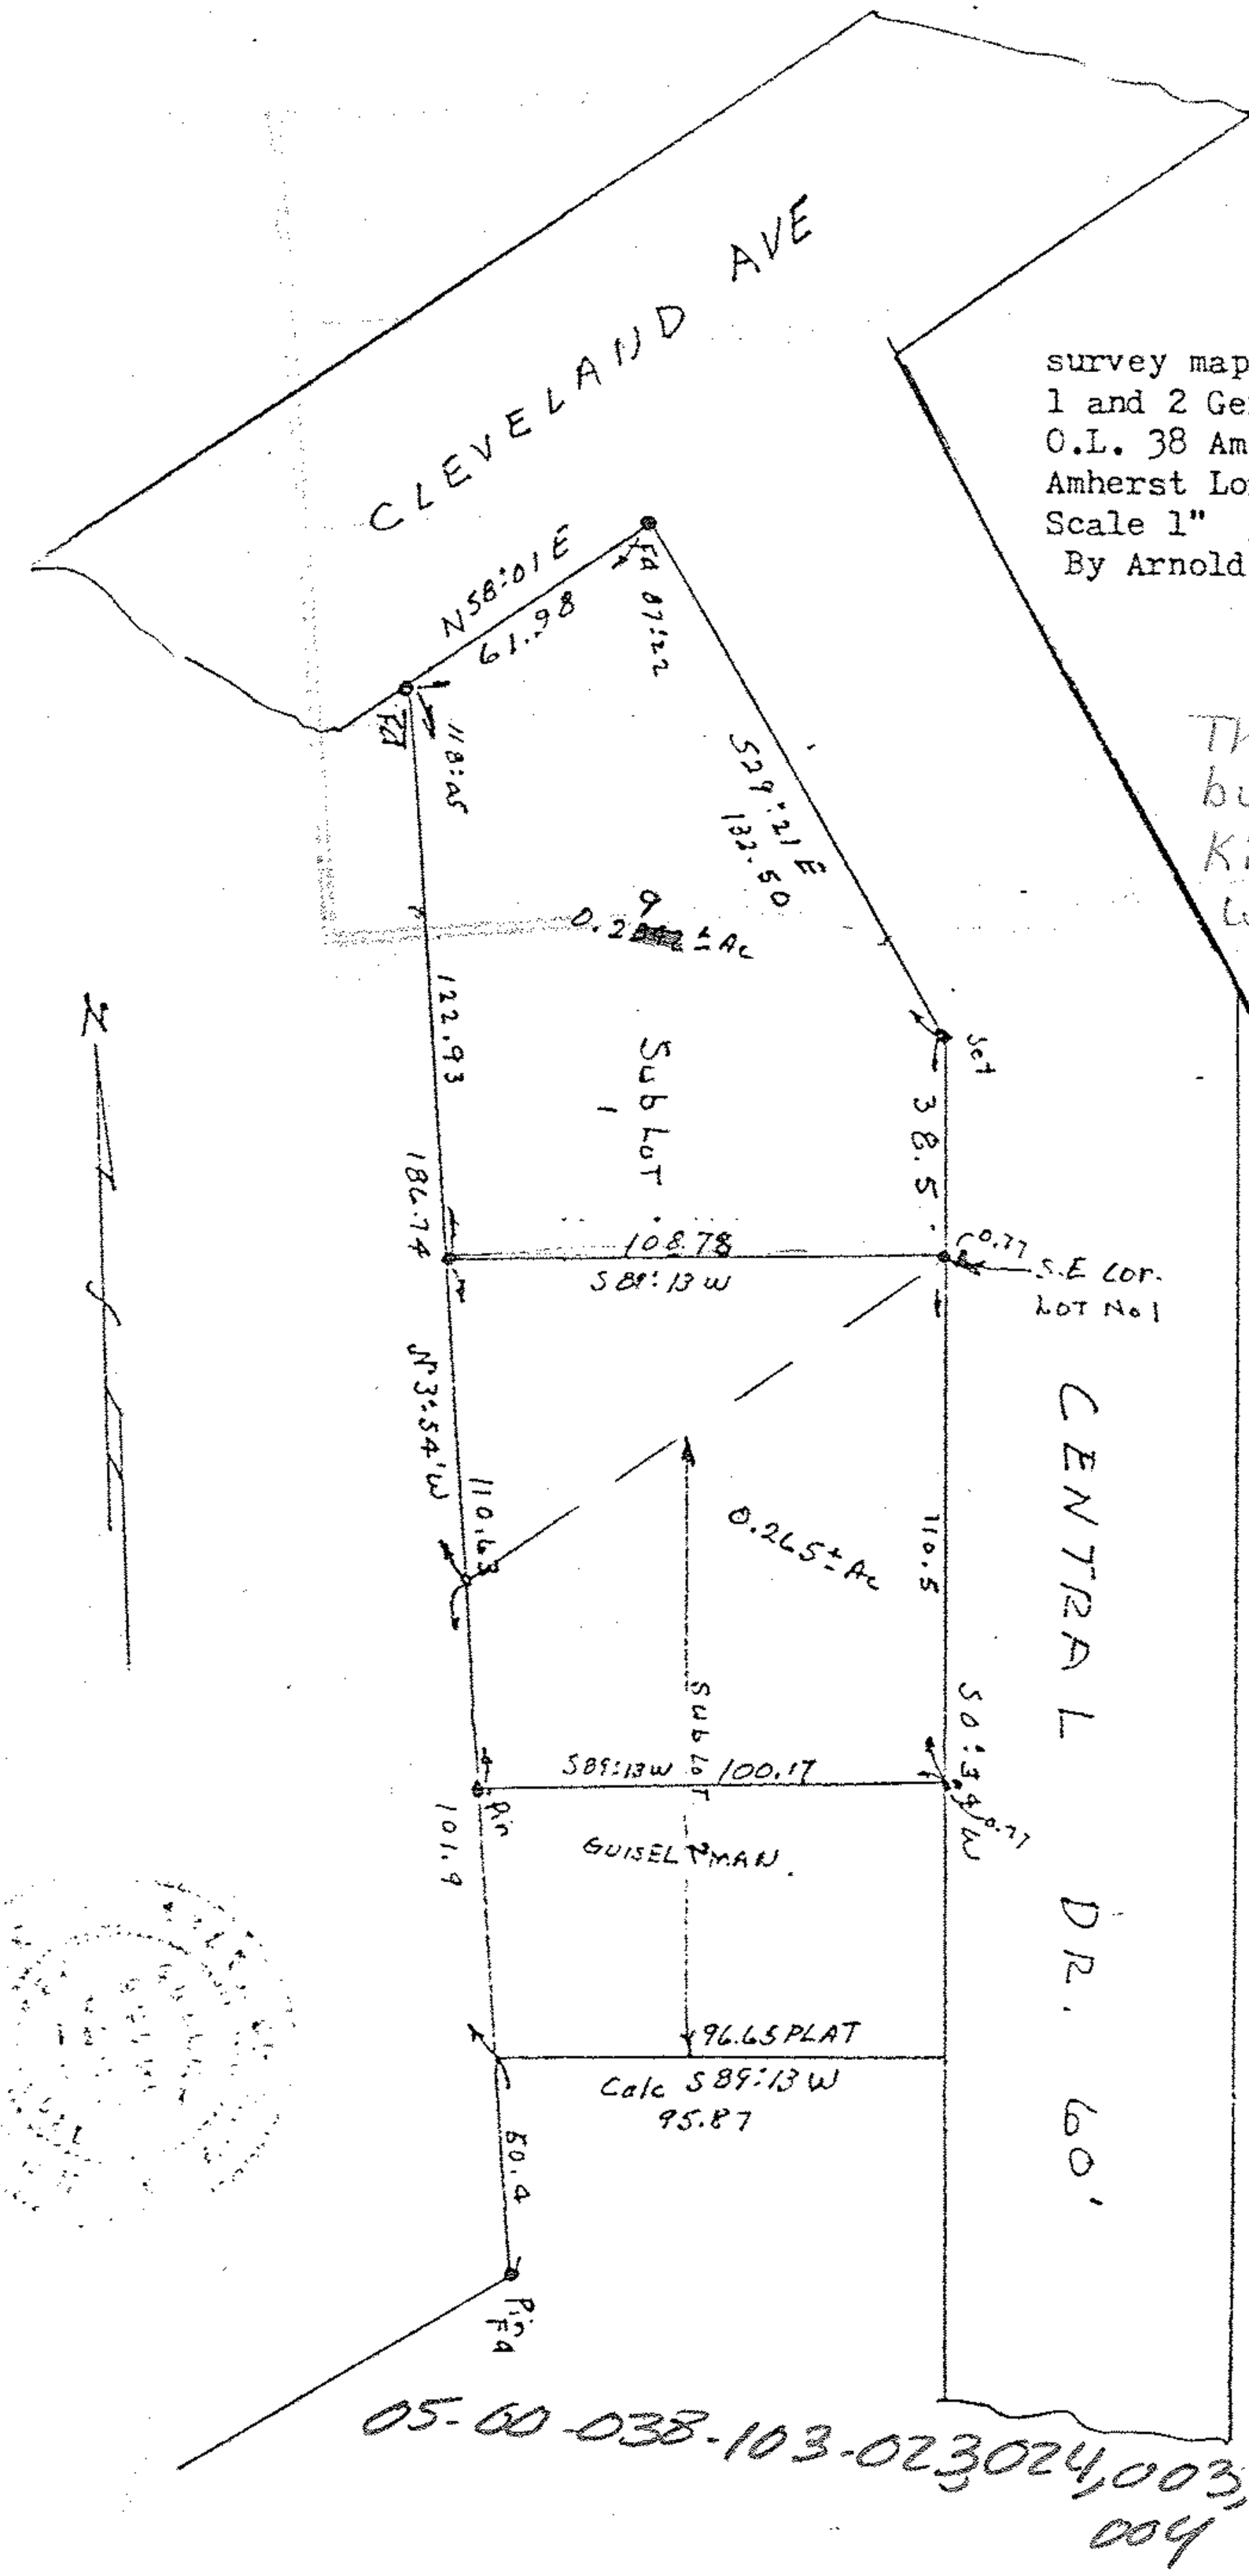

05-00-038-103-

05-00-038-A

#17550

#17550

APPROVED
LORAIN CO.
MAP DEPT.
DATE 7-23-87
PAGE 5-00-038A
BY C. FRANCIS
VOID AFTER 17550