MAP OF PART OF ORIG. LOT NO. 42
AMHERST TOWNSHIP
LORAIN COUNTY OHIO
SCALE: 1" = 30' JAN. 7-1966 9:30 A.M.
Gary E. Penfound
for C. E. Penfound REG. SURVEYORS

GL-1416 Peter & Alexsaundra
M. Rogers

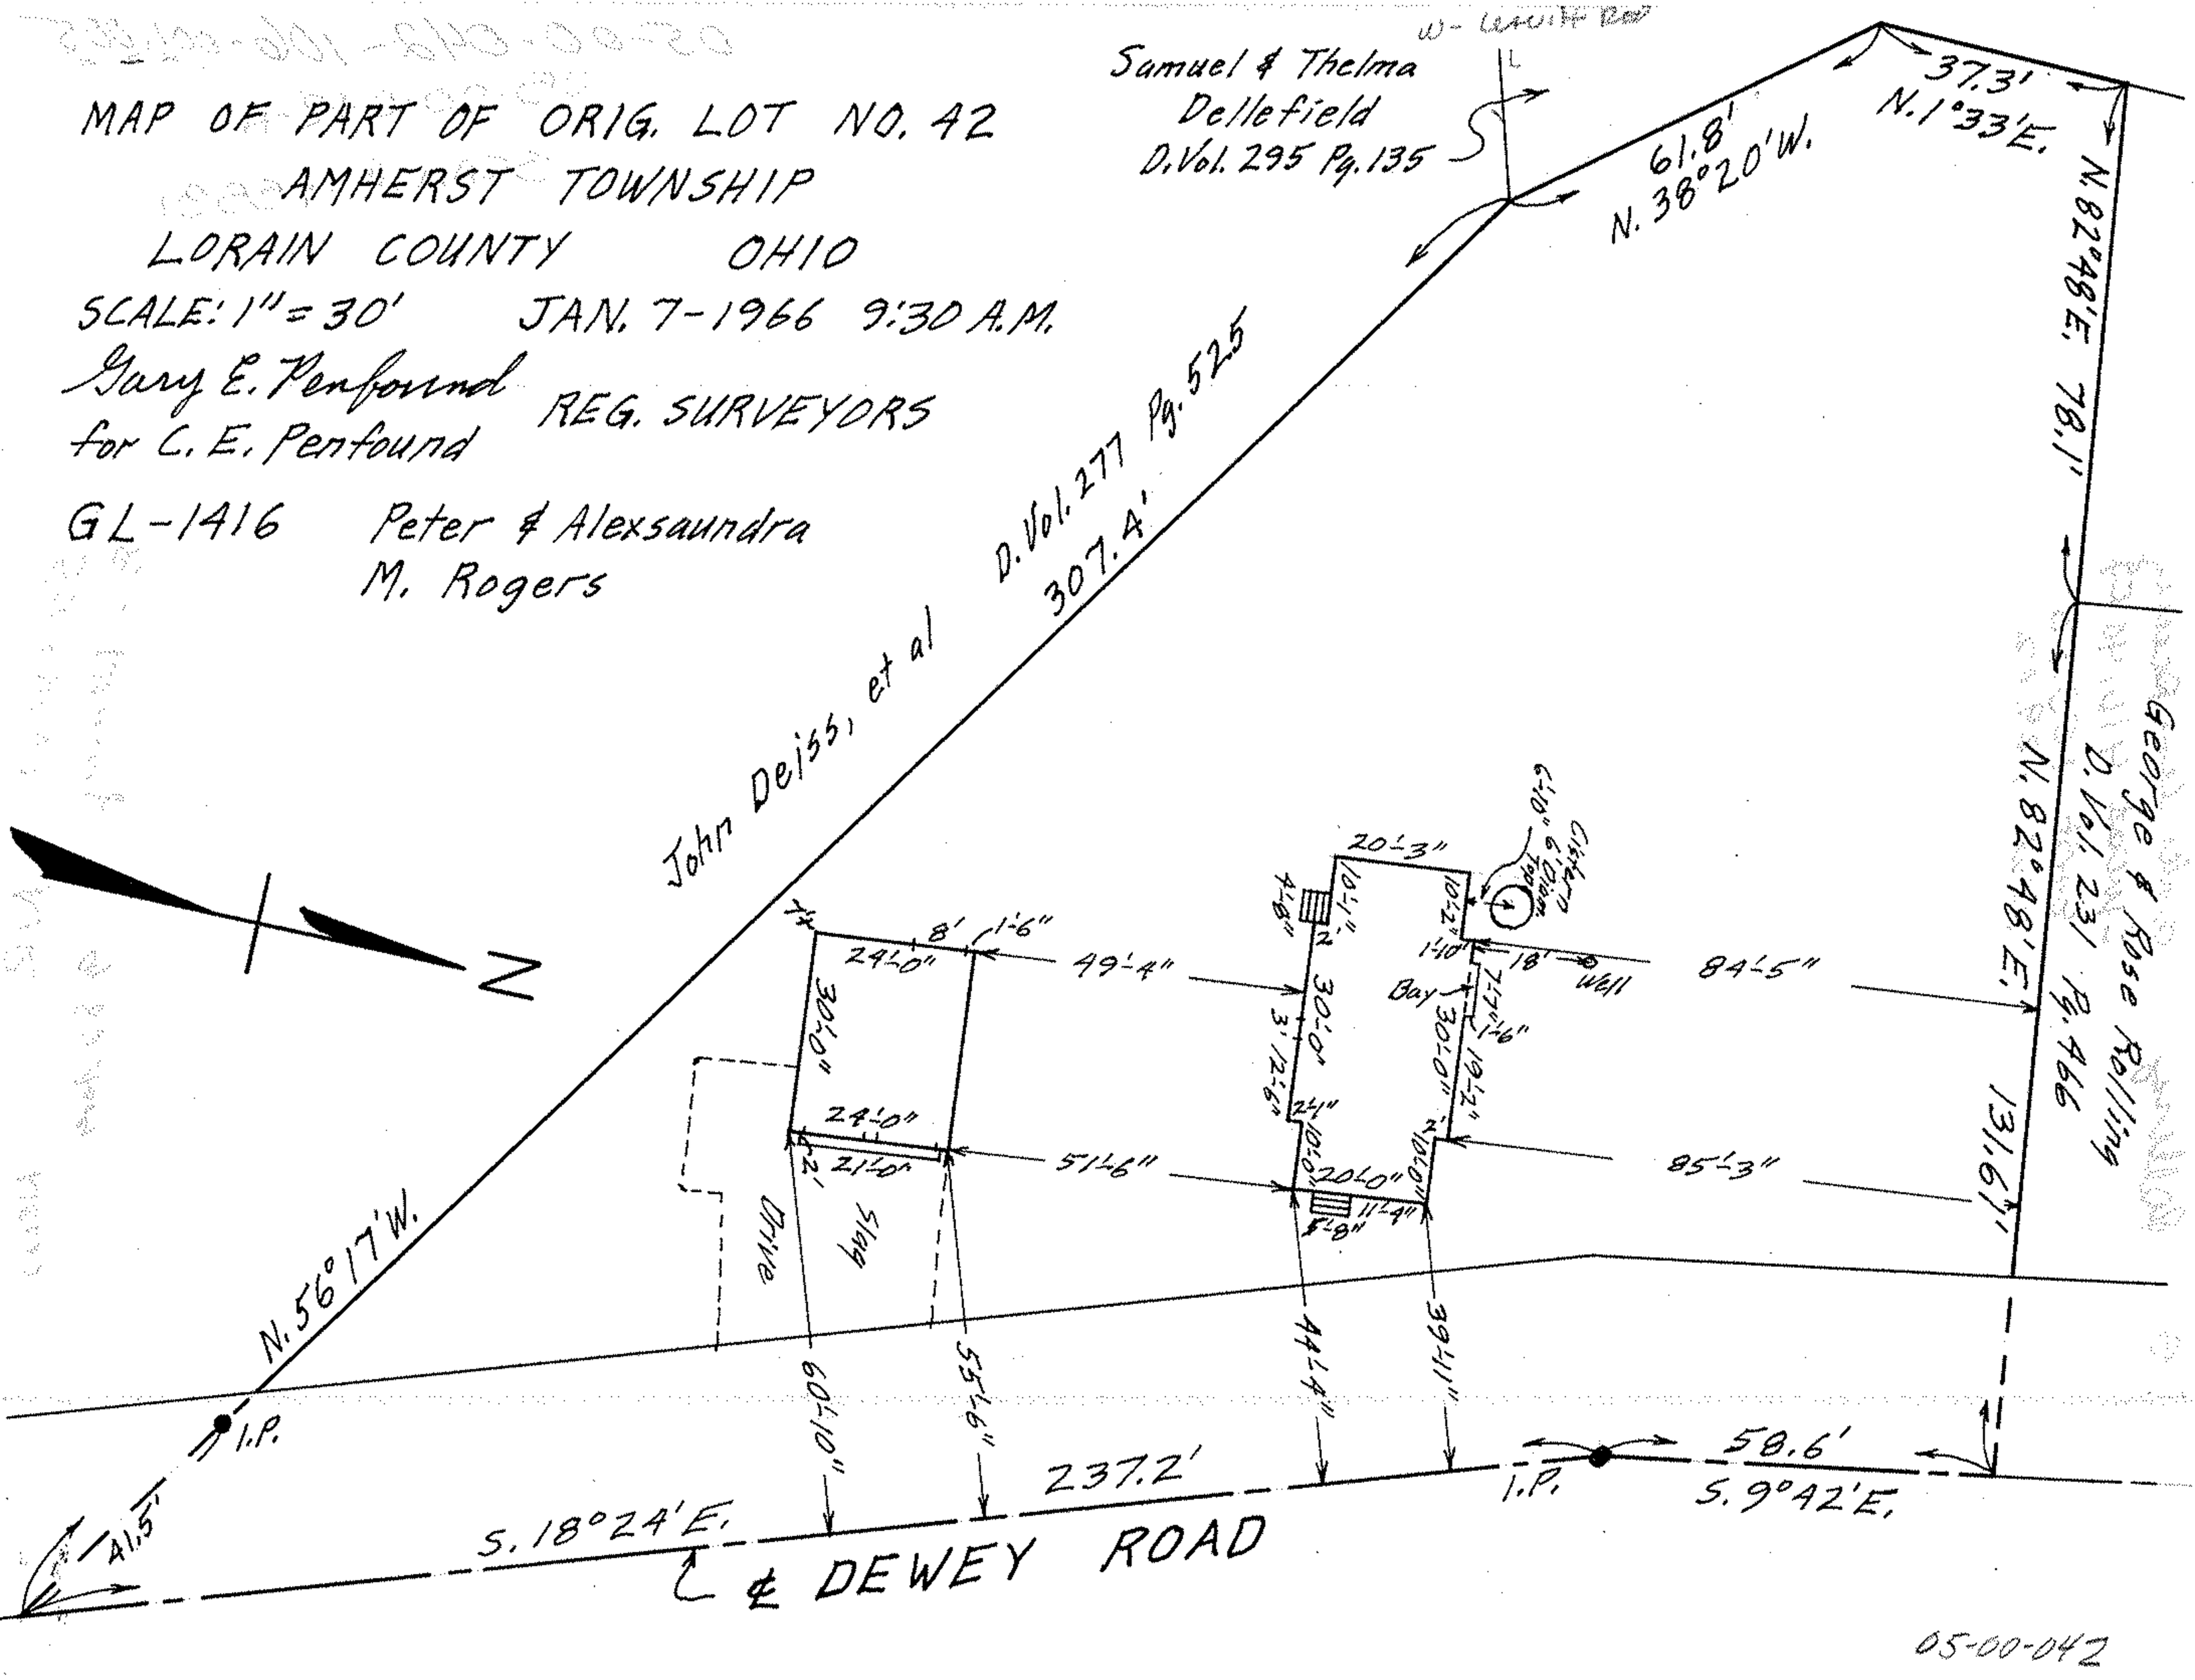

05-00-042