


30-025,-035,-037

05-00-0

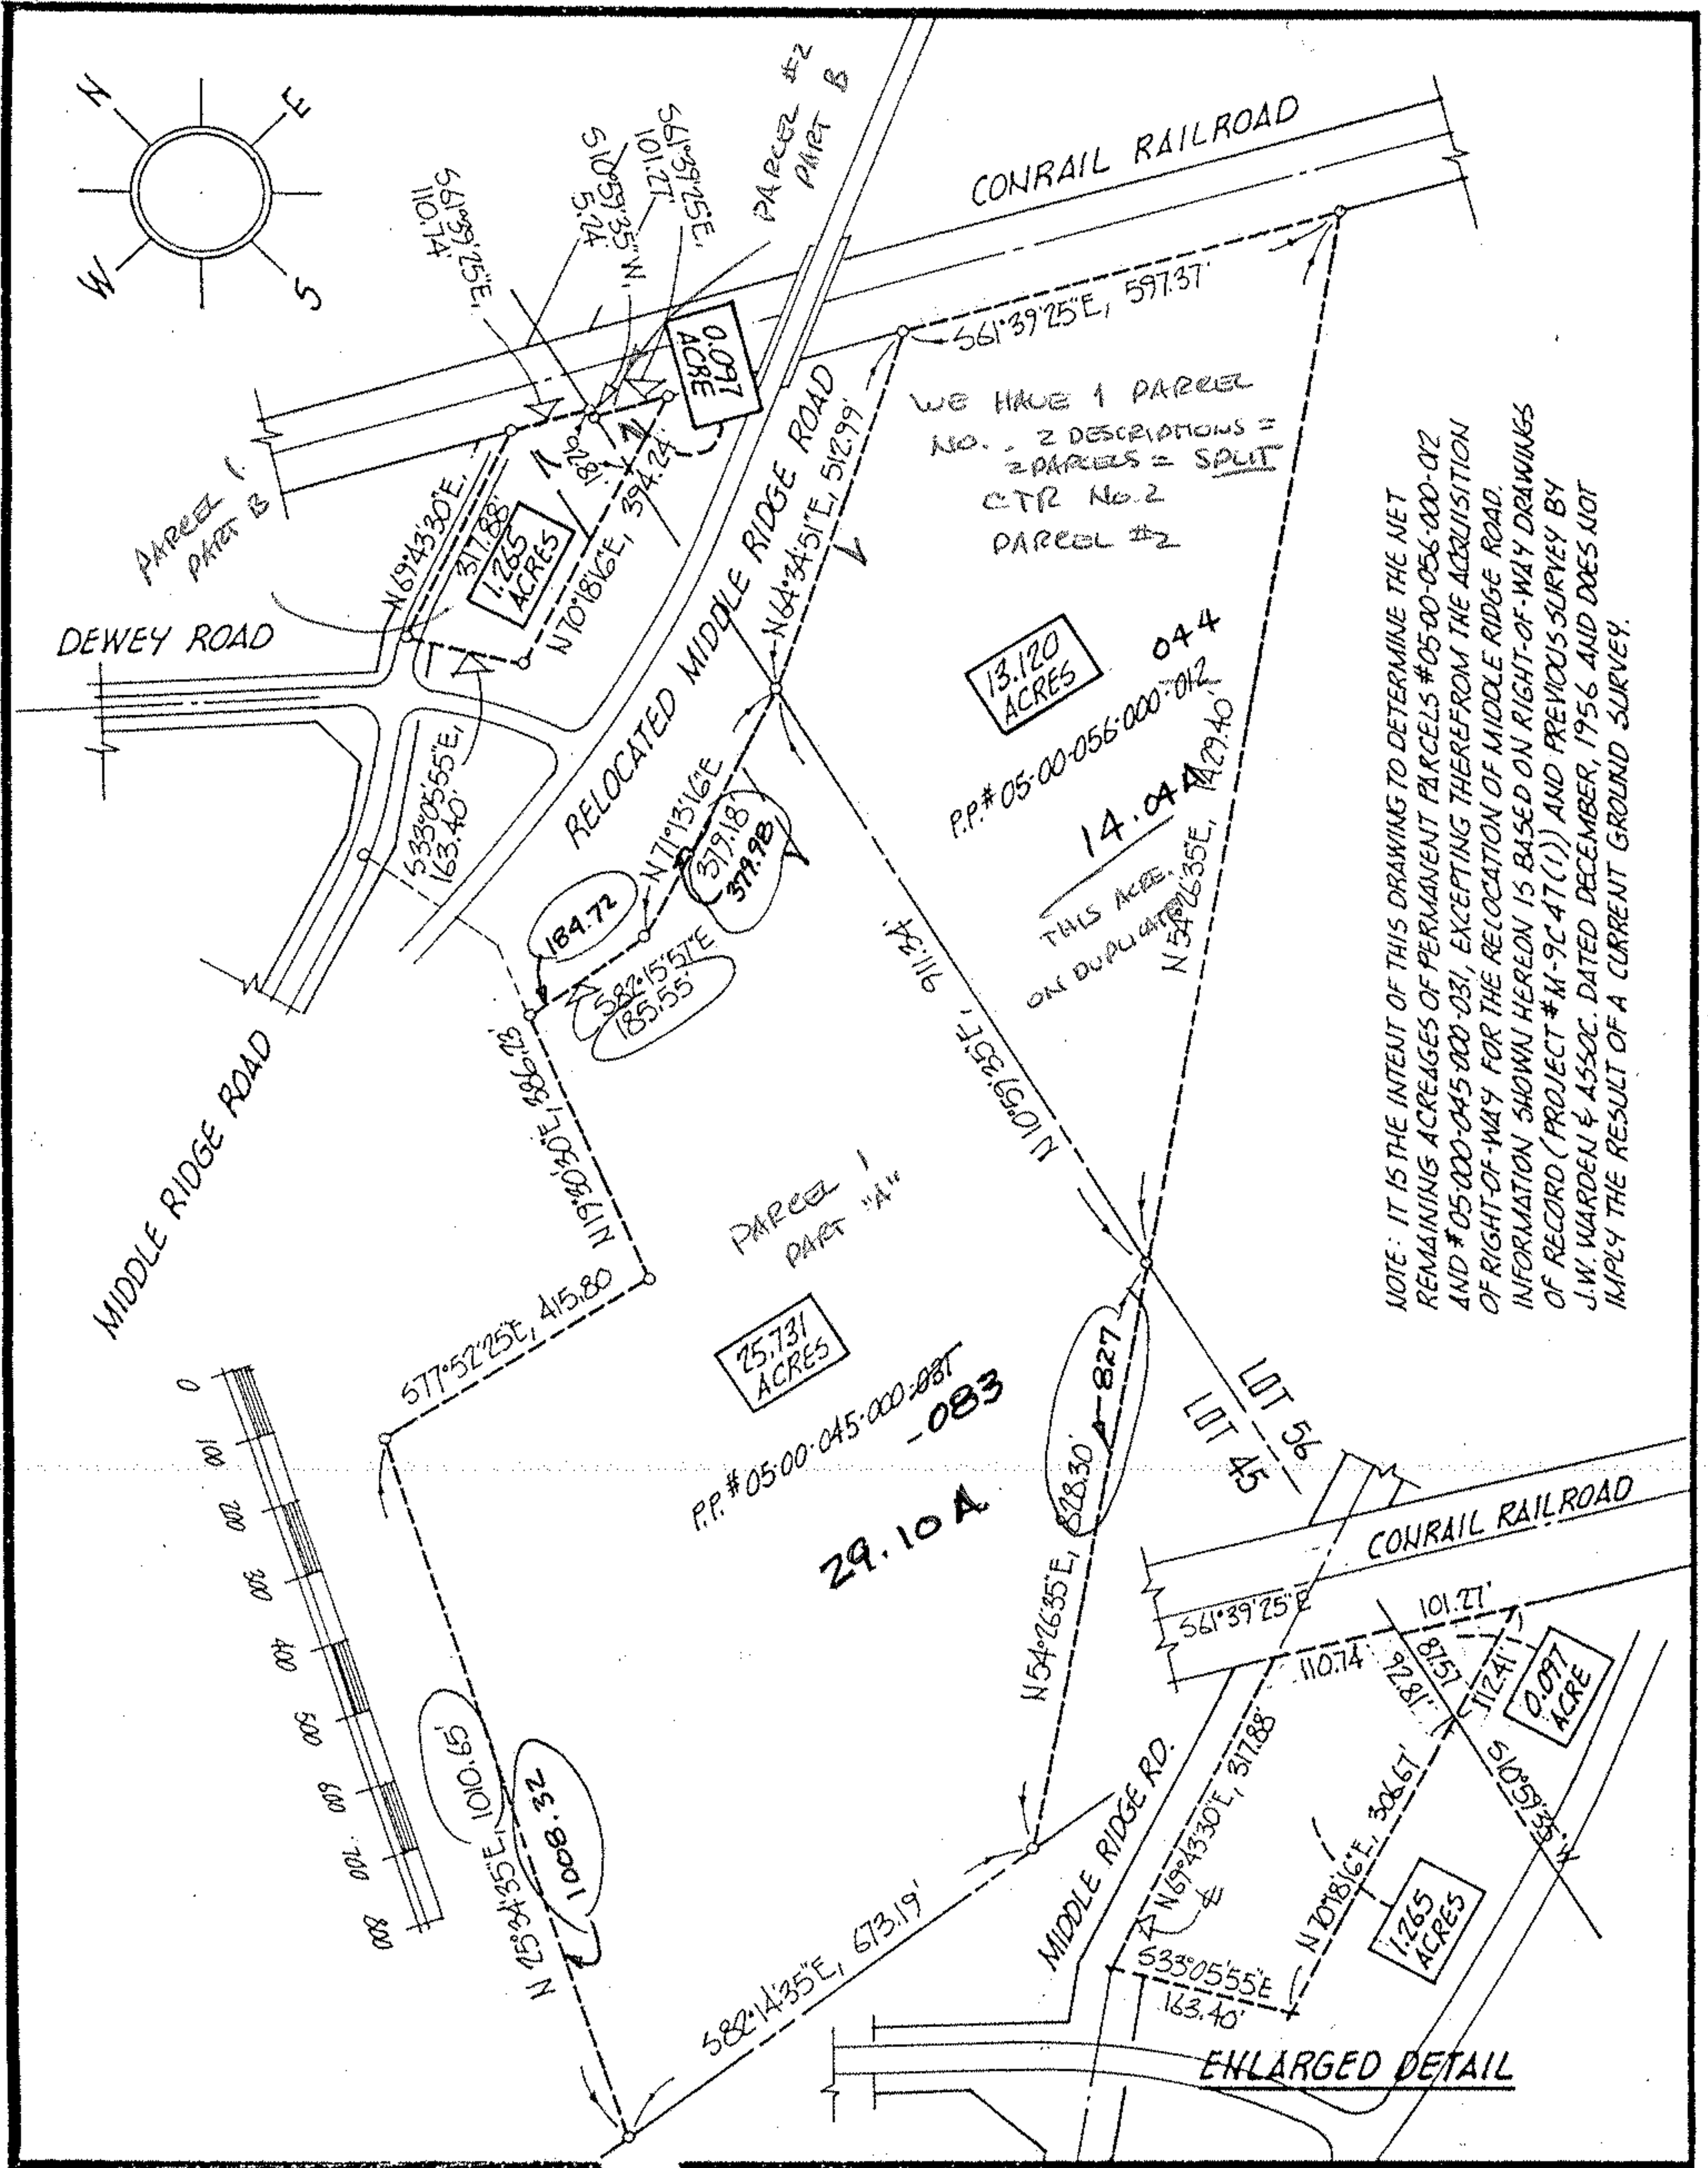

| | |
|---------|--------------|
| ACREAGE | MISC |
| DATE | JUN-92 |
| DRAWN | MGH |
| SCALE | 1" = 300 ft. |

PREPARED FOR WALT DOLYK

MICHAEL G. HURA, registered surveyor.
12706 MASON RD., VERMILION, O., PH (216) 965 4040

CITY OF

PARCEL SPLIT APPROVAL

SUBLOT(s) _____ of _____
 _____, Volume _____ Page _____ of PLATS
 PART OF O.L. 45456 TRACT _____ SECTION _____ OF
AMHERST TOWNSHIP LORAIN CO., OHIO
 PERMANENT PARCEL NO. _____

