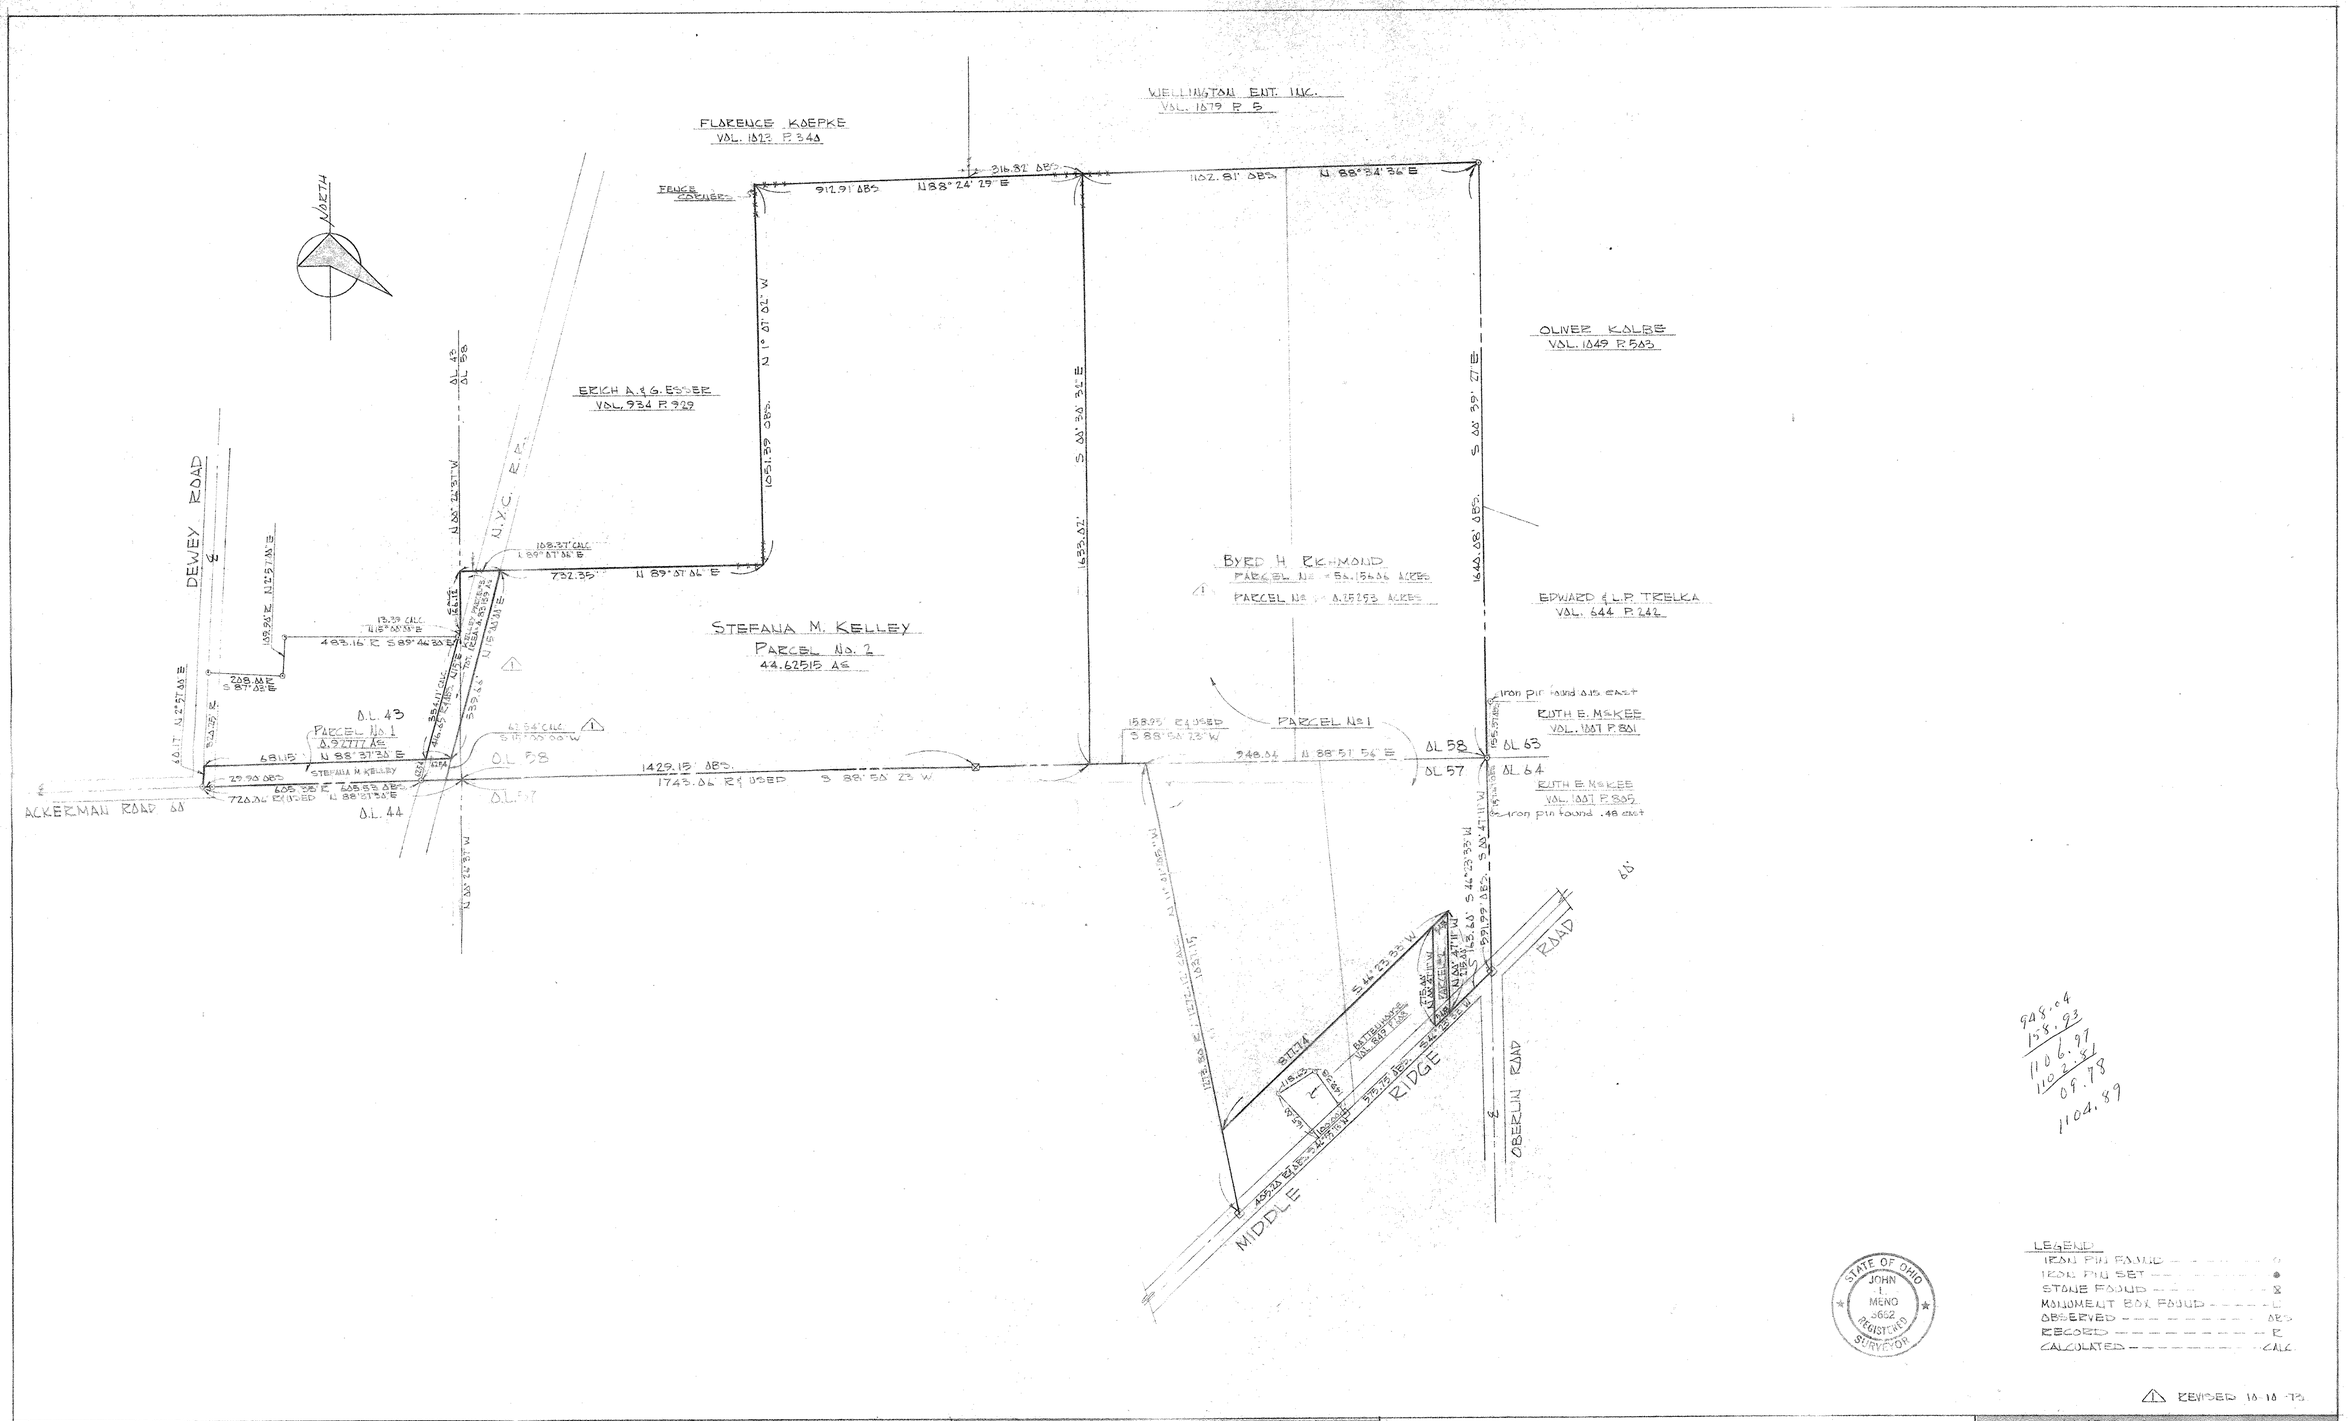

948.04
158.93
1106.97
1102.51
09.78
1104.89

LEGEND
IRON PIN FOUND
IRON PIN SET
STONE FOUND
MONUMENT BOX FOUND
OBSERVED — OBS
RECORD — R
CALCULATED — CALC

STATE OF OHIO
JOHN I. MENO
5652
REGISTERED SURVEYOR

REVISED 10-10-78

GARGASZ SURVEYS

STEFANA M. KELLEY & BYRD H. RICHMOND PARCELS

SCHAFER, HURA & ASSOCIATES, INC.
ENGINEERS AND SURVEYORS
4656 OBERLIN AVE.
LORAIN, OHIO

ORIGINAL LOT	44, 45, 57, 58	DATE	10-07-78
TOWNSHIP	AMHERST	SCALE	1" = 200'
CITY OF	AMHERST	FIELD BOOK	222 PAGE 16
COUNTY OF	LORAIN	DRAWN BY	JEE
STATE OF	OHIO	CHECKED BY	
N. O.	2646	FILE NO.	S-AA-44,45,57,58