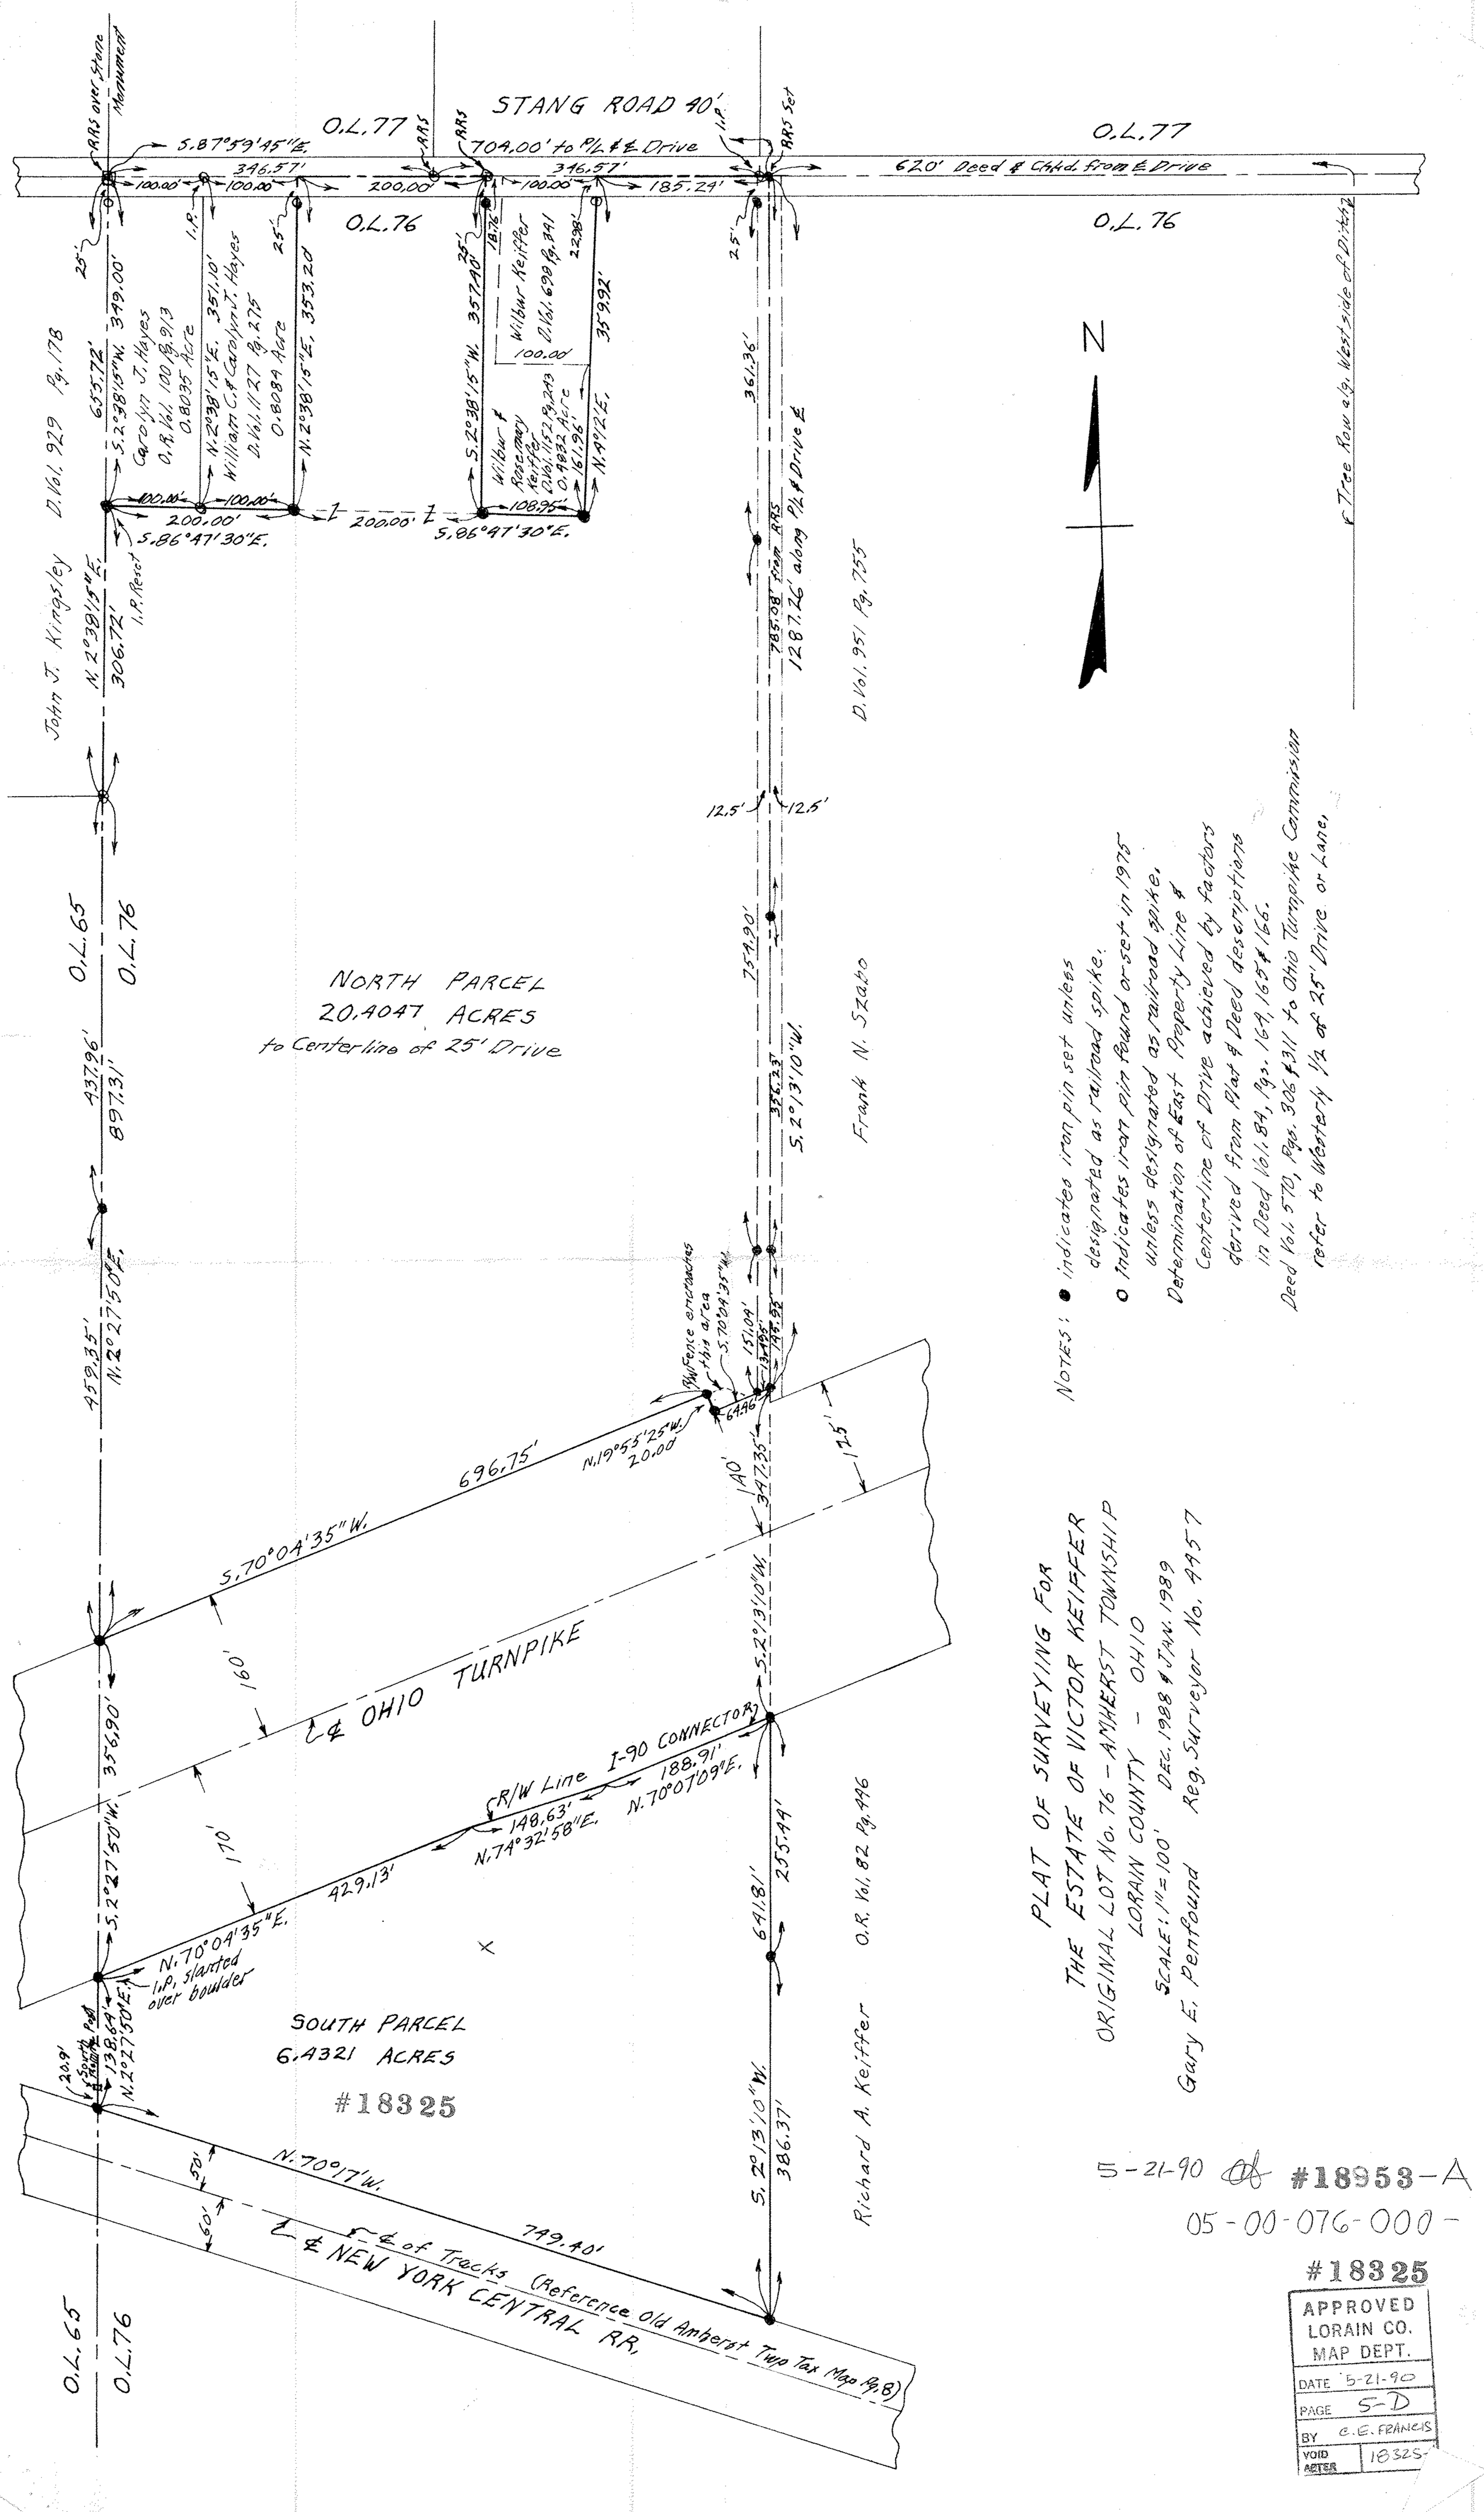

NOTES: ● indicates iron pin set unless designated as railroad spike.
○ indicates iron pin found or set unless designated as railroad spike.
Determination of East Property Line & Centerline of Drive achieved by factors derived from Plat & Deed descriptions in Deed Vol. 84, Pgs. 164, 165 & 166. Deed Vol. 570, Pgs. 306 & 311 to Ohio Turnpike Commission refer to Westerly 1/2 of 25' Drive or Lane.

PLAT OF SURVEYING FOR
THE ESTATE OF VICTOR KEIFFER
ORIGINAL LOT No. 76 - AMHERST TOWNSHIP
LORAIN COUNTY - OHIO
SCALE: 1"=100' DEC. 1988 & JAN. 1989
Gary E. Penfound Reg. Surveyor No. 4957

5-21-90 #18953-A
05-00-076-000-

#18325

APPROVED
LORAIN CO.
MAP DEPT.
DATE 5-21-90
PAGE 5-D
BY C.E. FRANCIS
VOID AFTER 18325-