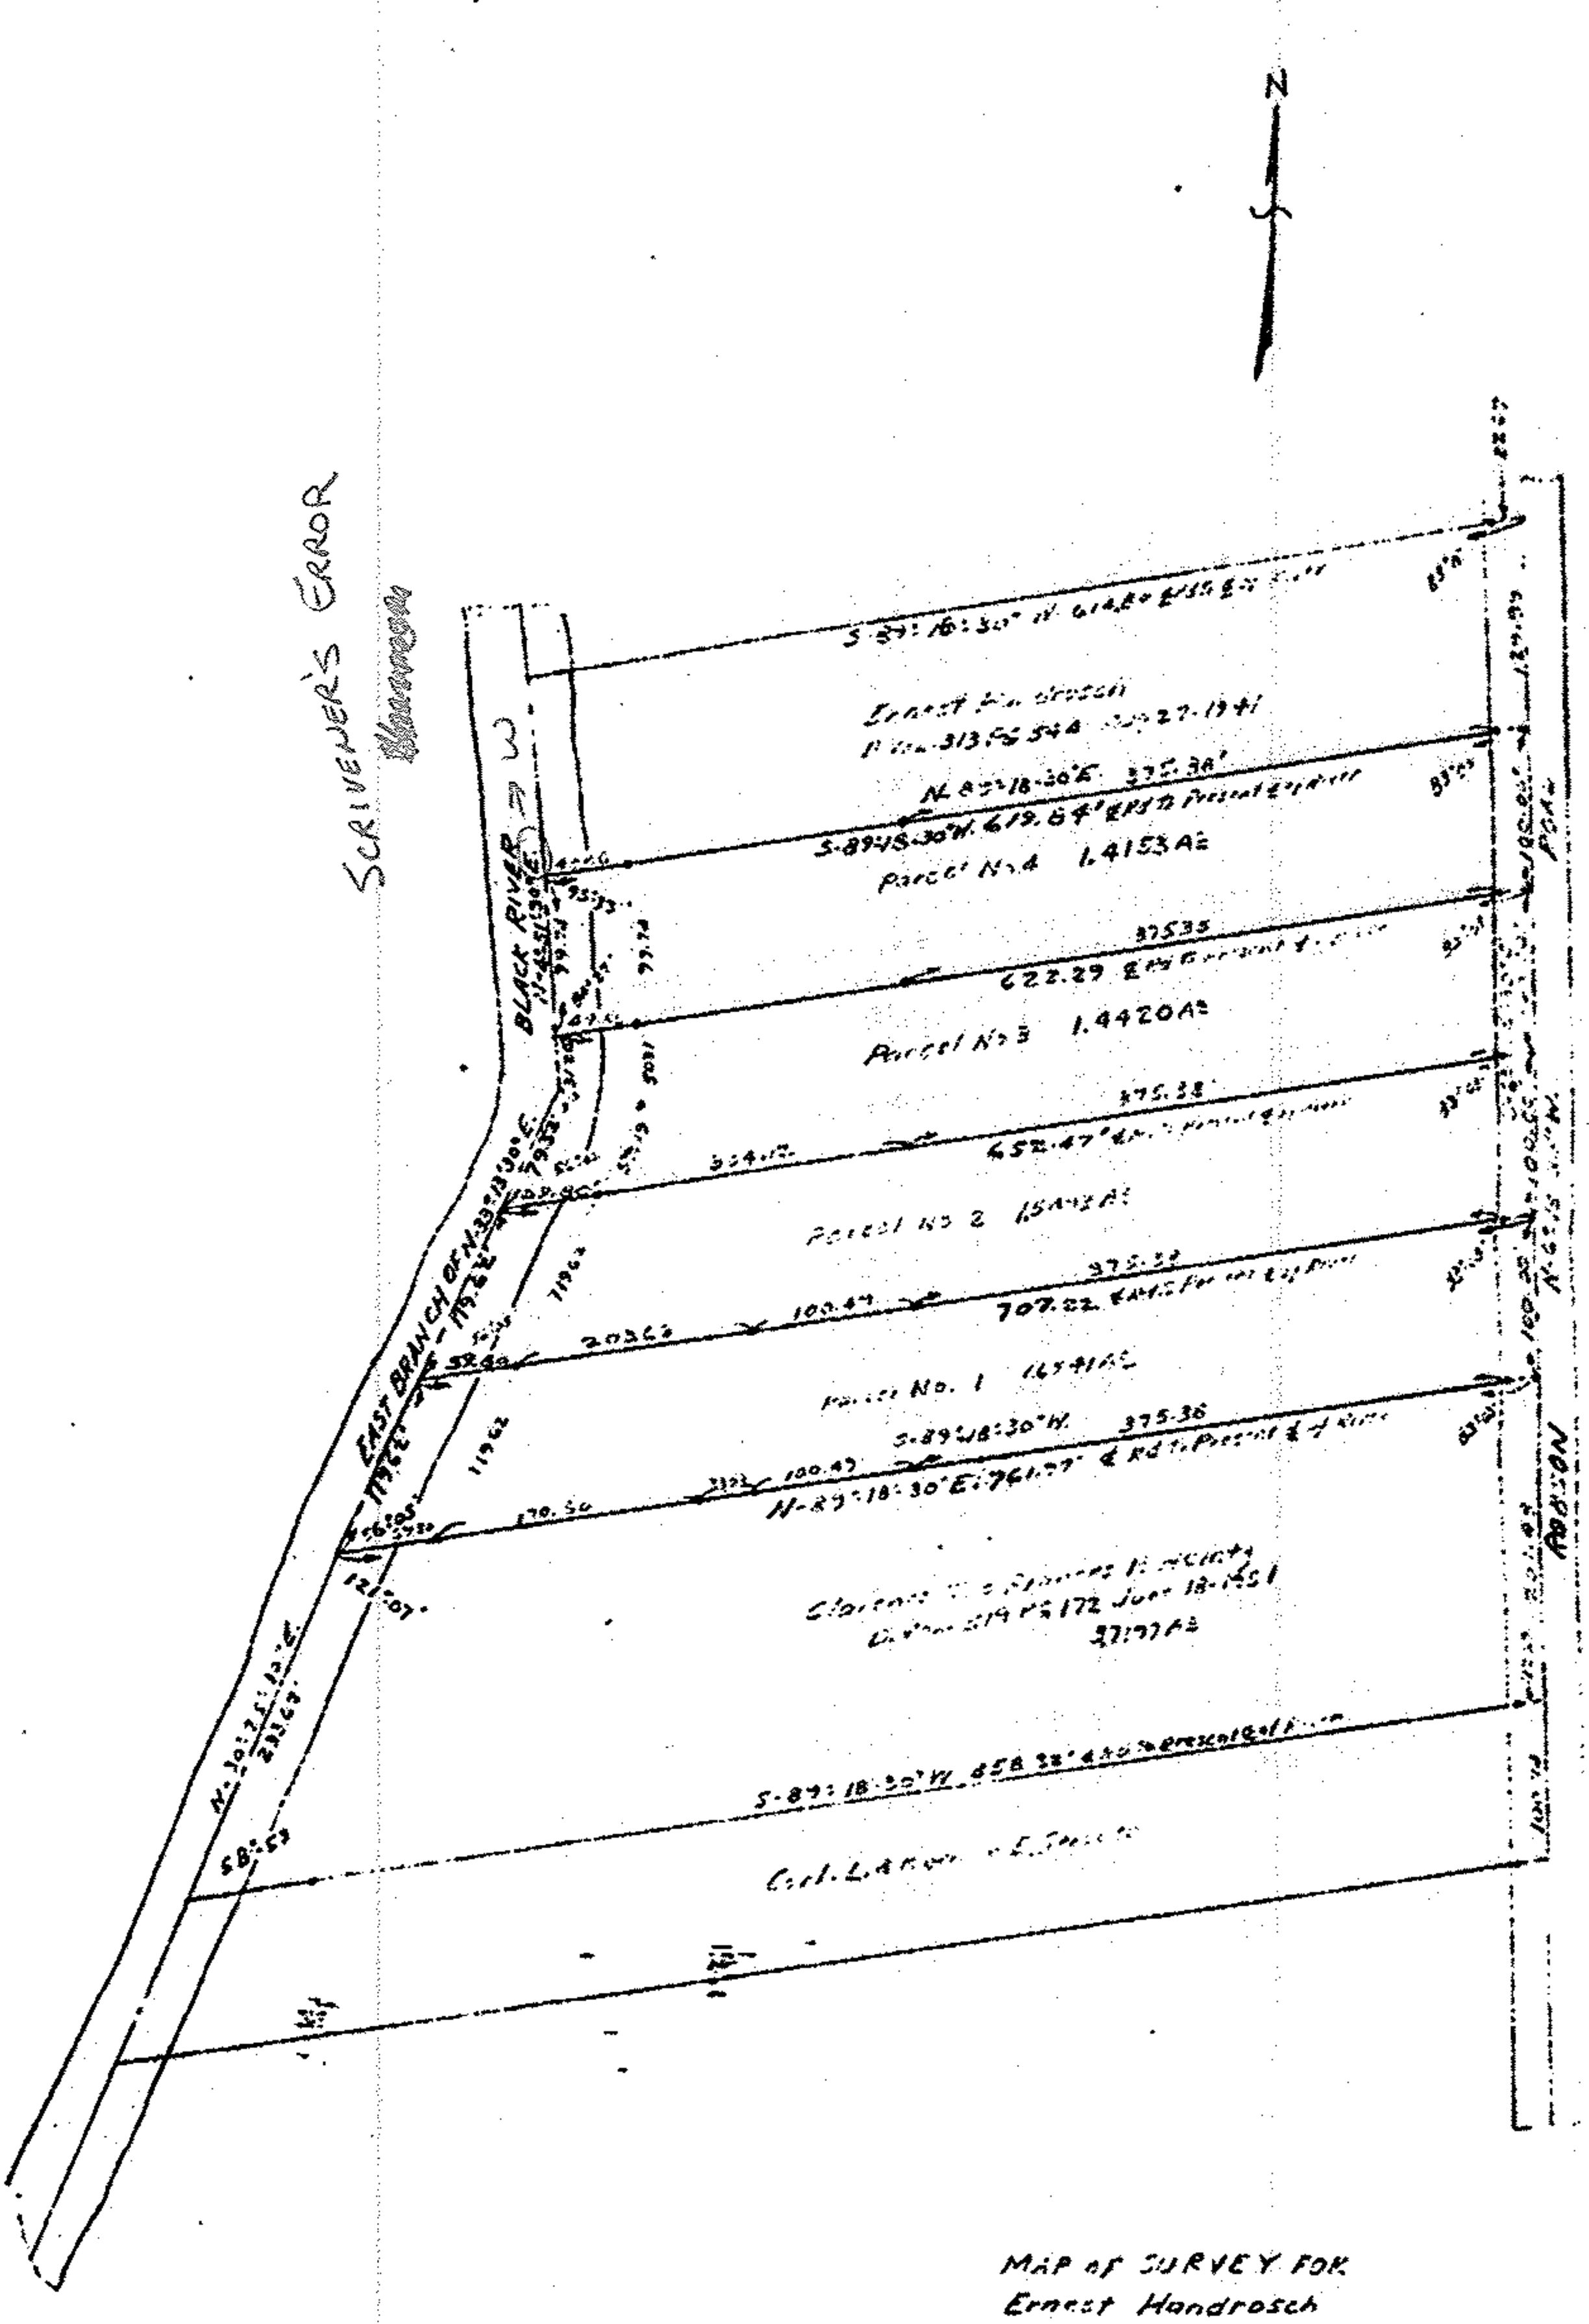

MAP of SURVEY FOR
Ernest Hondrosch
SECTION 15 CARLISLE TOWNSHIP
LORAIN COUNTY OHIO
SCALE 1" = 100' MAY 15-1953
C. E. Perfound Registered Surveyor