


05-00-087-000-002

Edwin W. Stang  
D. Vol. 295 Pg. 83  
D. Vol. 247 Pg. 496

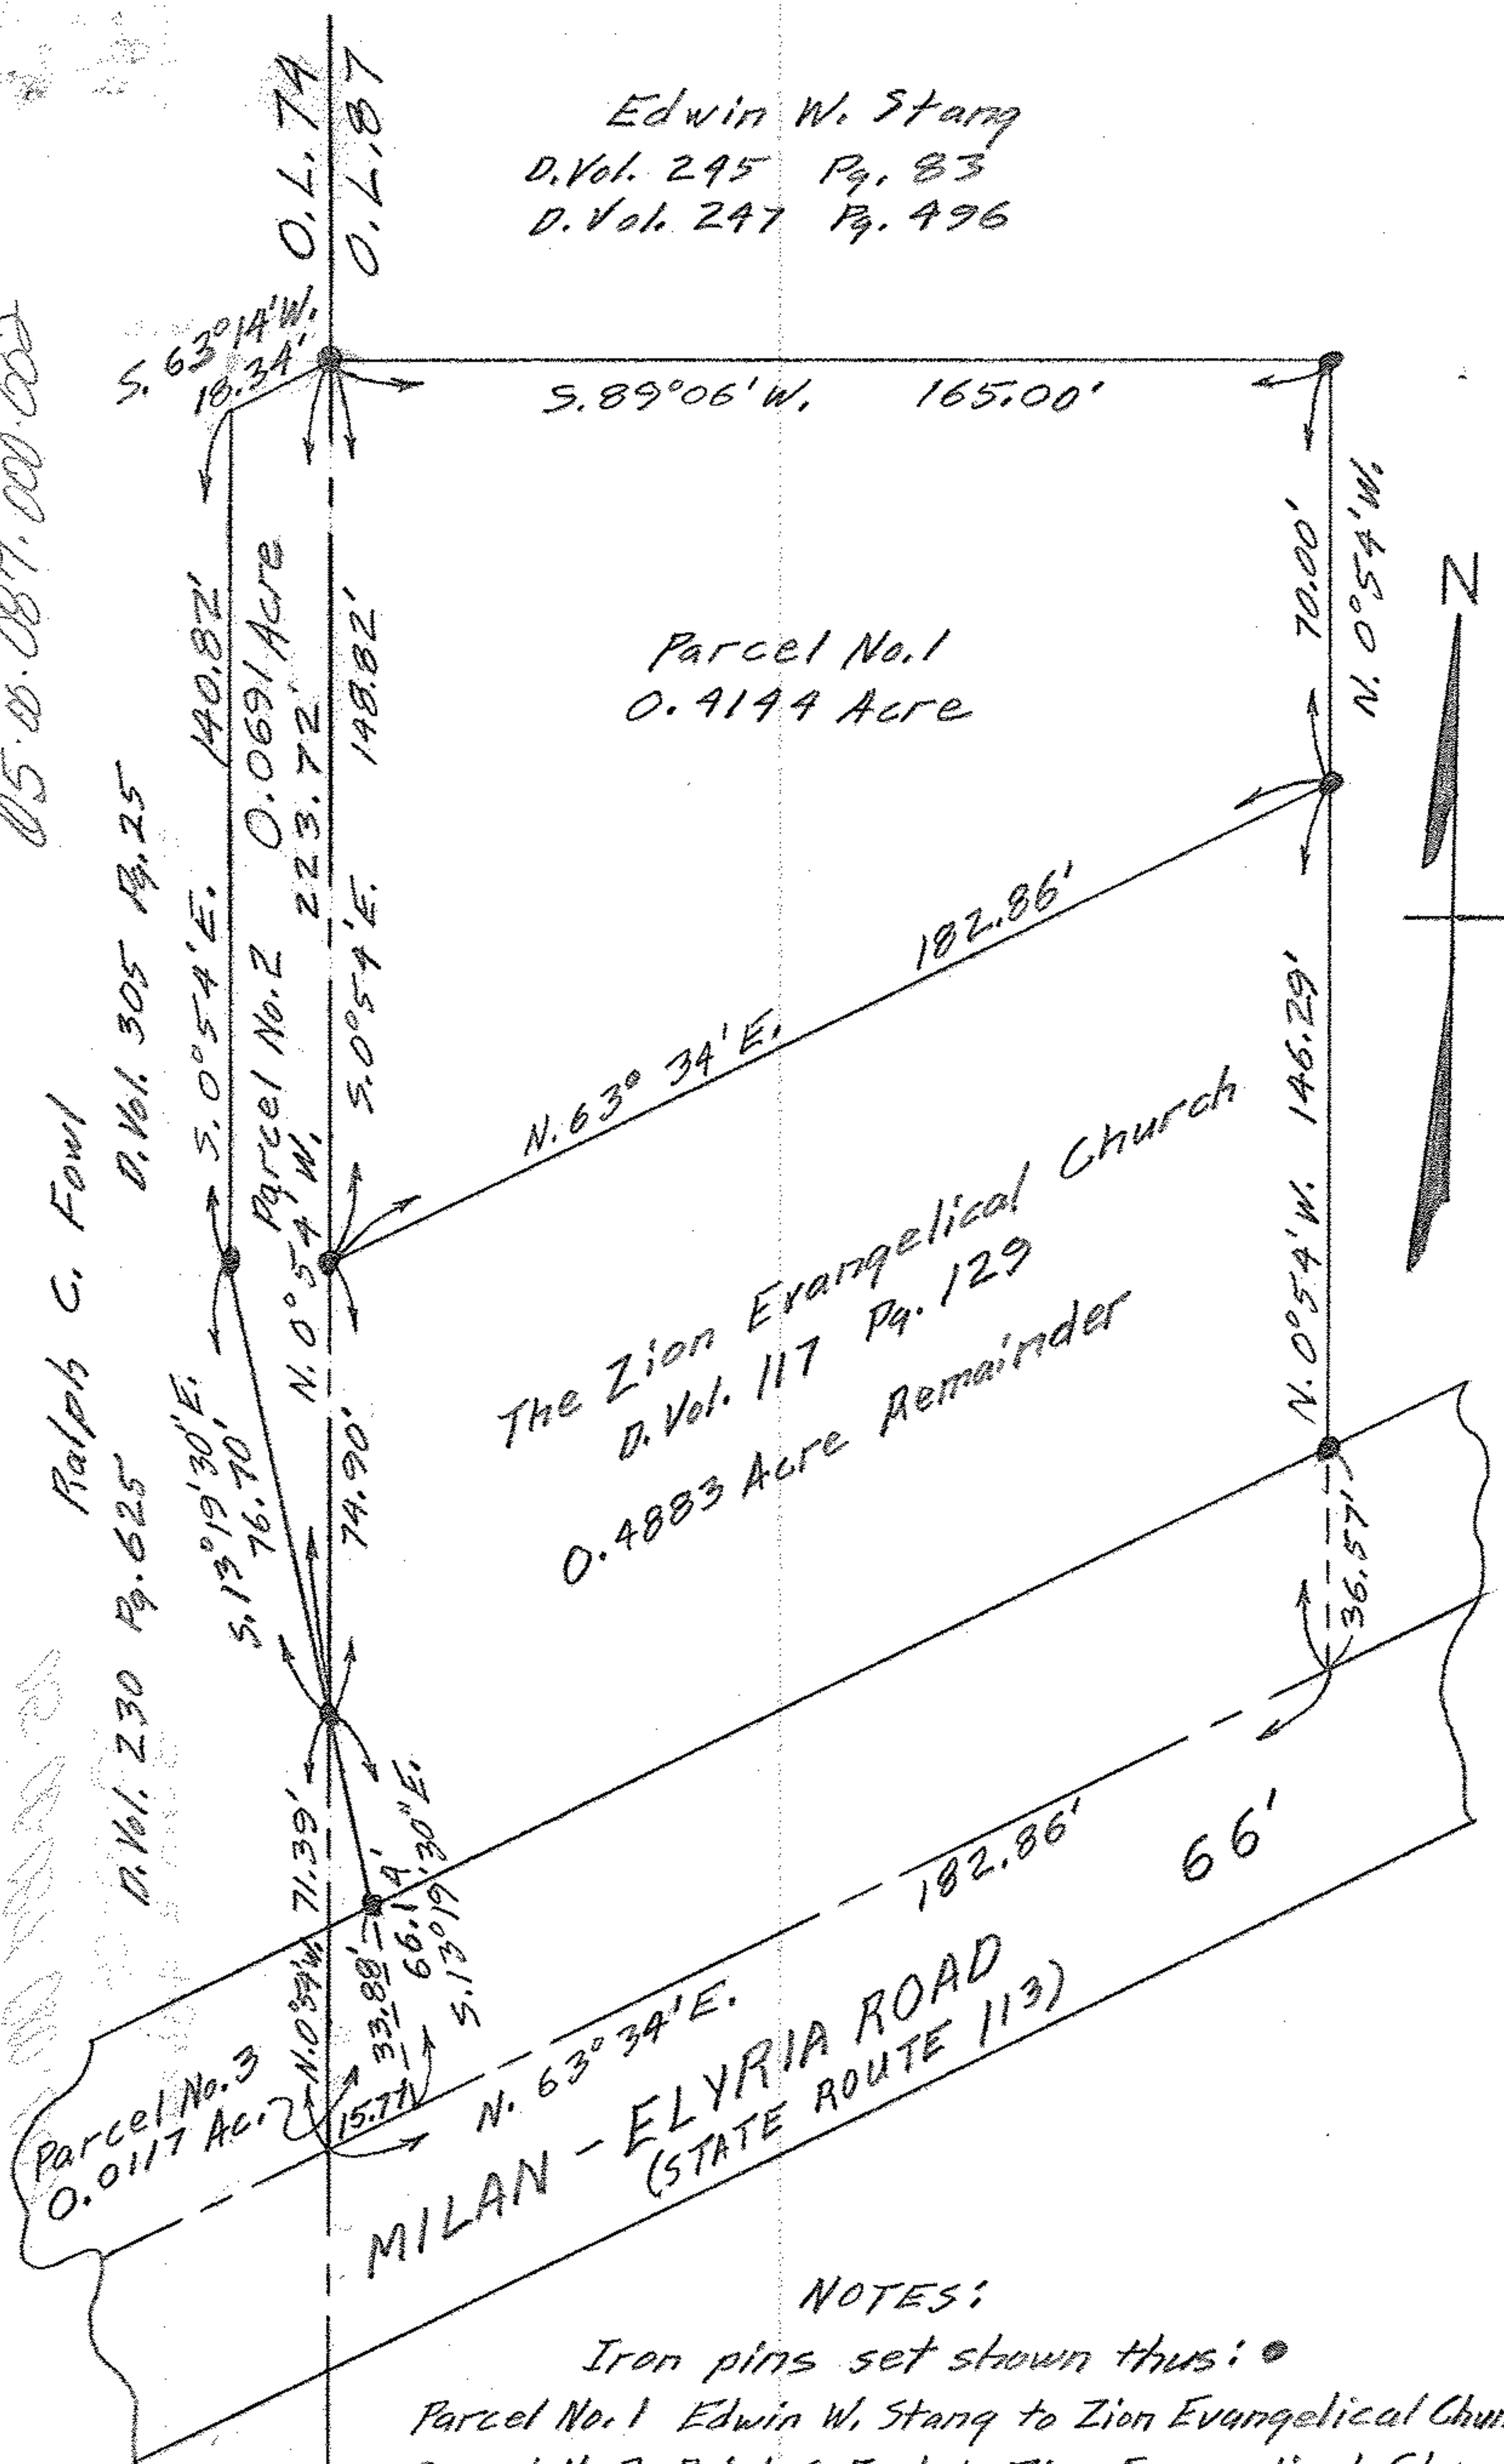

Ralph C. Fowl  
D. Vol. 305 Pg. 25

The Zion Evangelical Church  
D. Vol. 117 Pg. 129  
0.4883 Acre Remainder

PLAT OF SURVEY FOR THE ZION EVANGELICAL CHURCH,

EDWIN W. STANG, AND RALPH C. FOWL

ORIGINAL LOTS 87 & 74 AMHERST TOWNSHIP

LORAIN COUNTY

OHIO

JANUARY 9, 1958

SCALE: 1" = 40'

GARY E. PENFOLD REGISTERED SURVEYOR NO. 9457

05-00-087