K&E 19 1253 10-78 MC 8516

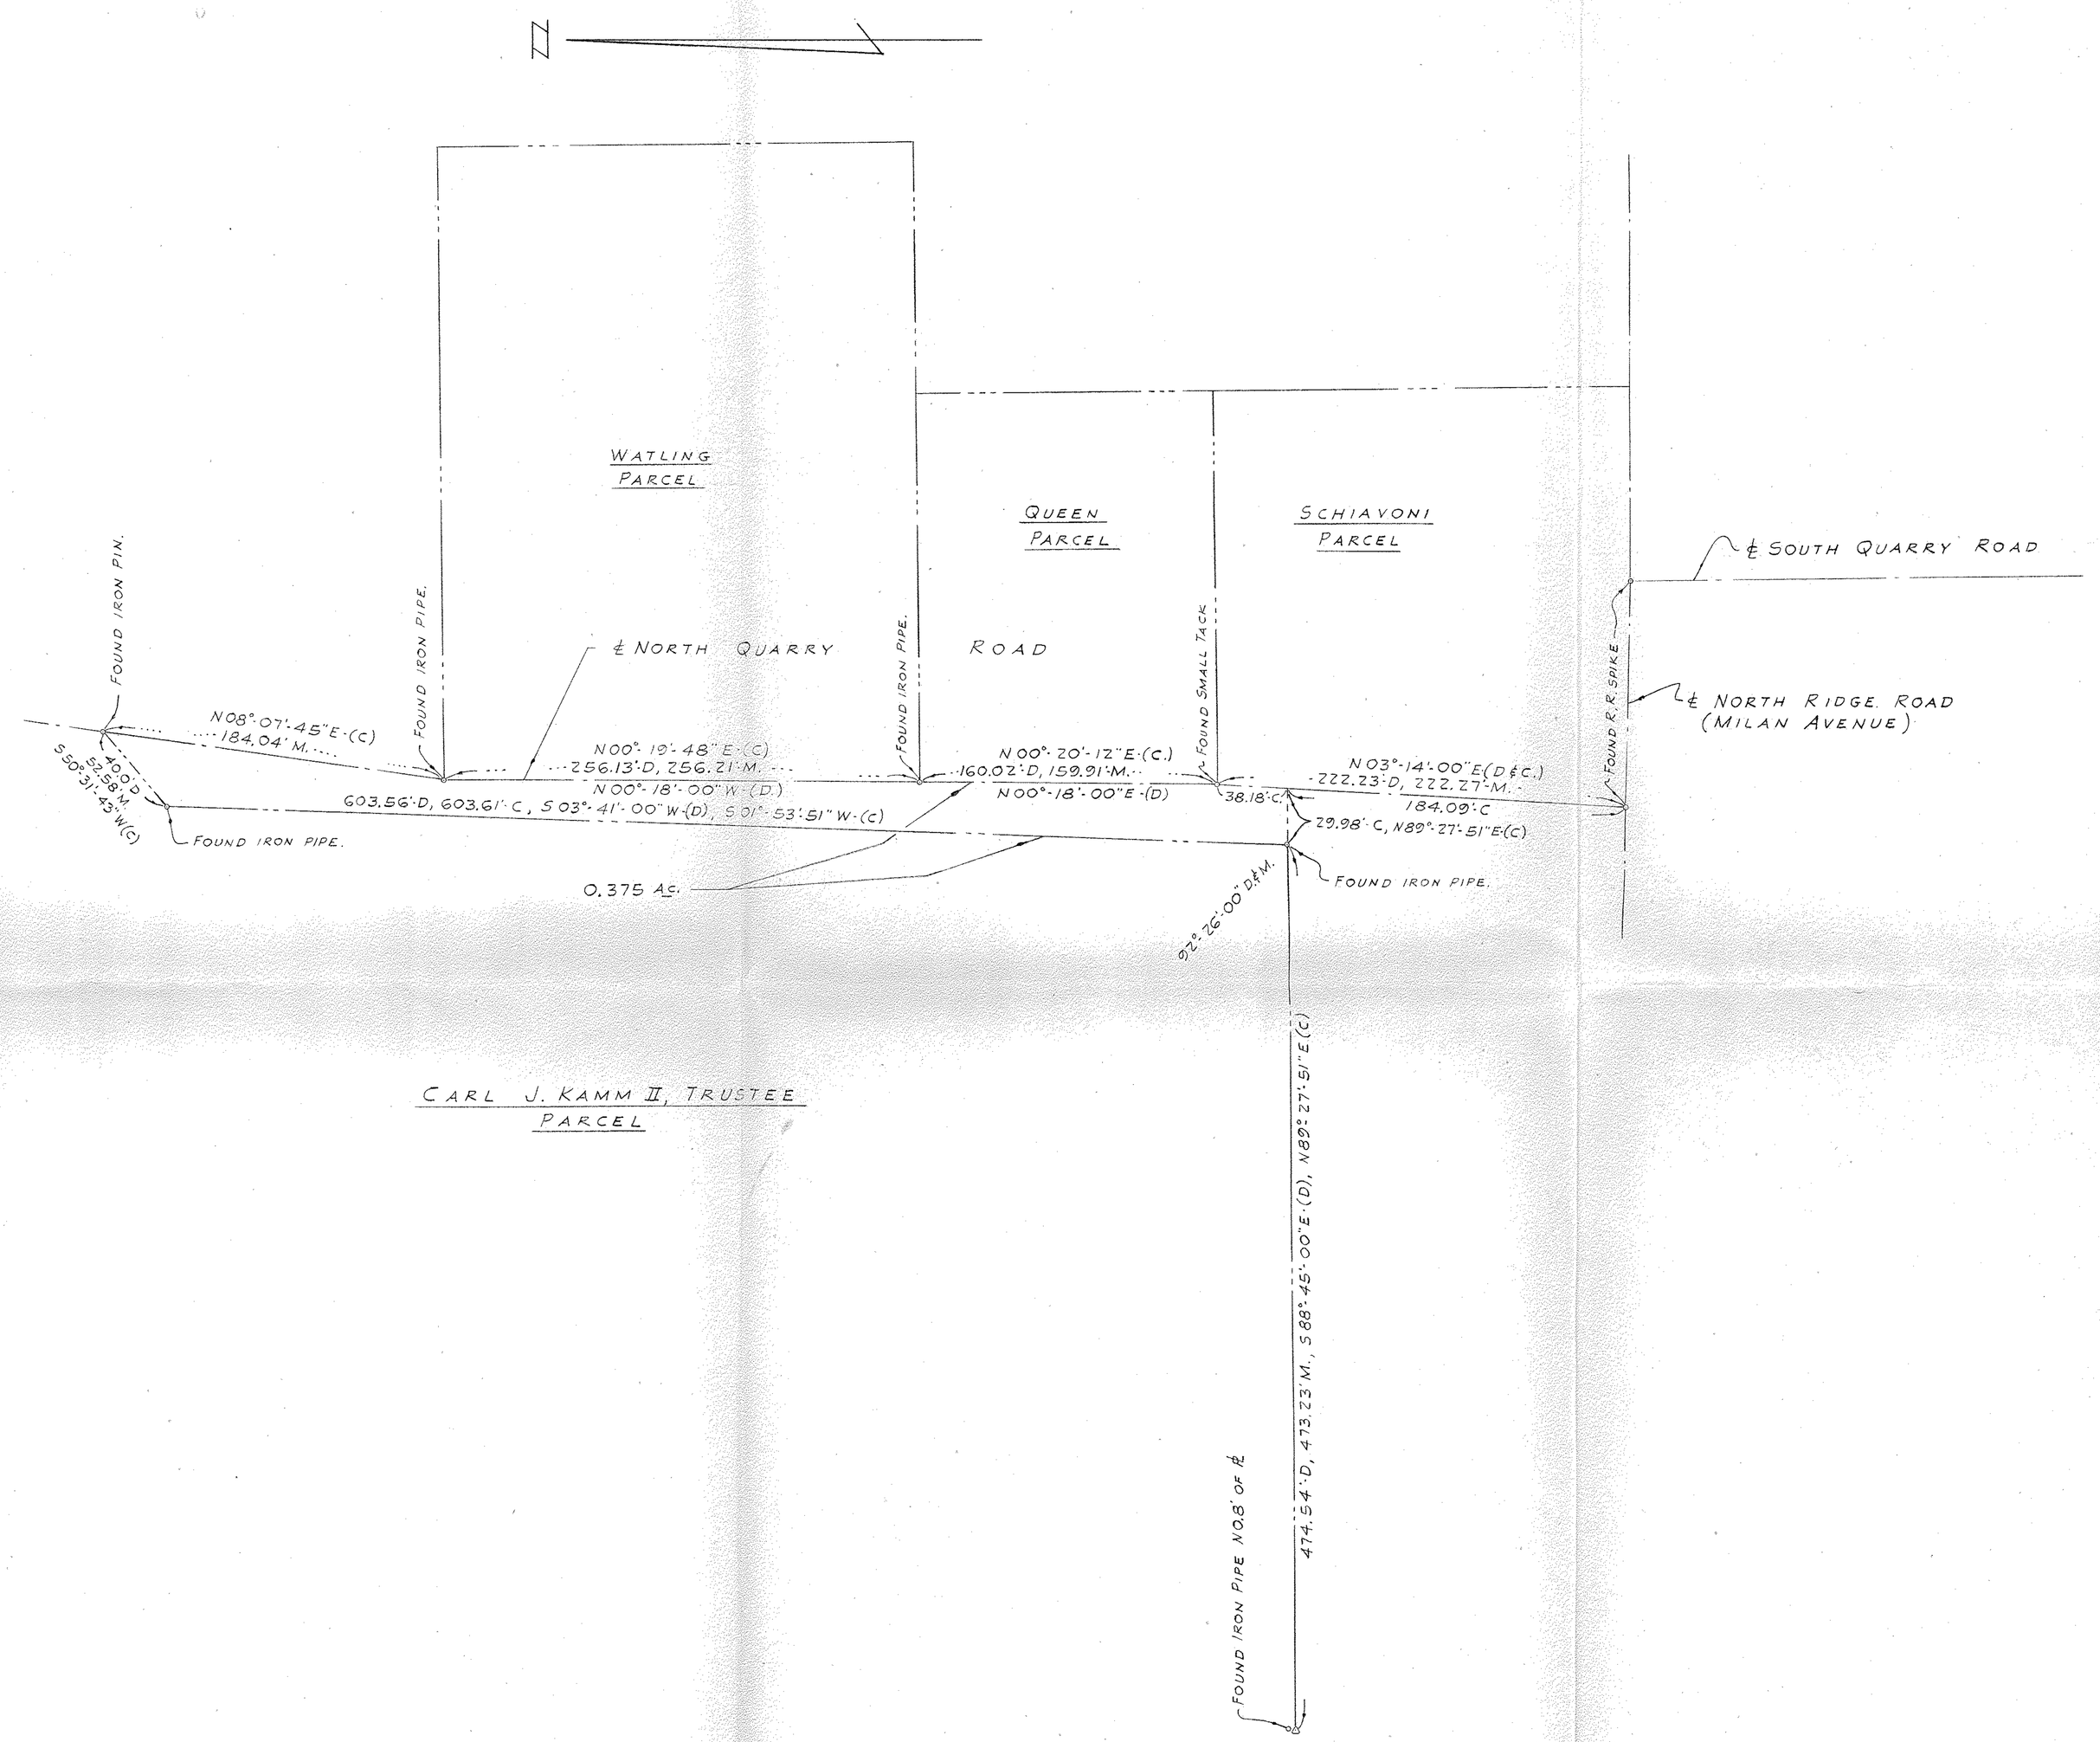

LEGEND

M.· MEASURED DISTANCE OR ANGLE.
D.· DEED DISTANCE OR ANGLE.
C.· CALCULATED DISTANCE OR ANGLE.
N· NORTH
S· SOUTH
E· EAST
W· WEST
AS.· ACRES
℄· CENTERLINE
RR. RAILROAD
⊥· PROPERTY LINE

DRAWING TO ACCOMPANY LEGAL DESCRIPTION OF PART OF ORIGINAL AMHERST TOWNSHIP LOT No. 98 IN THE CITY OF AMHERST, LORAIN COUNTY, OHIO,

FOR

THE CITY OF AMHERST, OHIO.

SCALE · 1" = 50'
JANUARY 30, 1979

McDONNELL PROUDFOOT & ASSOCIATES inc.
consulting engineers

5360 HEATHERDOWNS BLVD.
TOLEDO, OHIO 43614

78/229 | M-79-4