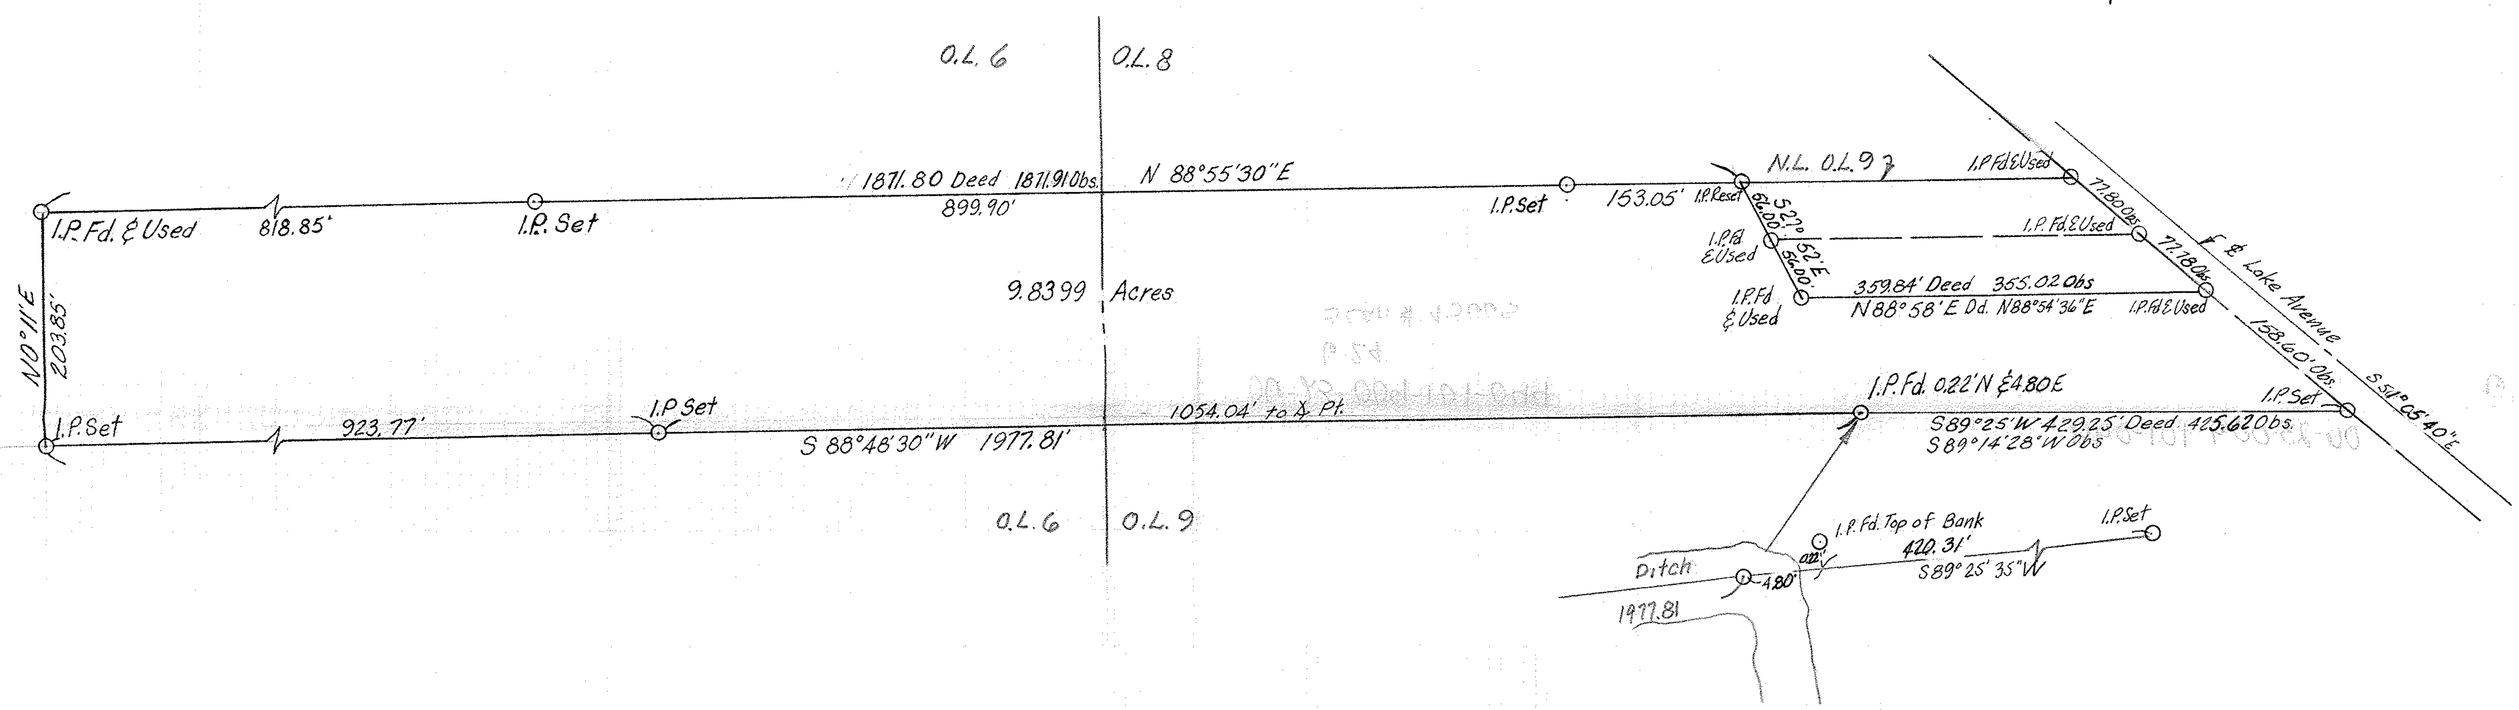

Note: ℄ Lake Avenue as originally surveyed in 1946 was not the true centerline; Lake Avenue currently has monuments for centerline control

STATE OF OHIO
LAWRENCE V. McGLINCHY
4970
REGISTERED SURVEYOR

MAP OF SURVEY FOR
JAMES G. KELLY

ELYRIA TWP. O.L. 6 & 9 BRACE TRACT
6528 LAKE AVE. ELYRIA, O.

McGLINCHY & ASSOCIATES

JULY 1, 1974 #7434
1"=100' LVM

Rev. AUGUST 9, 1974