06-23-012-105-021, 020, 043

6-28

SCAN # 45669

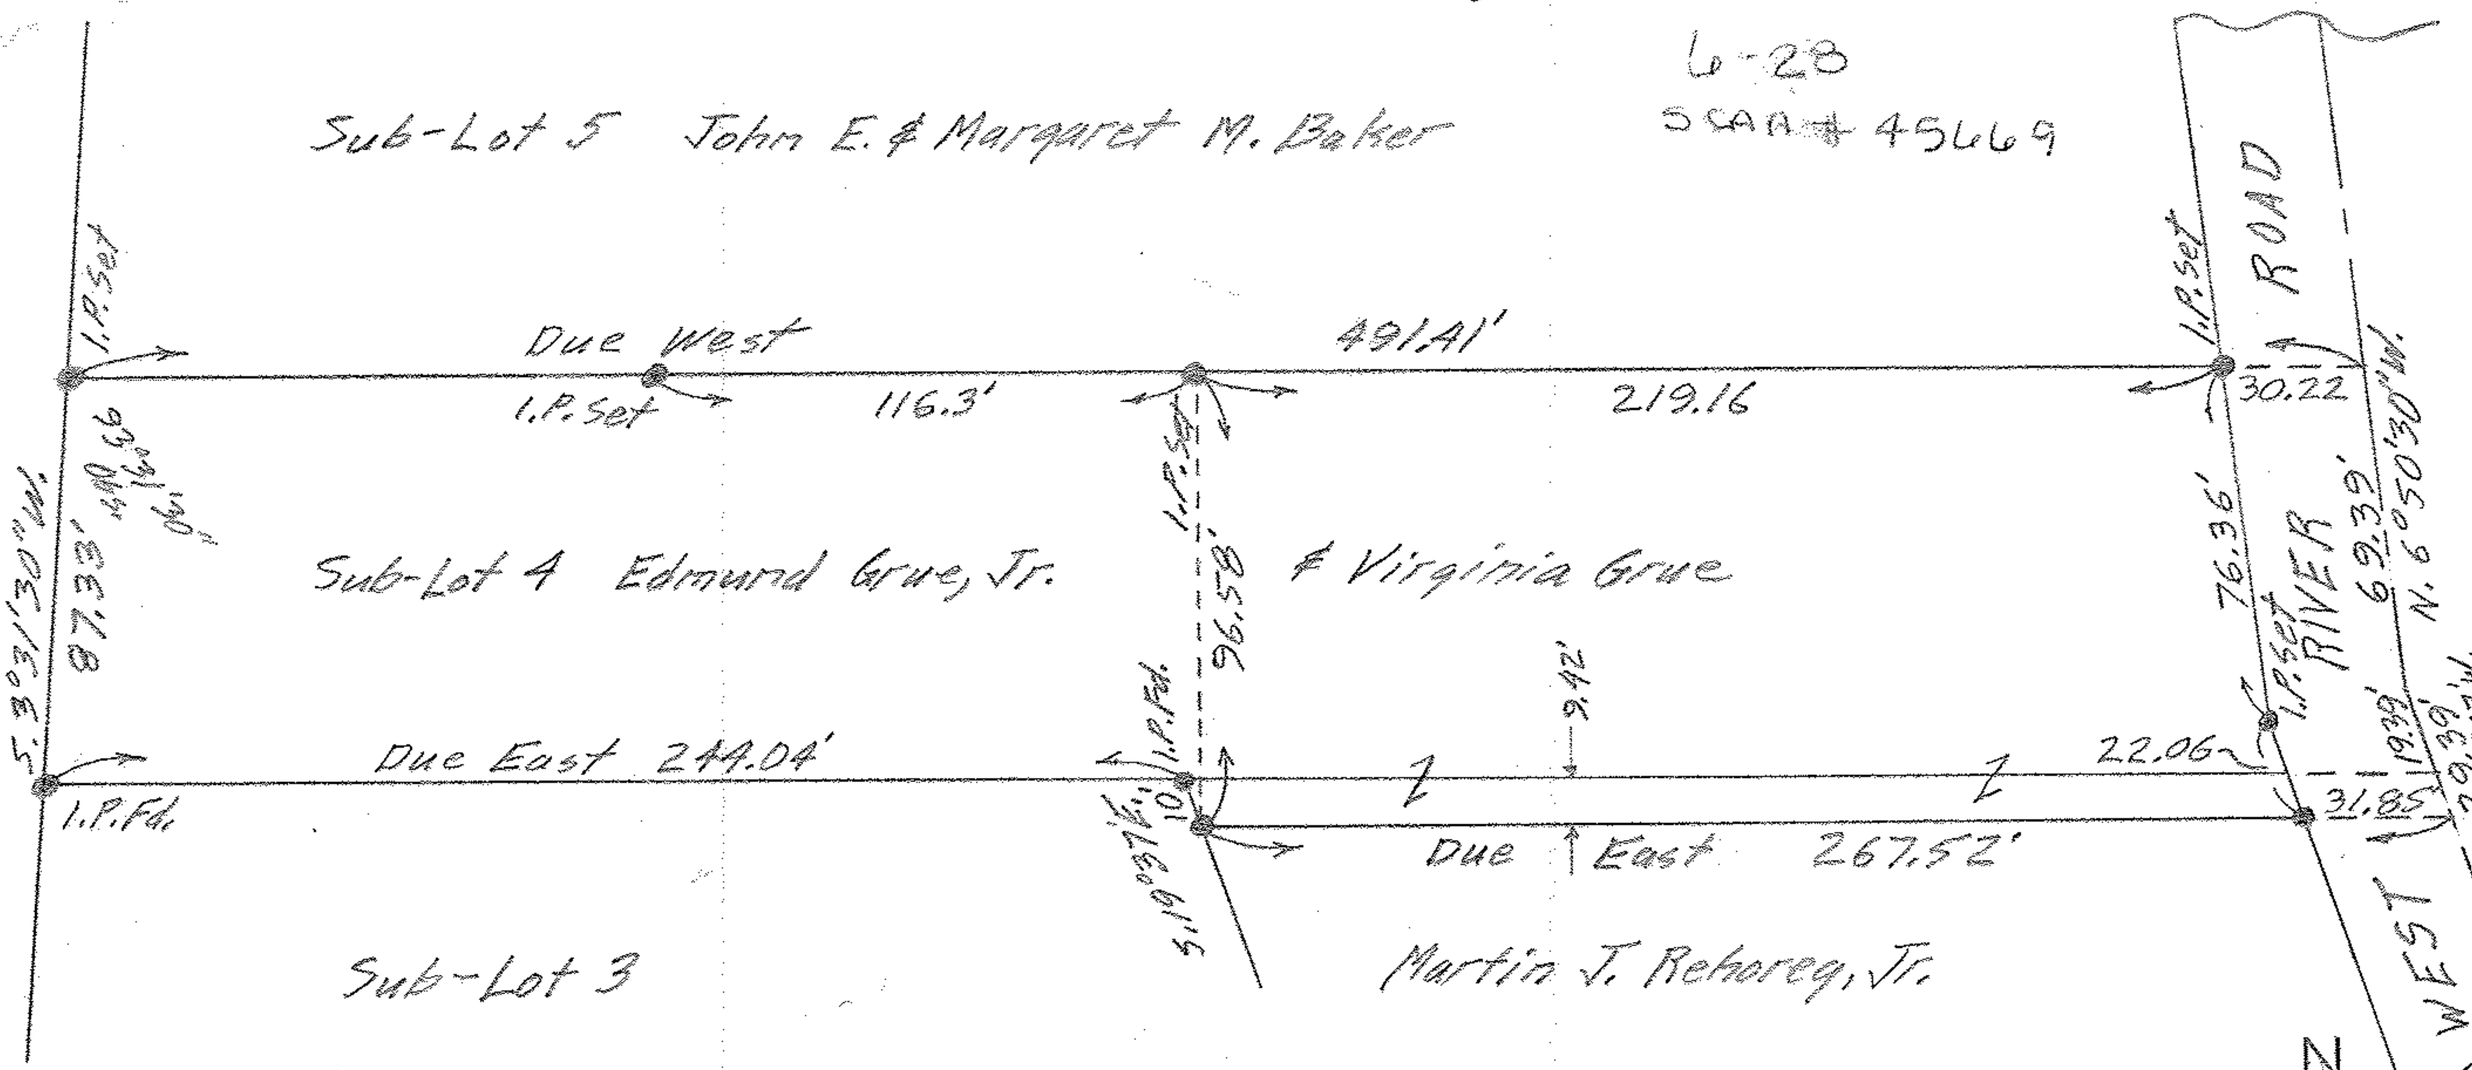

MAP OF SURVEY OF LINE BETWEEN SUB-LOTS 4 & 5
INTERURBAN ALLOTMENT Vol. 5 Pg. 29 PLATS
ORIGINAL LOT 12 BRACE TRACT ELYRIA TWP.
LORAIN COUNTY OHIO
SCALE: 1"=50' MAY 20-1959
GARY E. PENFOUND REGISTERED SURVEYOR NO. 4957