06-23-016-102-008

6-46

SCAN # 45671

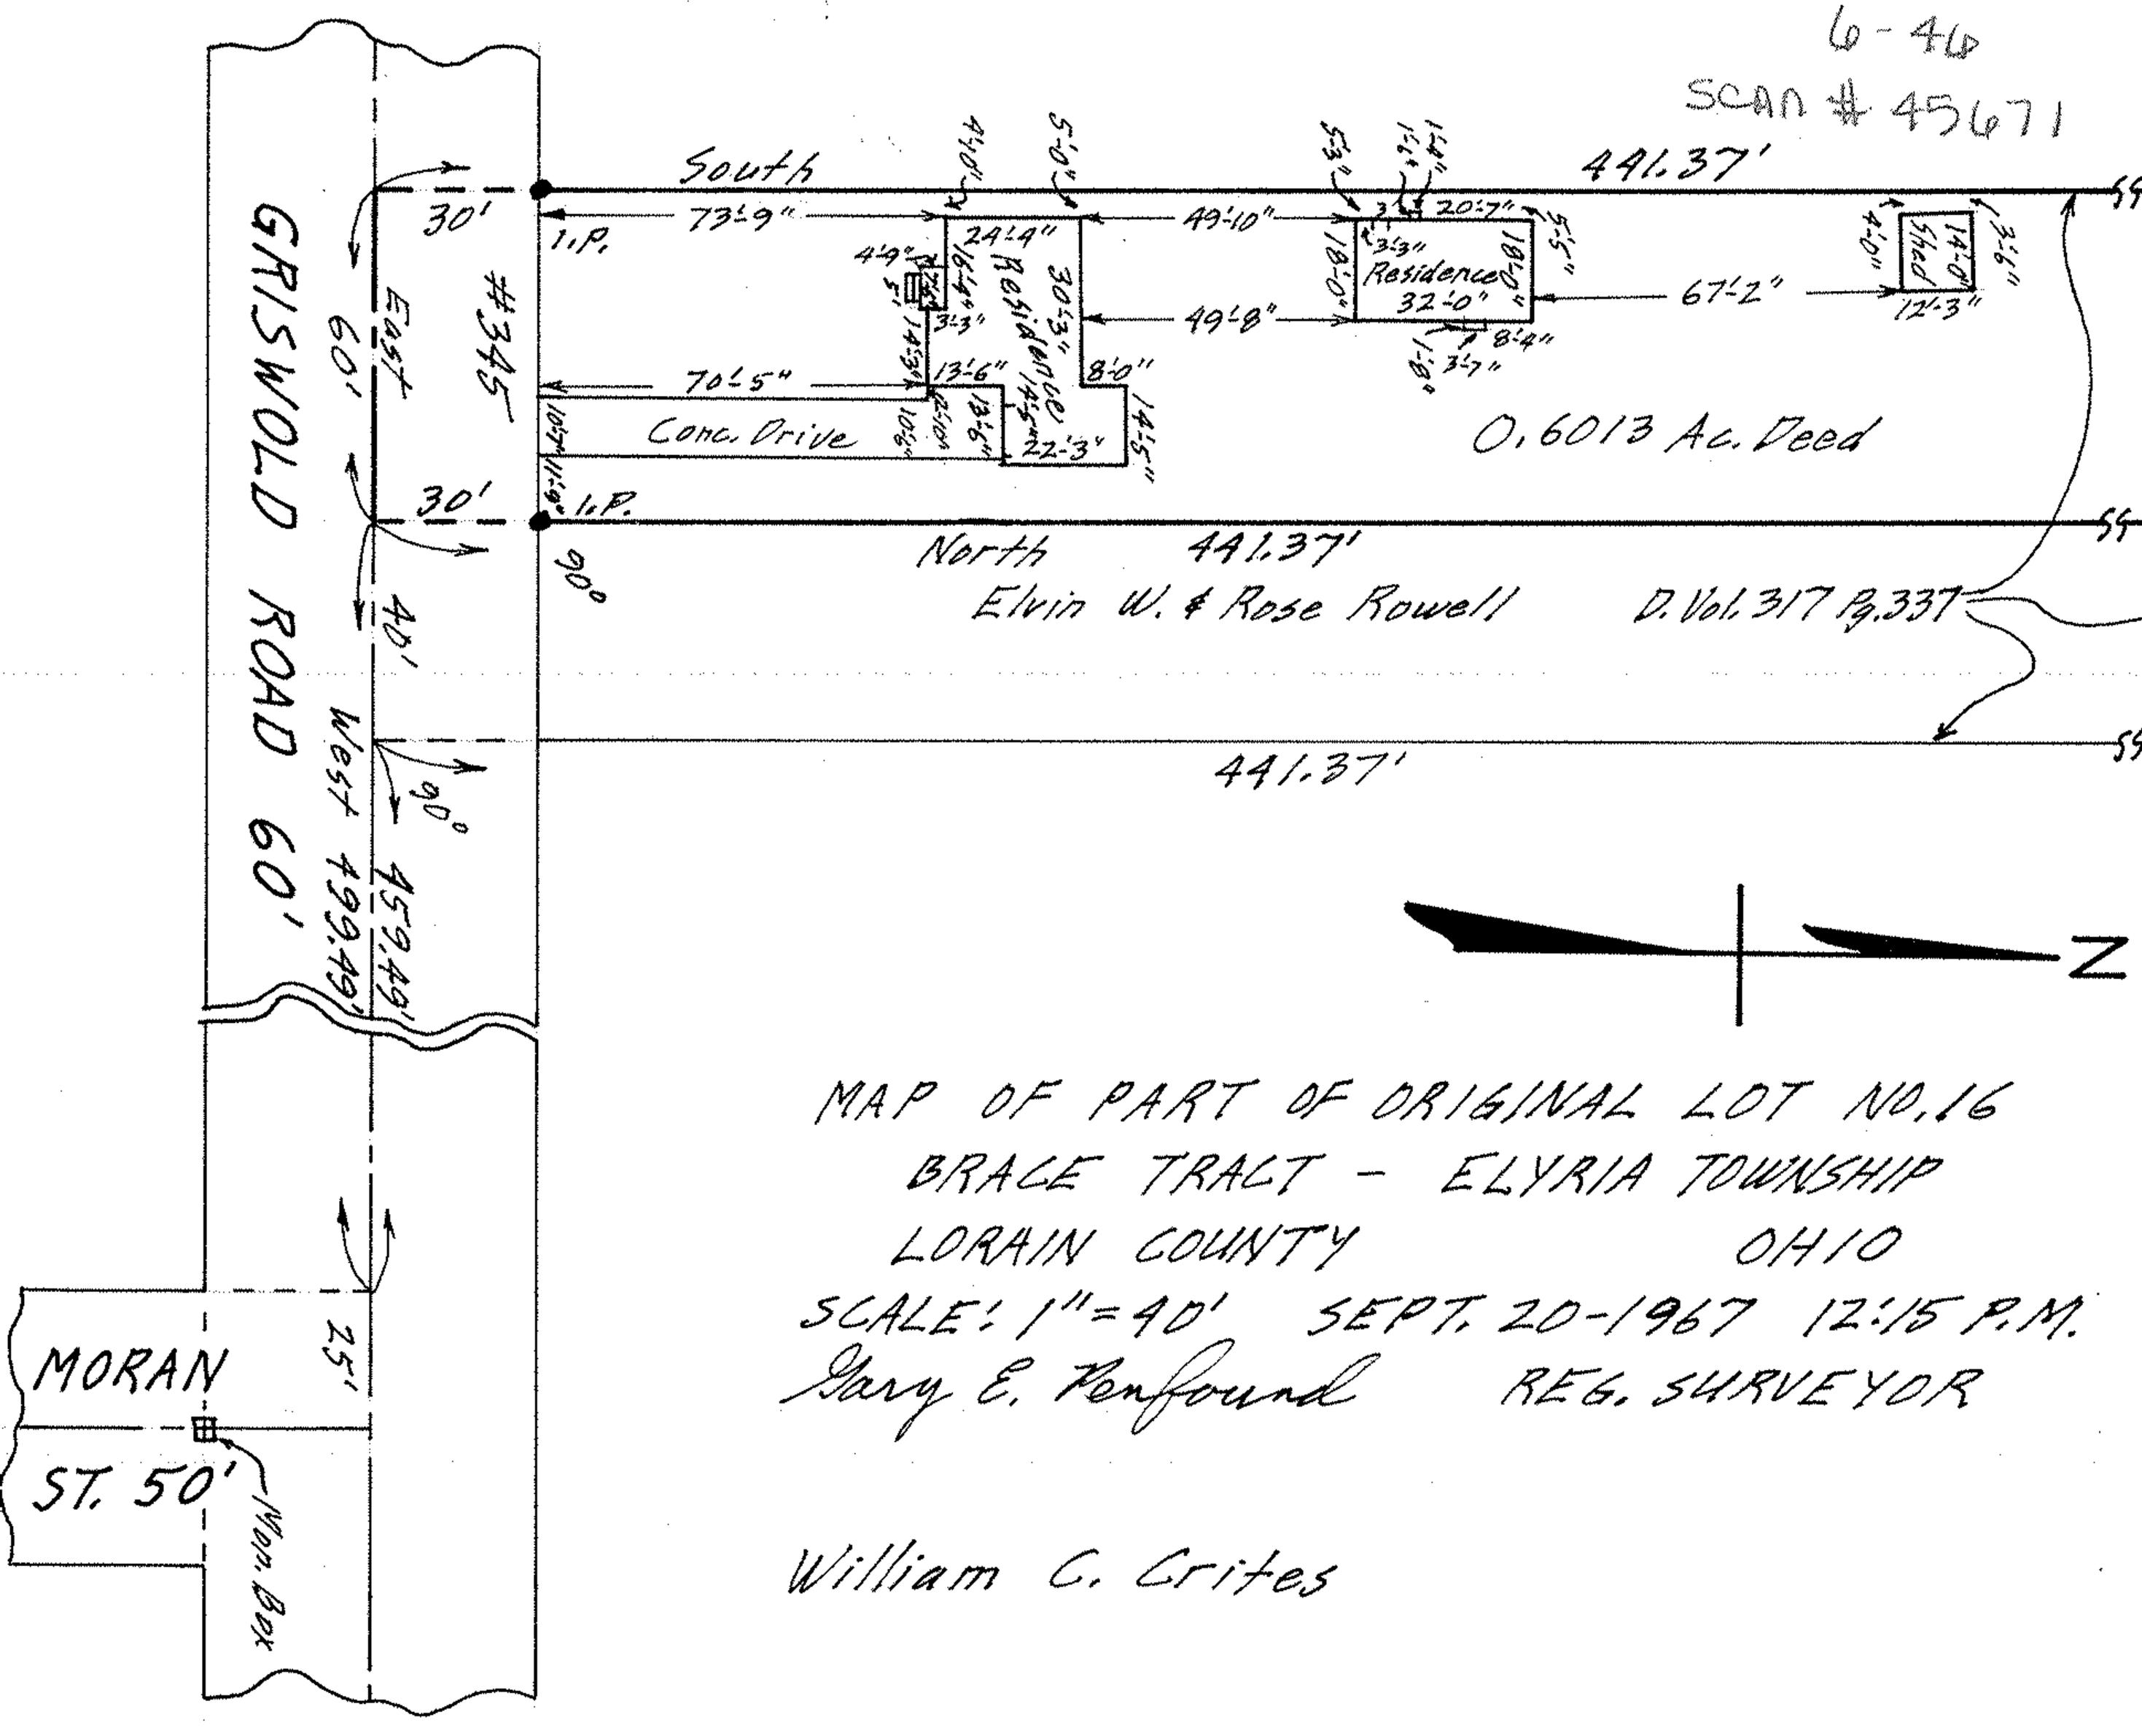

MAP OF PART OF ORIGINAL LOT NO. 16

BRACE TRACT - ELYRIA TOWNSHIP

LORAIN COUNTY OHIO

SCALE: 1"=40' SEPT. 20-1967 12:15 P.M.

Gary E. Penfound REG. SURVEYOR

William C. Crites