Scan # 45481 06-24-004-000-007
6-112

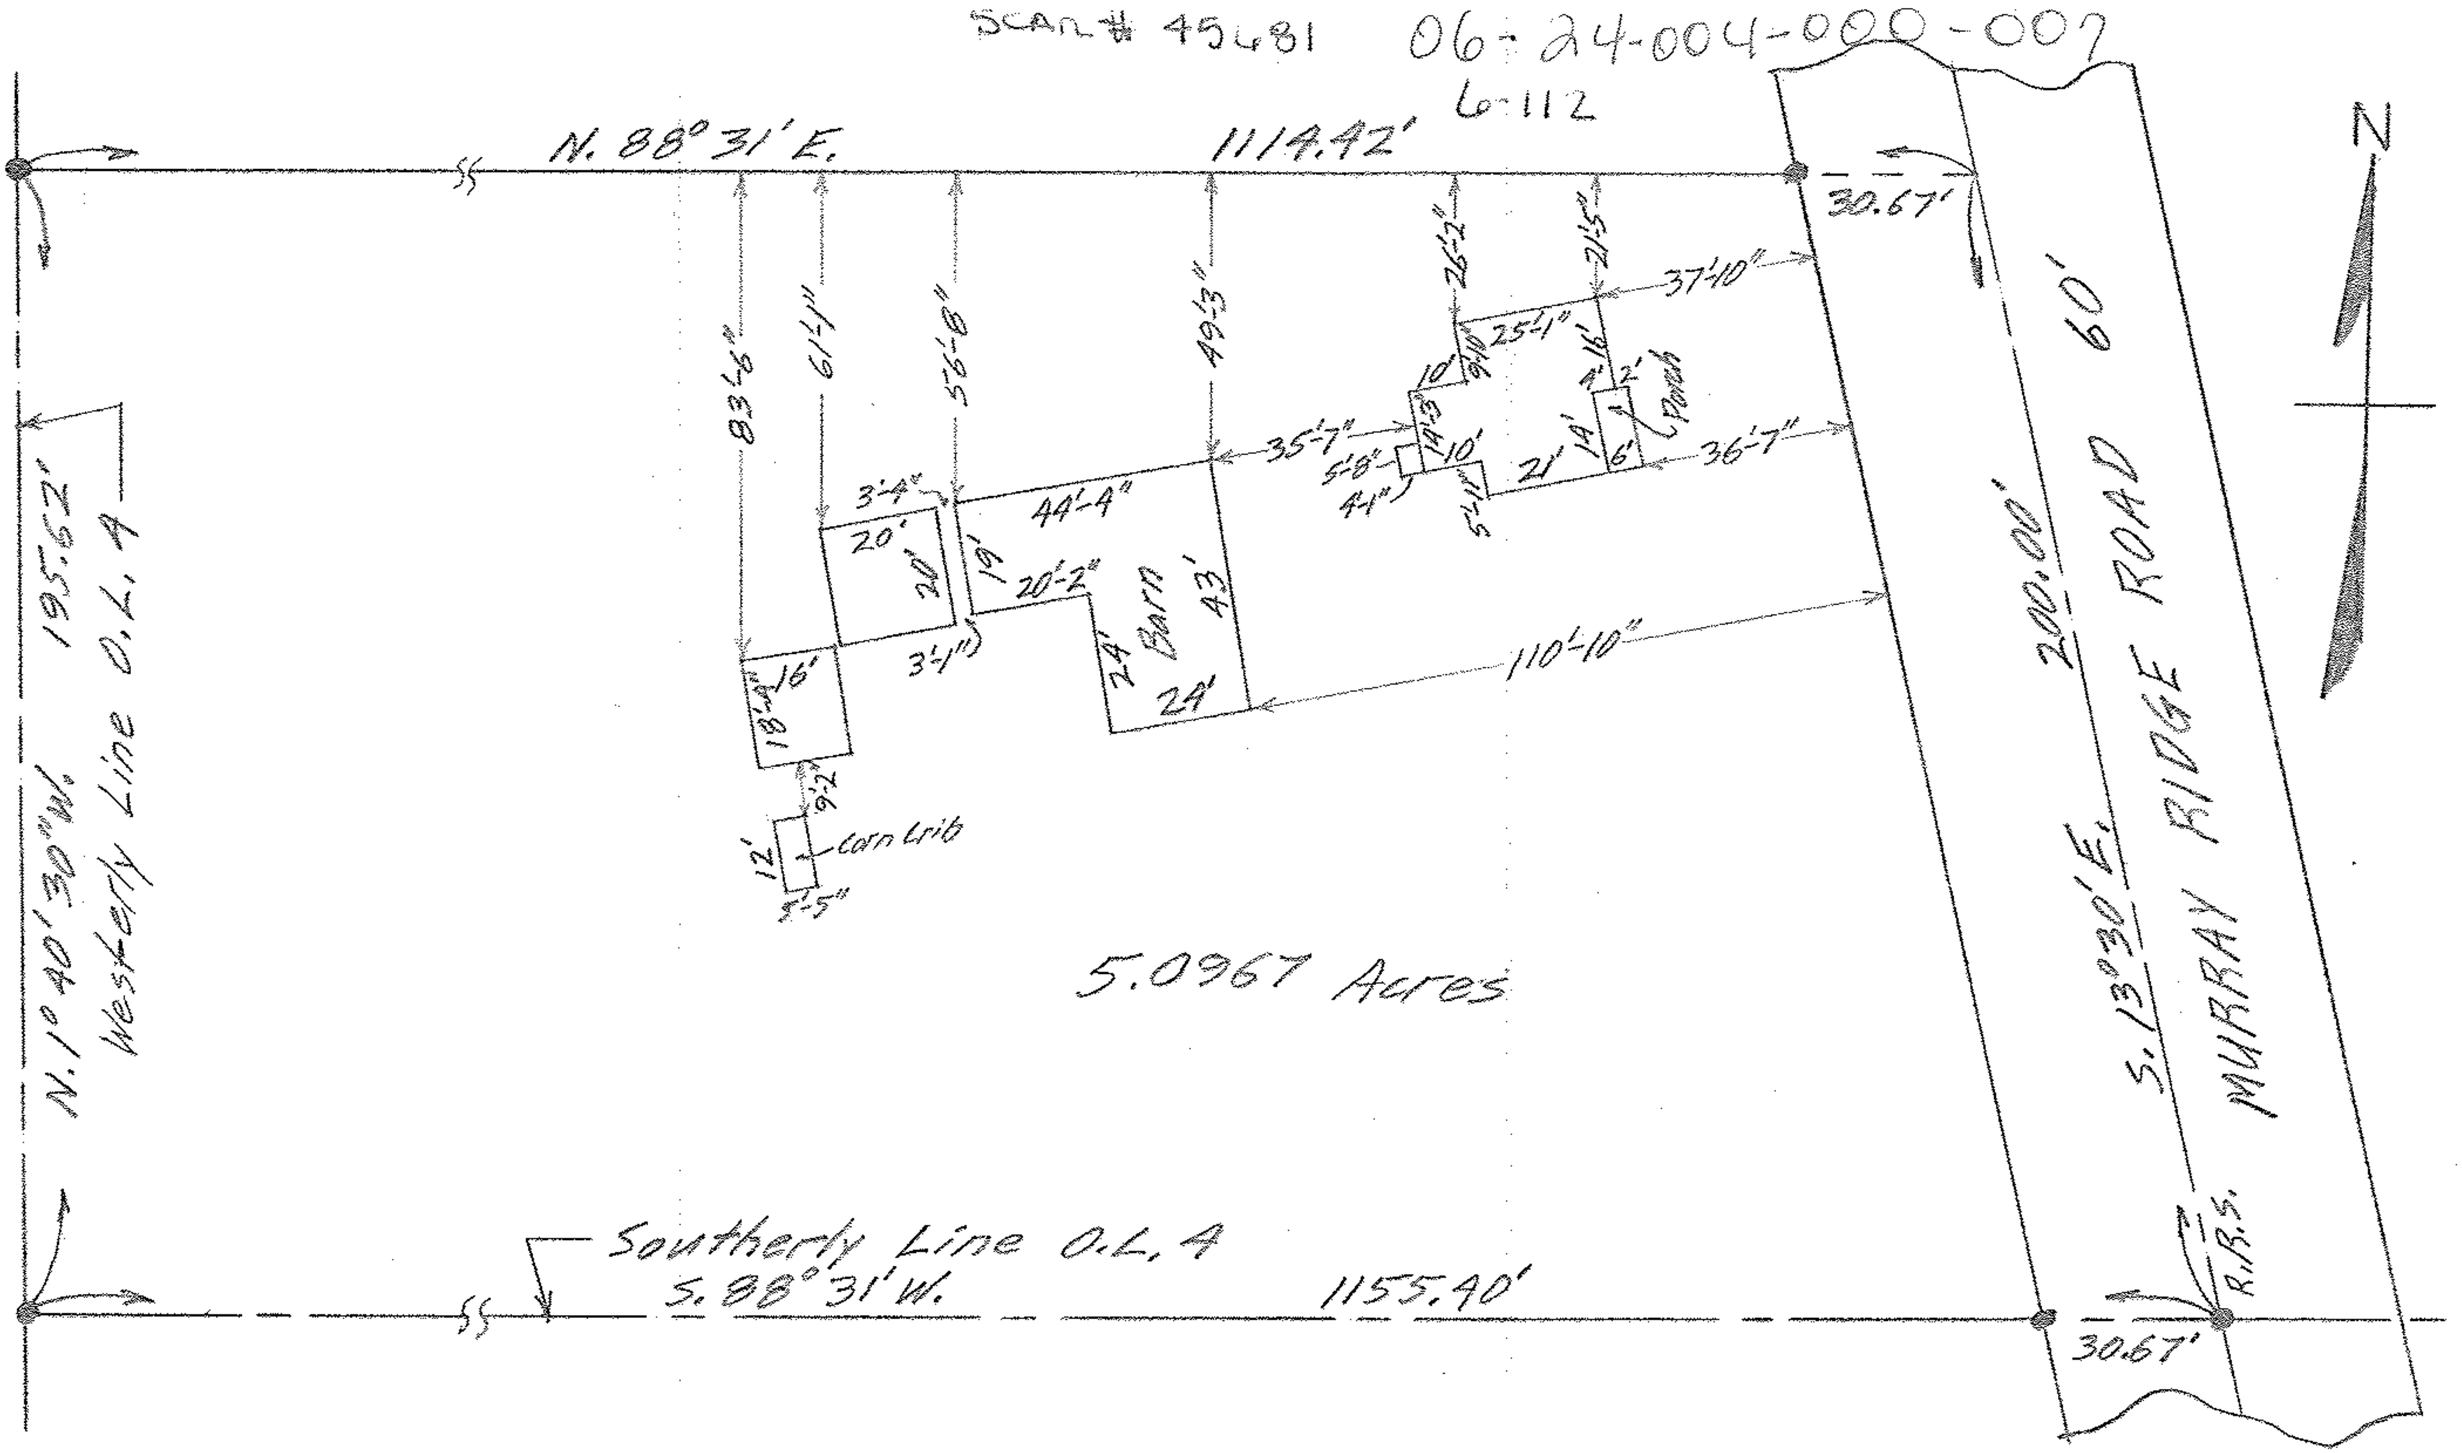

5.0967 Acres

MAP OF PART OF ORIGINAL LOT 4 — WEST OF RIVER
ELYRIA TWP. LORAIN COUNTY OHIO
SCALE: 1" = 40' DEC. 12-1960 1:30 P.M.
Harry E. Penfound REG. SURVEYOR

Berkss Title Insurance Co. Order No. 765
Thomas E. & Beatrice M. Johnson