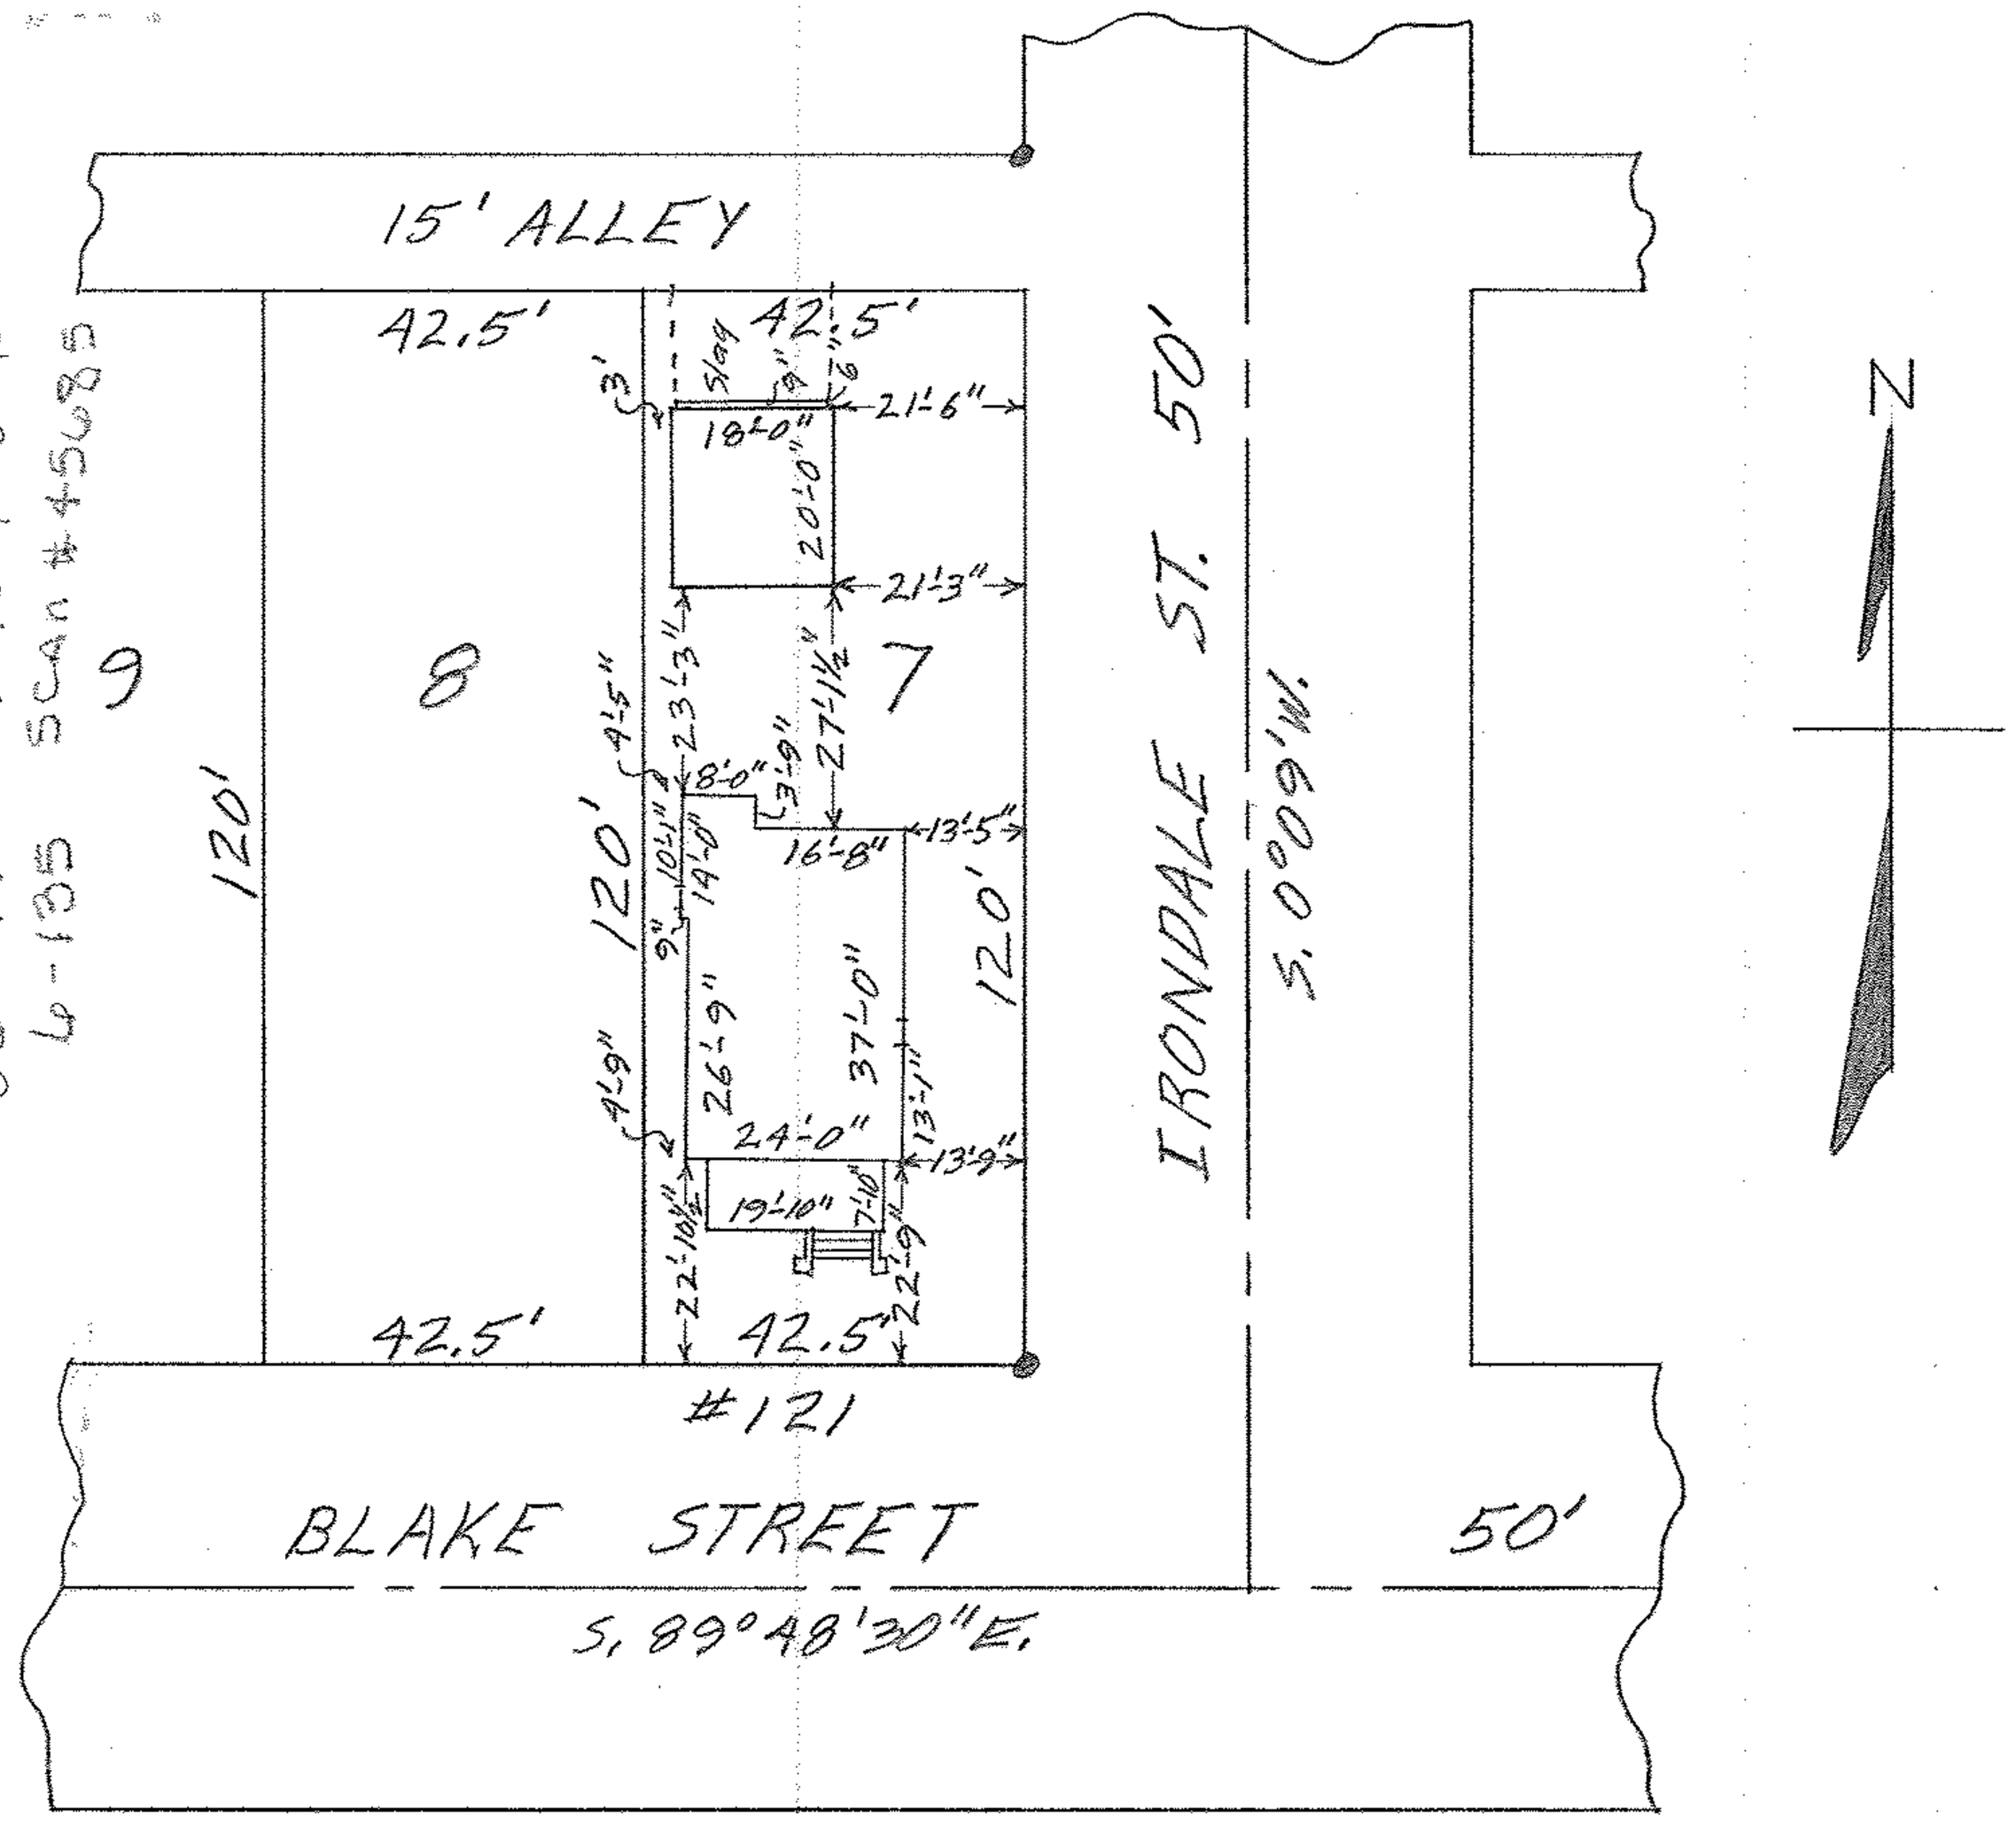

MAP OF SUB-LOT NO. 7

GUILFORD ALL'T. VOL. 11 PG. 31

O.L. 9 WEST OF RIVER ELYRIA TWP.

ELYRIA CITY - LORAIN COUNTY - OHIO

SCALE: 1"=30' APRIL 26-1964 6:00 P.M.

Gary E. Penfound
for C. E. Penfound
REG. SURVEYORS

E-13104 Buford & Ruth J. Shores