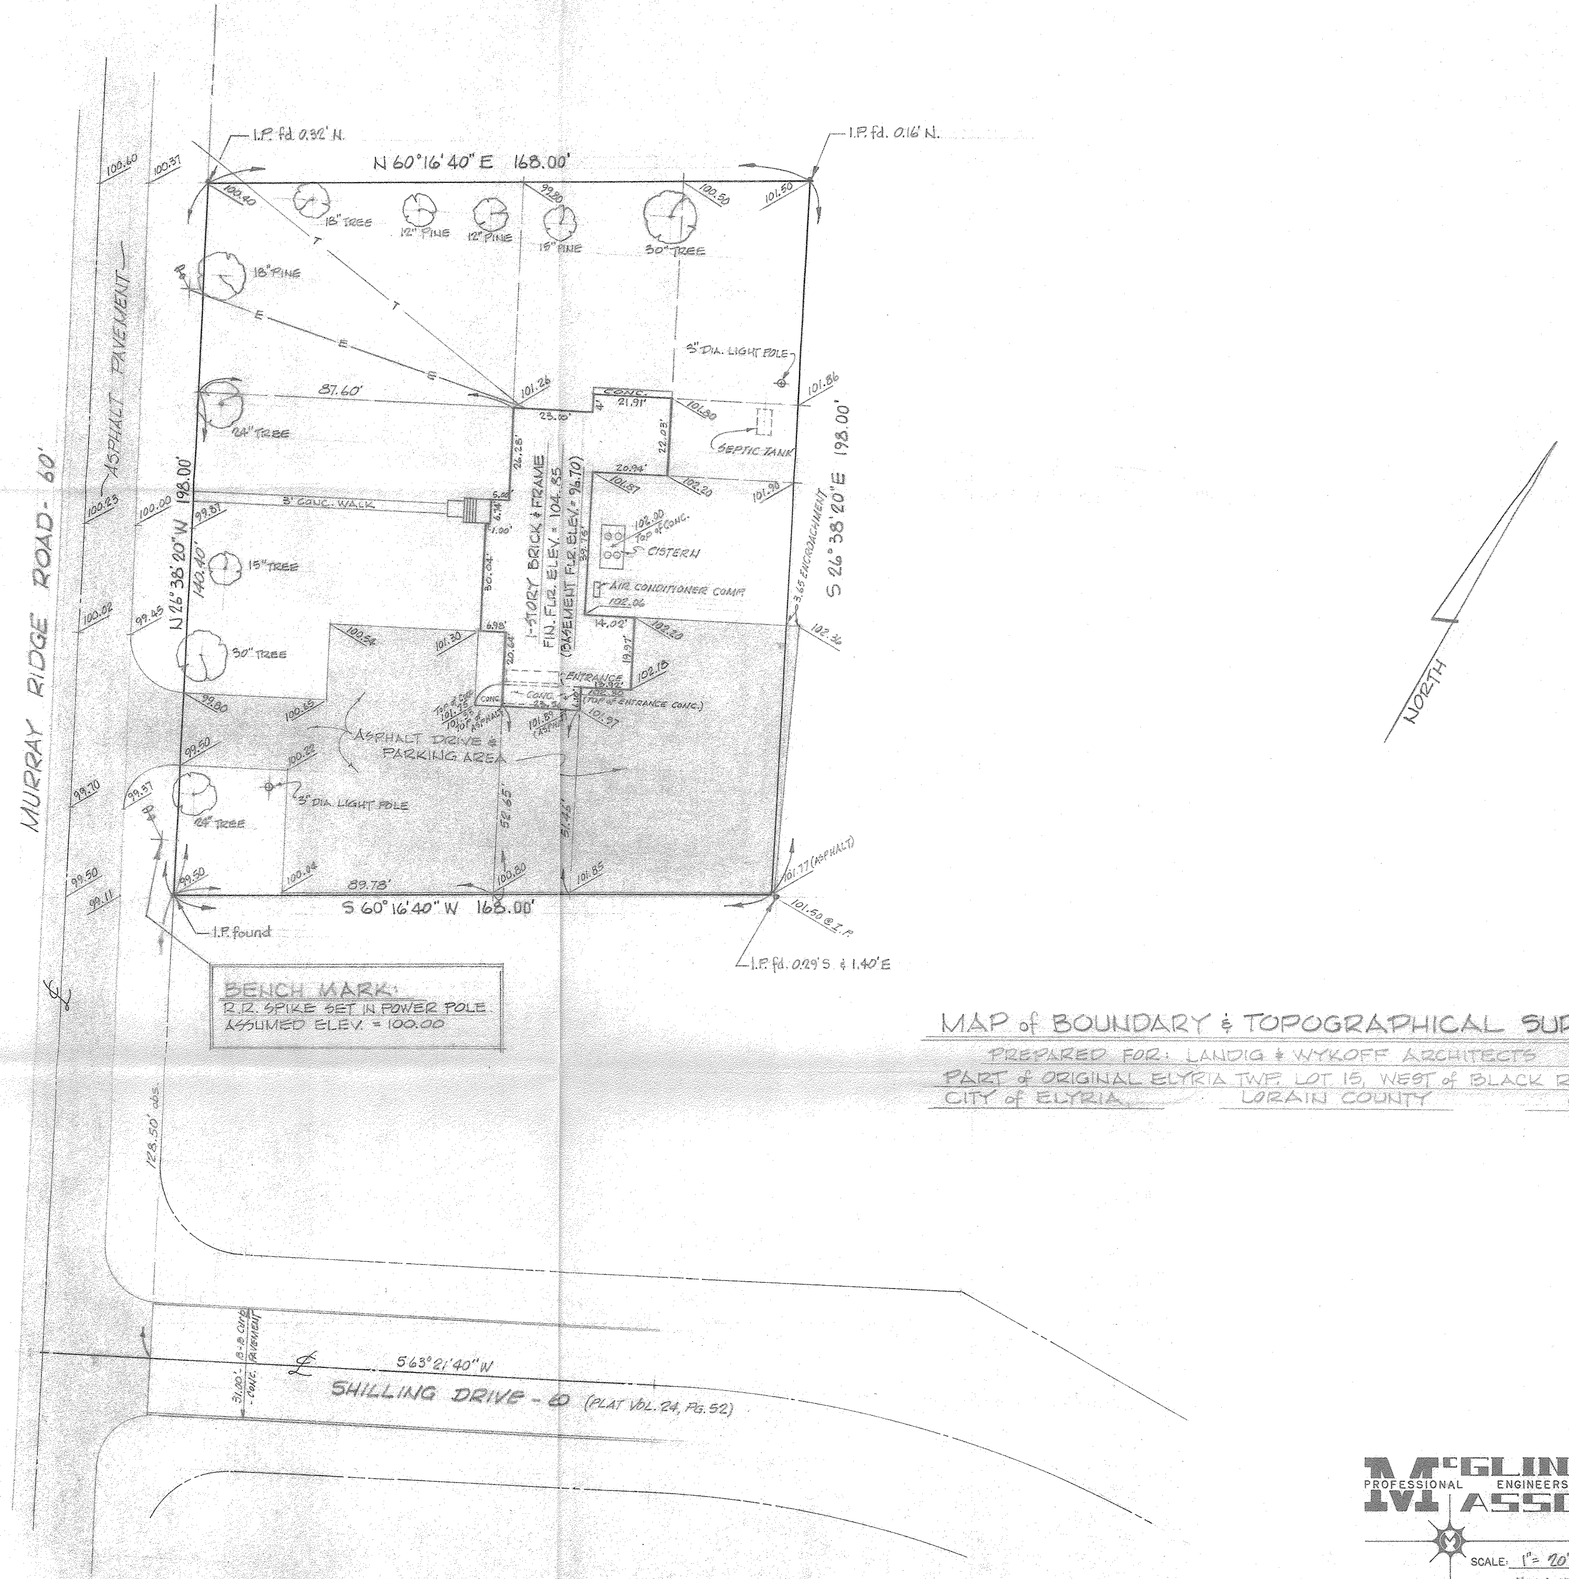

BENCH MARK:
R.R. SPIKE SET IN POWER POLE
ASSUMED ELEV. = 100.00

MAP of BOUNDARY & TOPOGRAPHICAL SURVEY

PREPARED FOR: LANDIG & WYKOFF ARCHITECTS
PART of ORIGINAL ELYRIA TWP. LOT 15, WEST of BLACK RIVER
CITY of ELYRIA LORAIN COUNTY OHIO

NO GAS SERVICE PER COLUMBIA GAS CO.

McGLINCHY AND ASSOCIATES
PROFESSIONAL ENGINEERS AND SURVEYORS
ELYRIA, OHIO

SCALE: 1" = 20' DRAWN BY: B. THOMAS
DATE: NOV. 1981 JOB NO: 817058