Scan # 5697 06-24-021-000-066
6-75

DETAIL SHEET OF PART OF ORIG. LOT NO. 21
WEST OF BLACK RIVER ELYRIA TOWNSHIP
LORAIN COUNTY OHIO
DETAIL SCALE: 1" = 30' JULY 14-1965 2:30 P.M.
Gary E. Penfound REG. SURVEYOR

Glen E. & Roberta V. Maiden

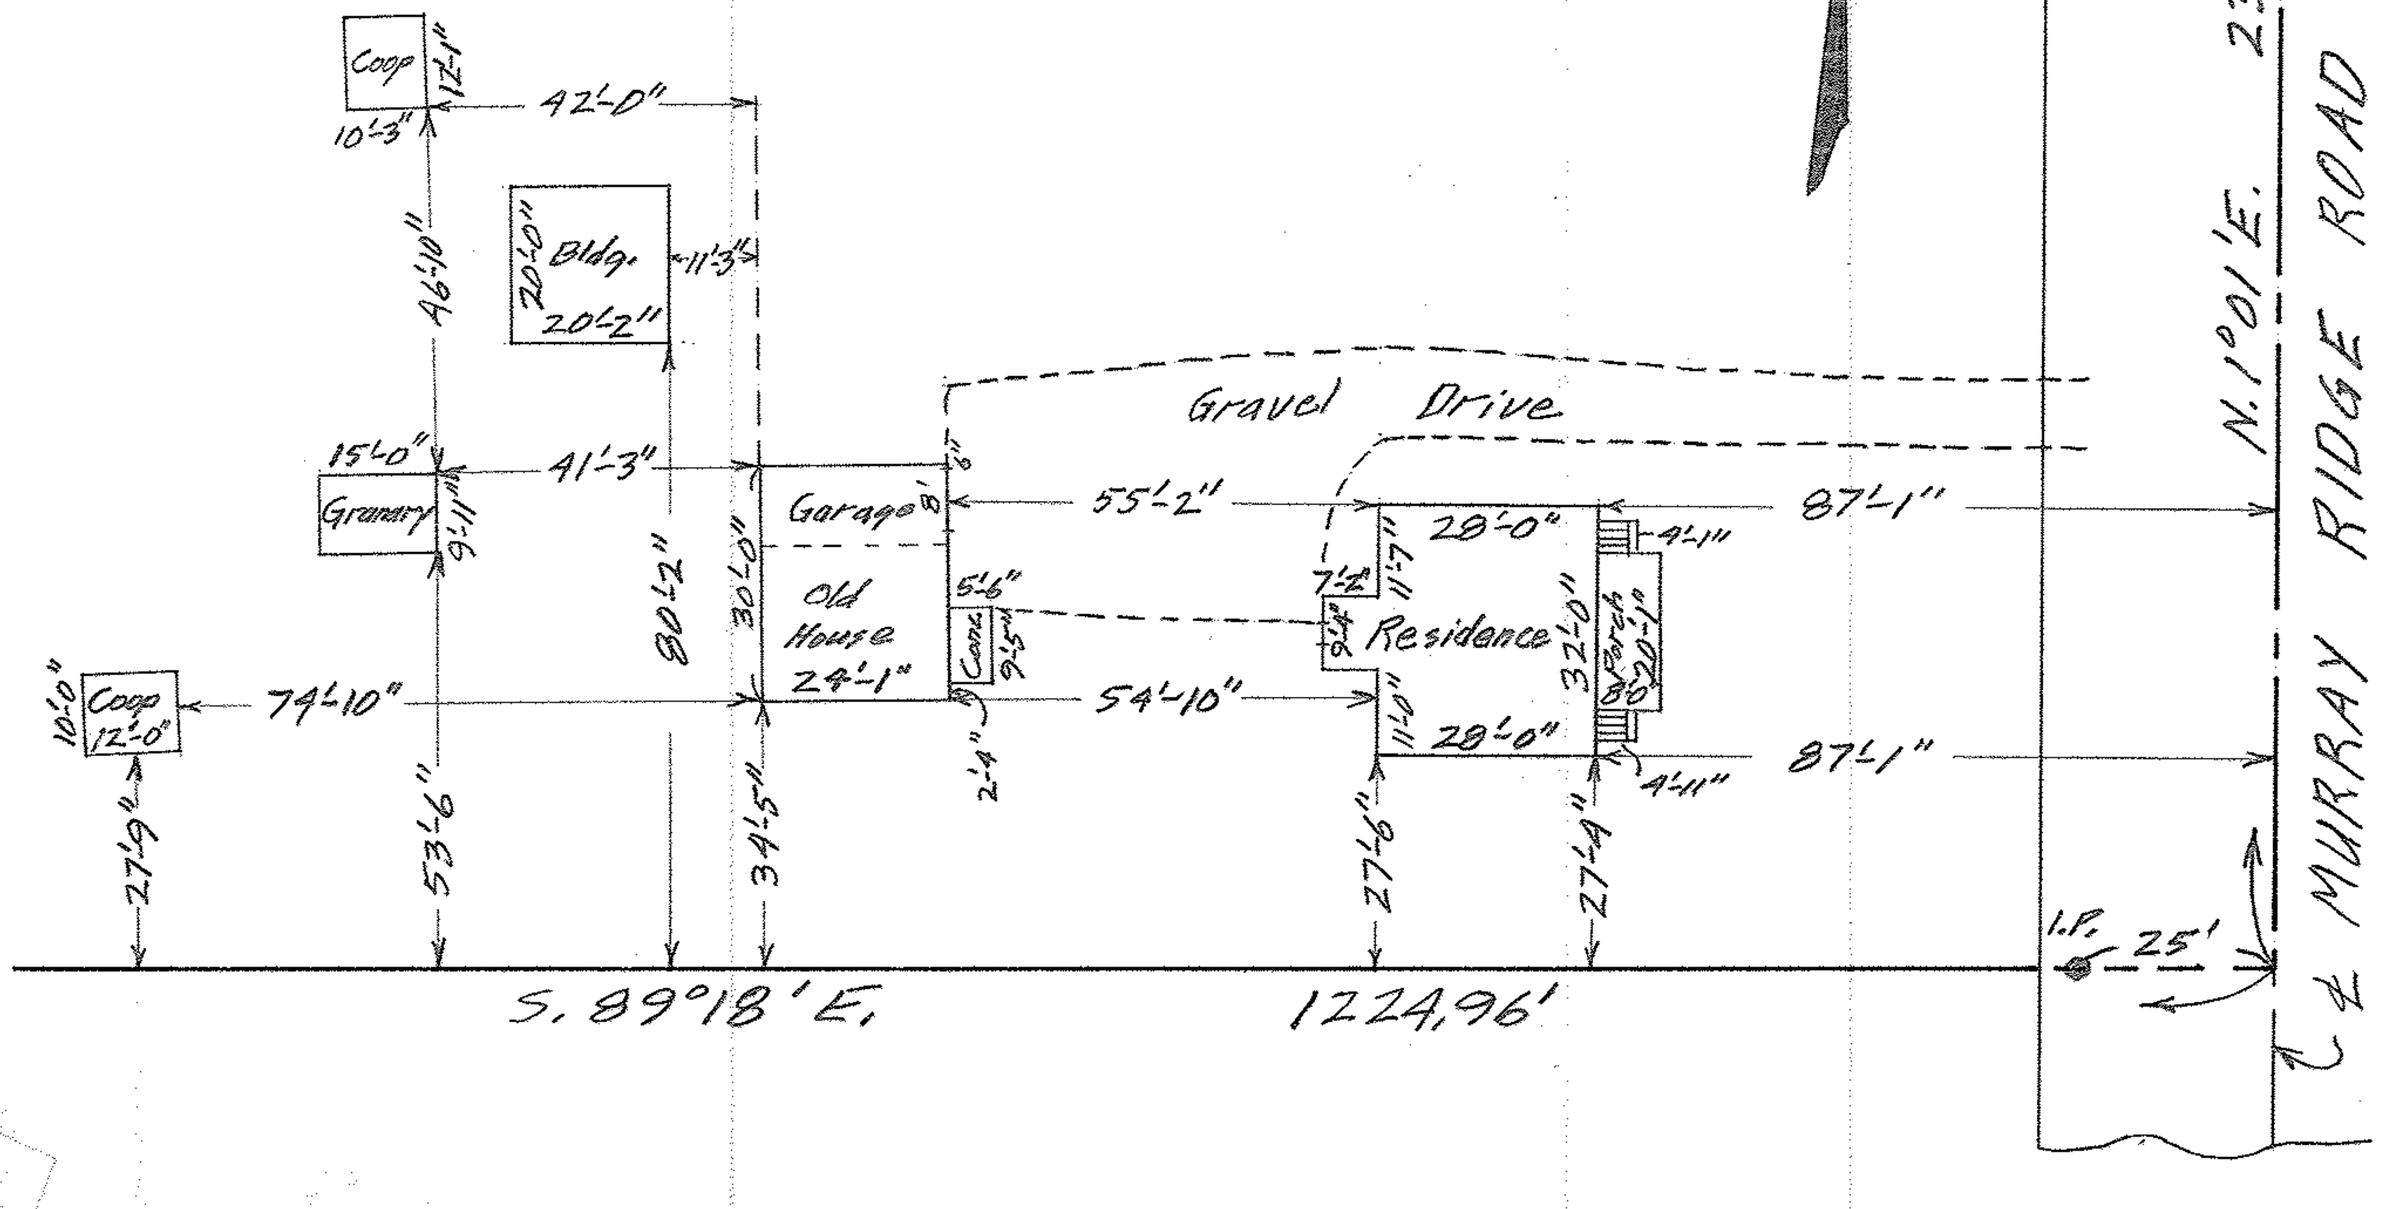

PC