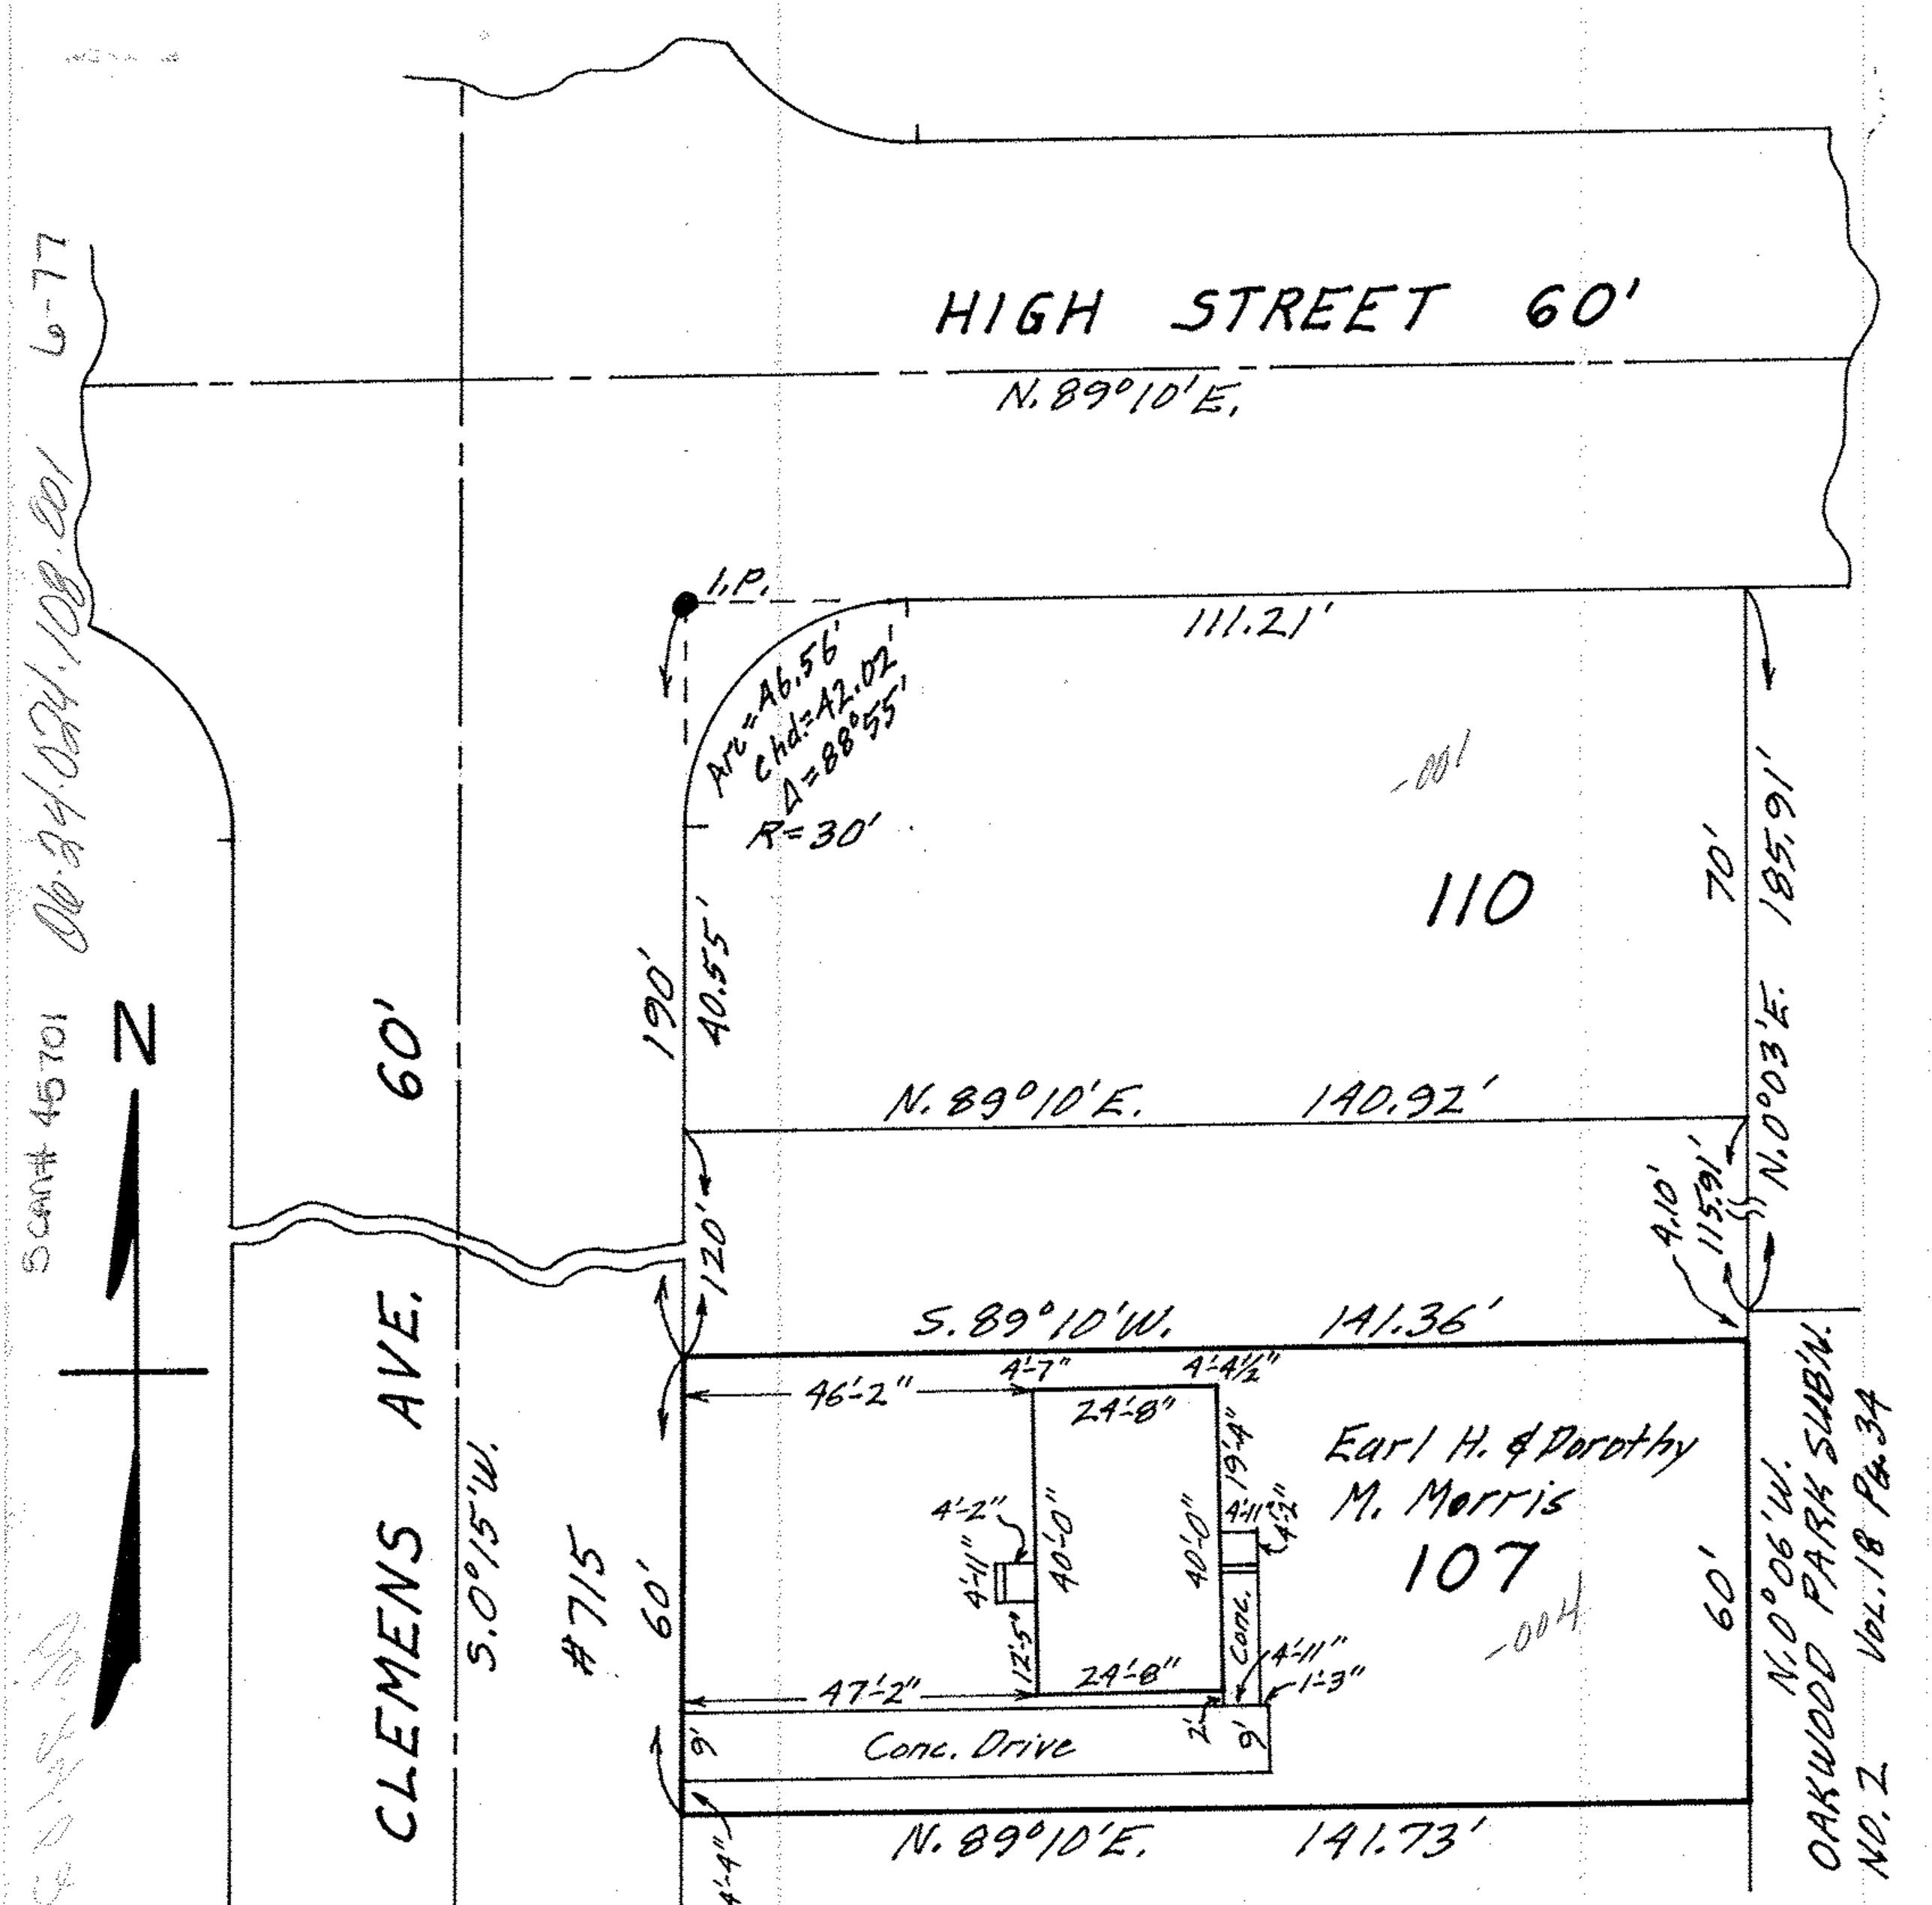

MAP OF SUB-LOT NO. 107
HIGHLAND ACRES SUB'N. NO. 2 (SEC. "A")
VOL. 23 PG. 10 PLAT RECORDS
ORIG. LOT 24 - WEST OF RIVER - ELYRIA TWP.
ELYRIA CITY - LORAIN COUNTY - OHIO
SCALE: 1"=30' SEPT. 1-1966 2:00 P.M.
Gary E. Penfound REG. SURVEYOR

BH