06-24-026-112-007

SCAN #4457

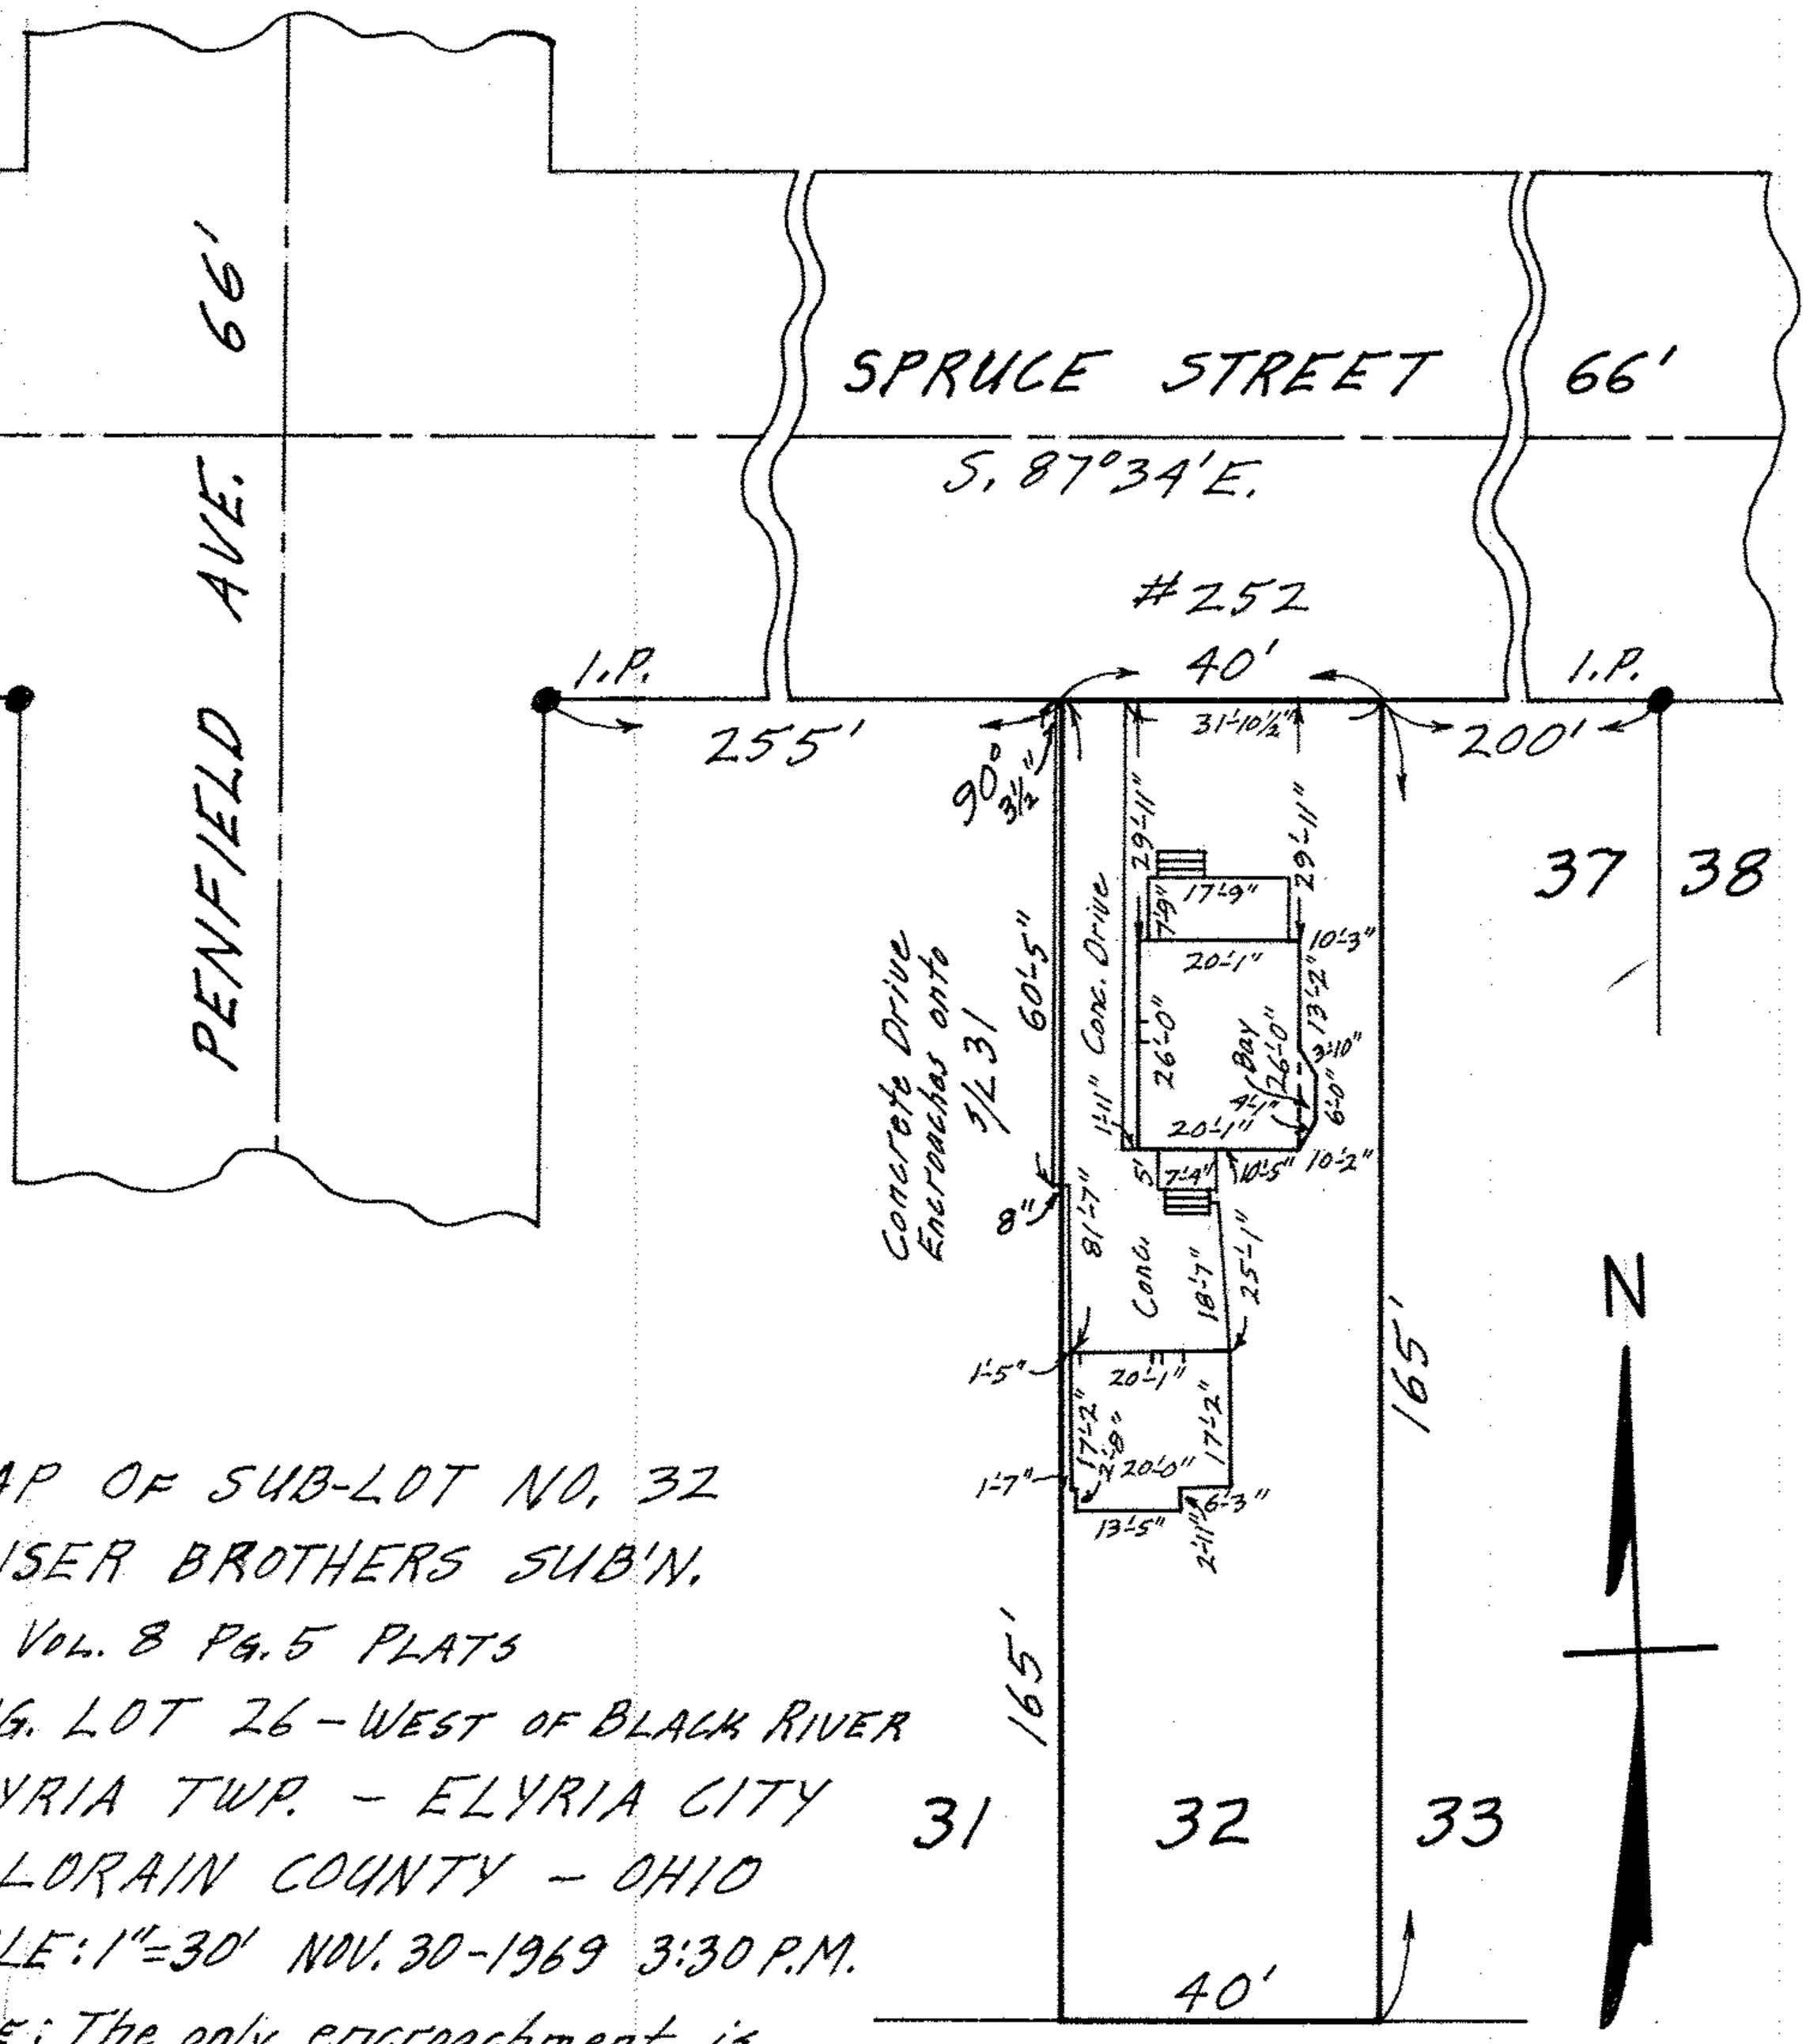

MAP OF SUB-LOT NO. 32
KAISER BROTHERS SUB'N.
VOL. 8 PG. 5 PLATS
ORIG. LOT 26 - WEST OF BLACK RIVER
ELYRIA TWP. - ELYRIA CITY
LORAIN COUNTY - OHIO
SCALE: 1"=30' NOV. 30-1969 3:30 P.M.
NOTE: The only encroachment is
that of Concrete Drive onto Sub-Lot No. 31
Gary E. Penfound REG. SURVEYOR NO. 4457

CITY TITLE Co. Order No. E-970-1
Papp to Redinger