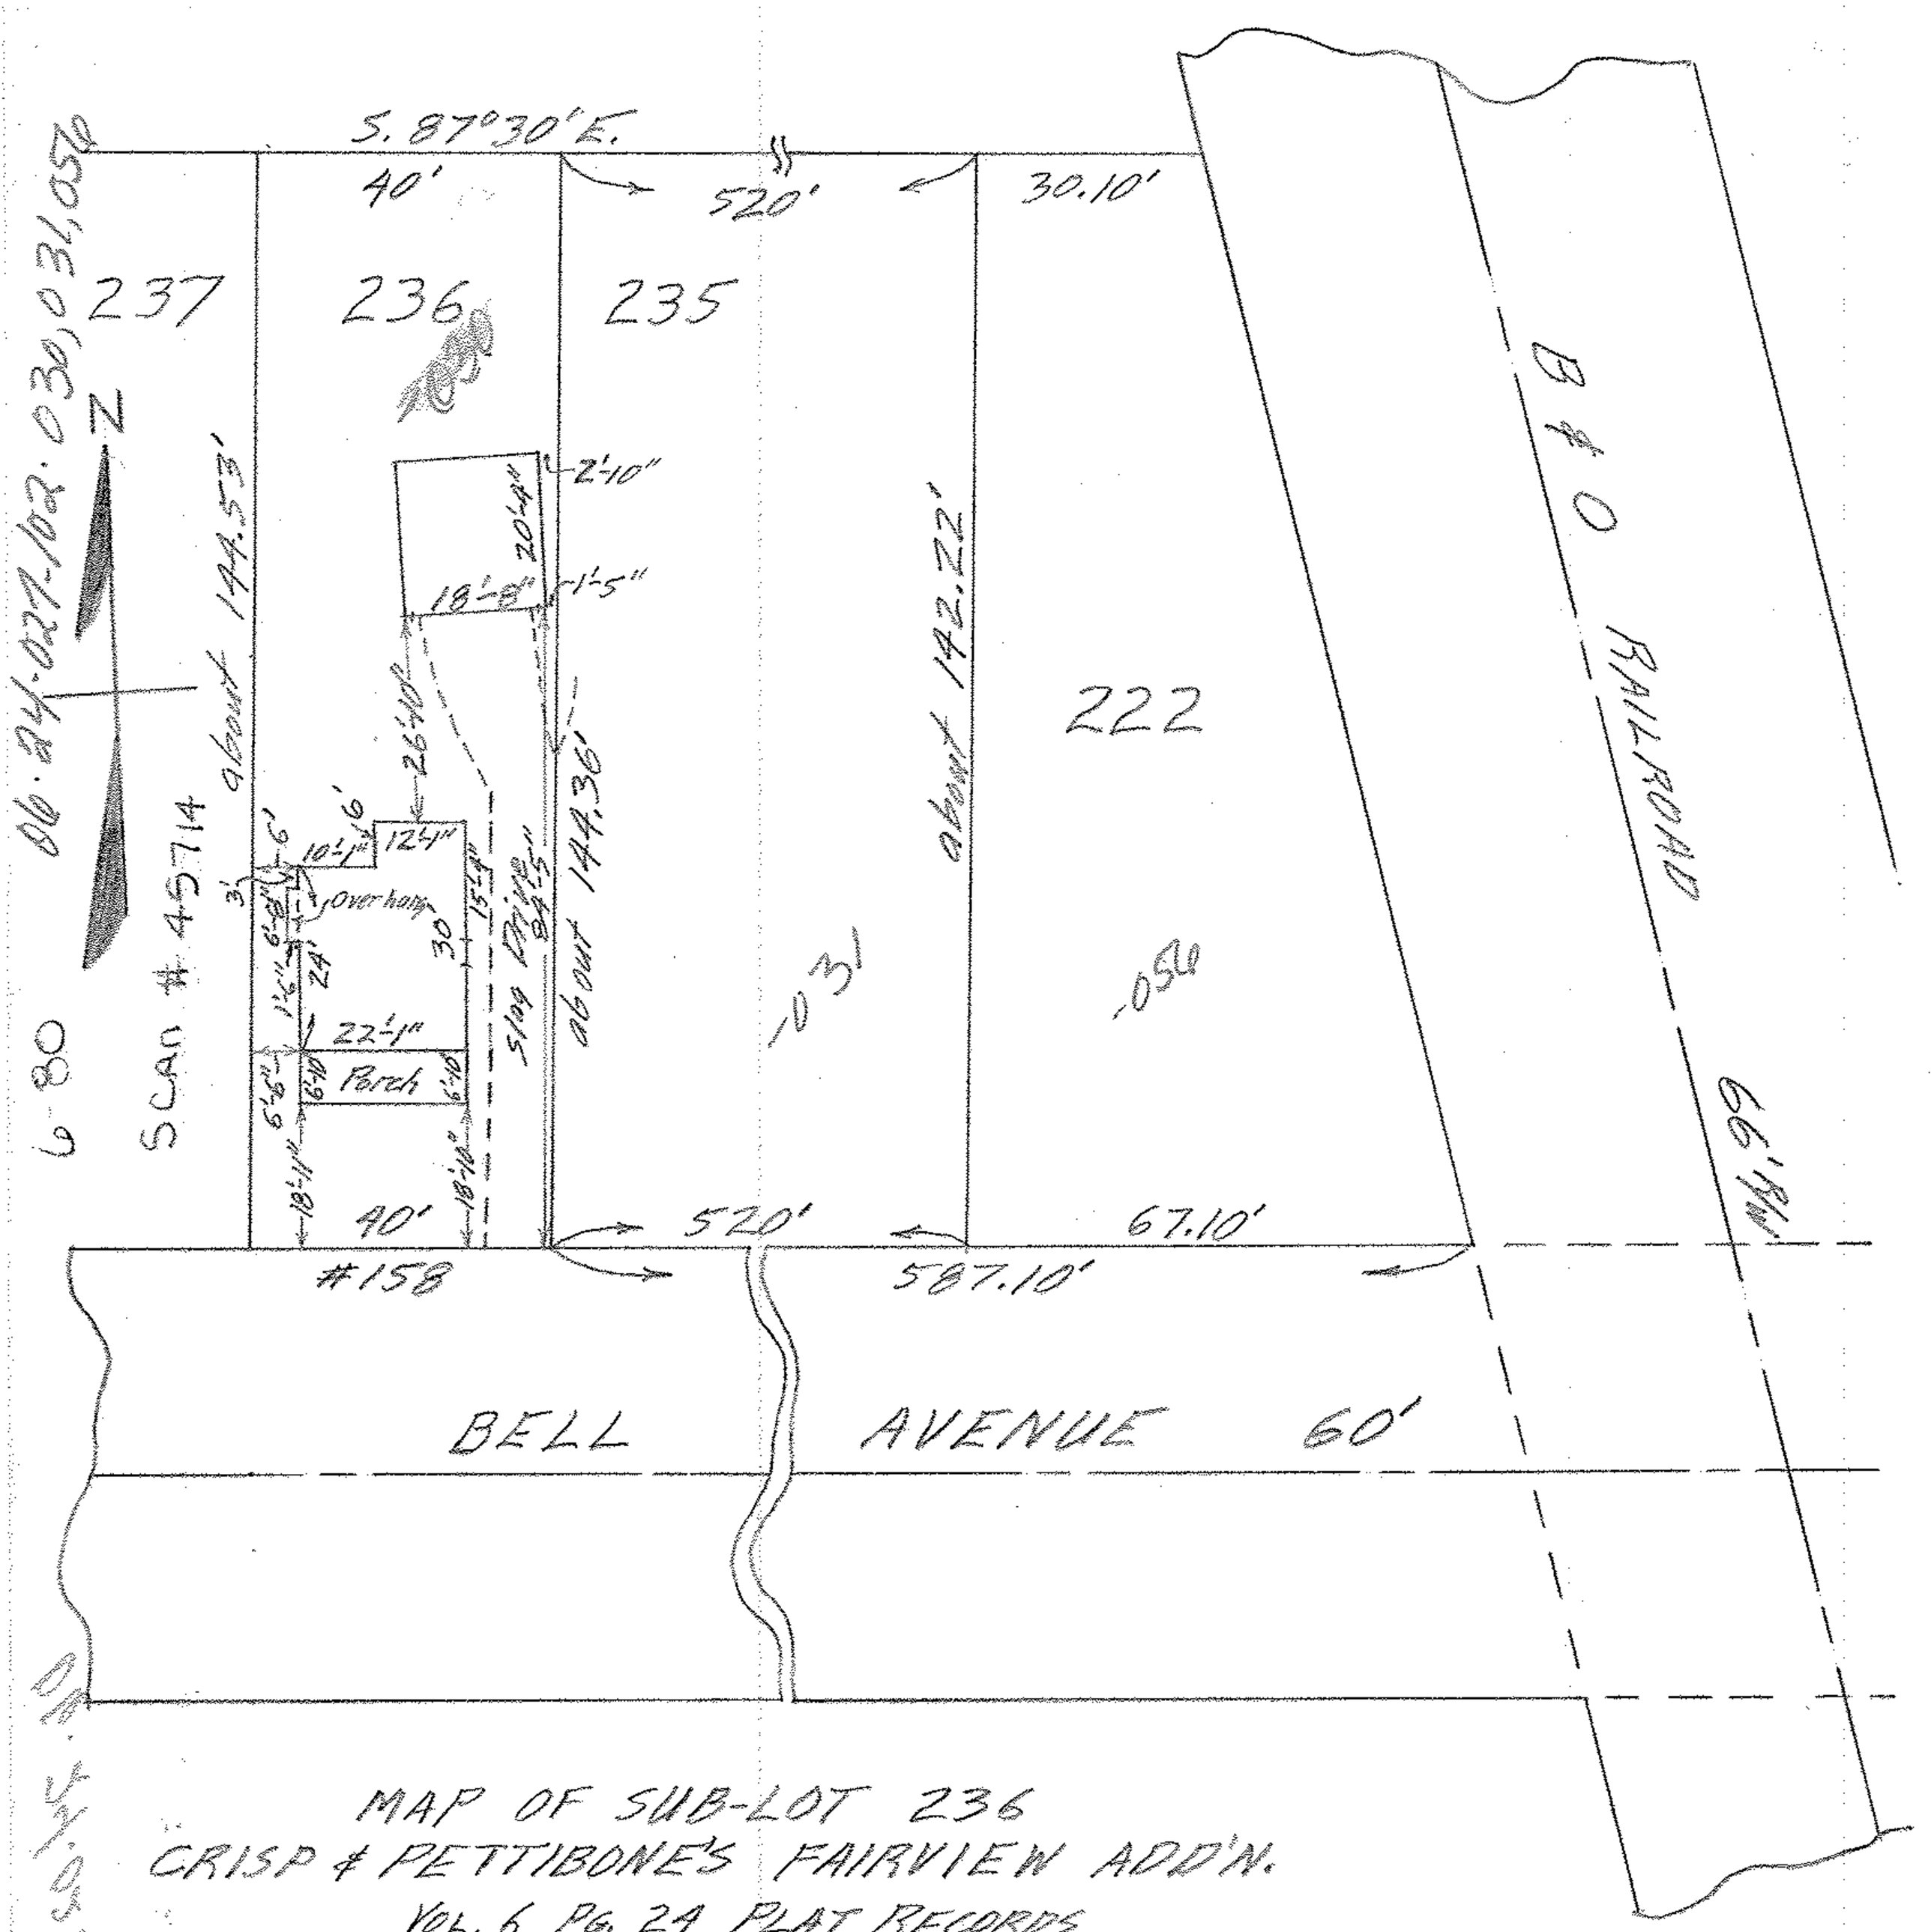


MAP OF SUB-LOT 236
CRISP & PETTIBONE'S FAIRVIEW ADD'N.
VOL. 6 PG. 24 PLAT RECORDS
ELYRIA CITY — LORAIN COUNTY — OHIO
SCALE: 1"=30' AUGUST 19-1960 2:00 P.M.
Gary E. Penfound REG. SURVEYOR WW

Made for and at the instance of The Security Federal Savings & Loan Association and Lawyers Title Insurance Corp. — A.H. West, APPROVED ATTY.

P.O. Edward N. & Lillian J. Malterer