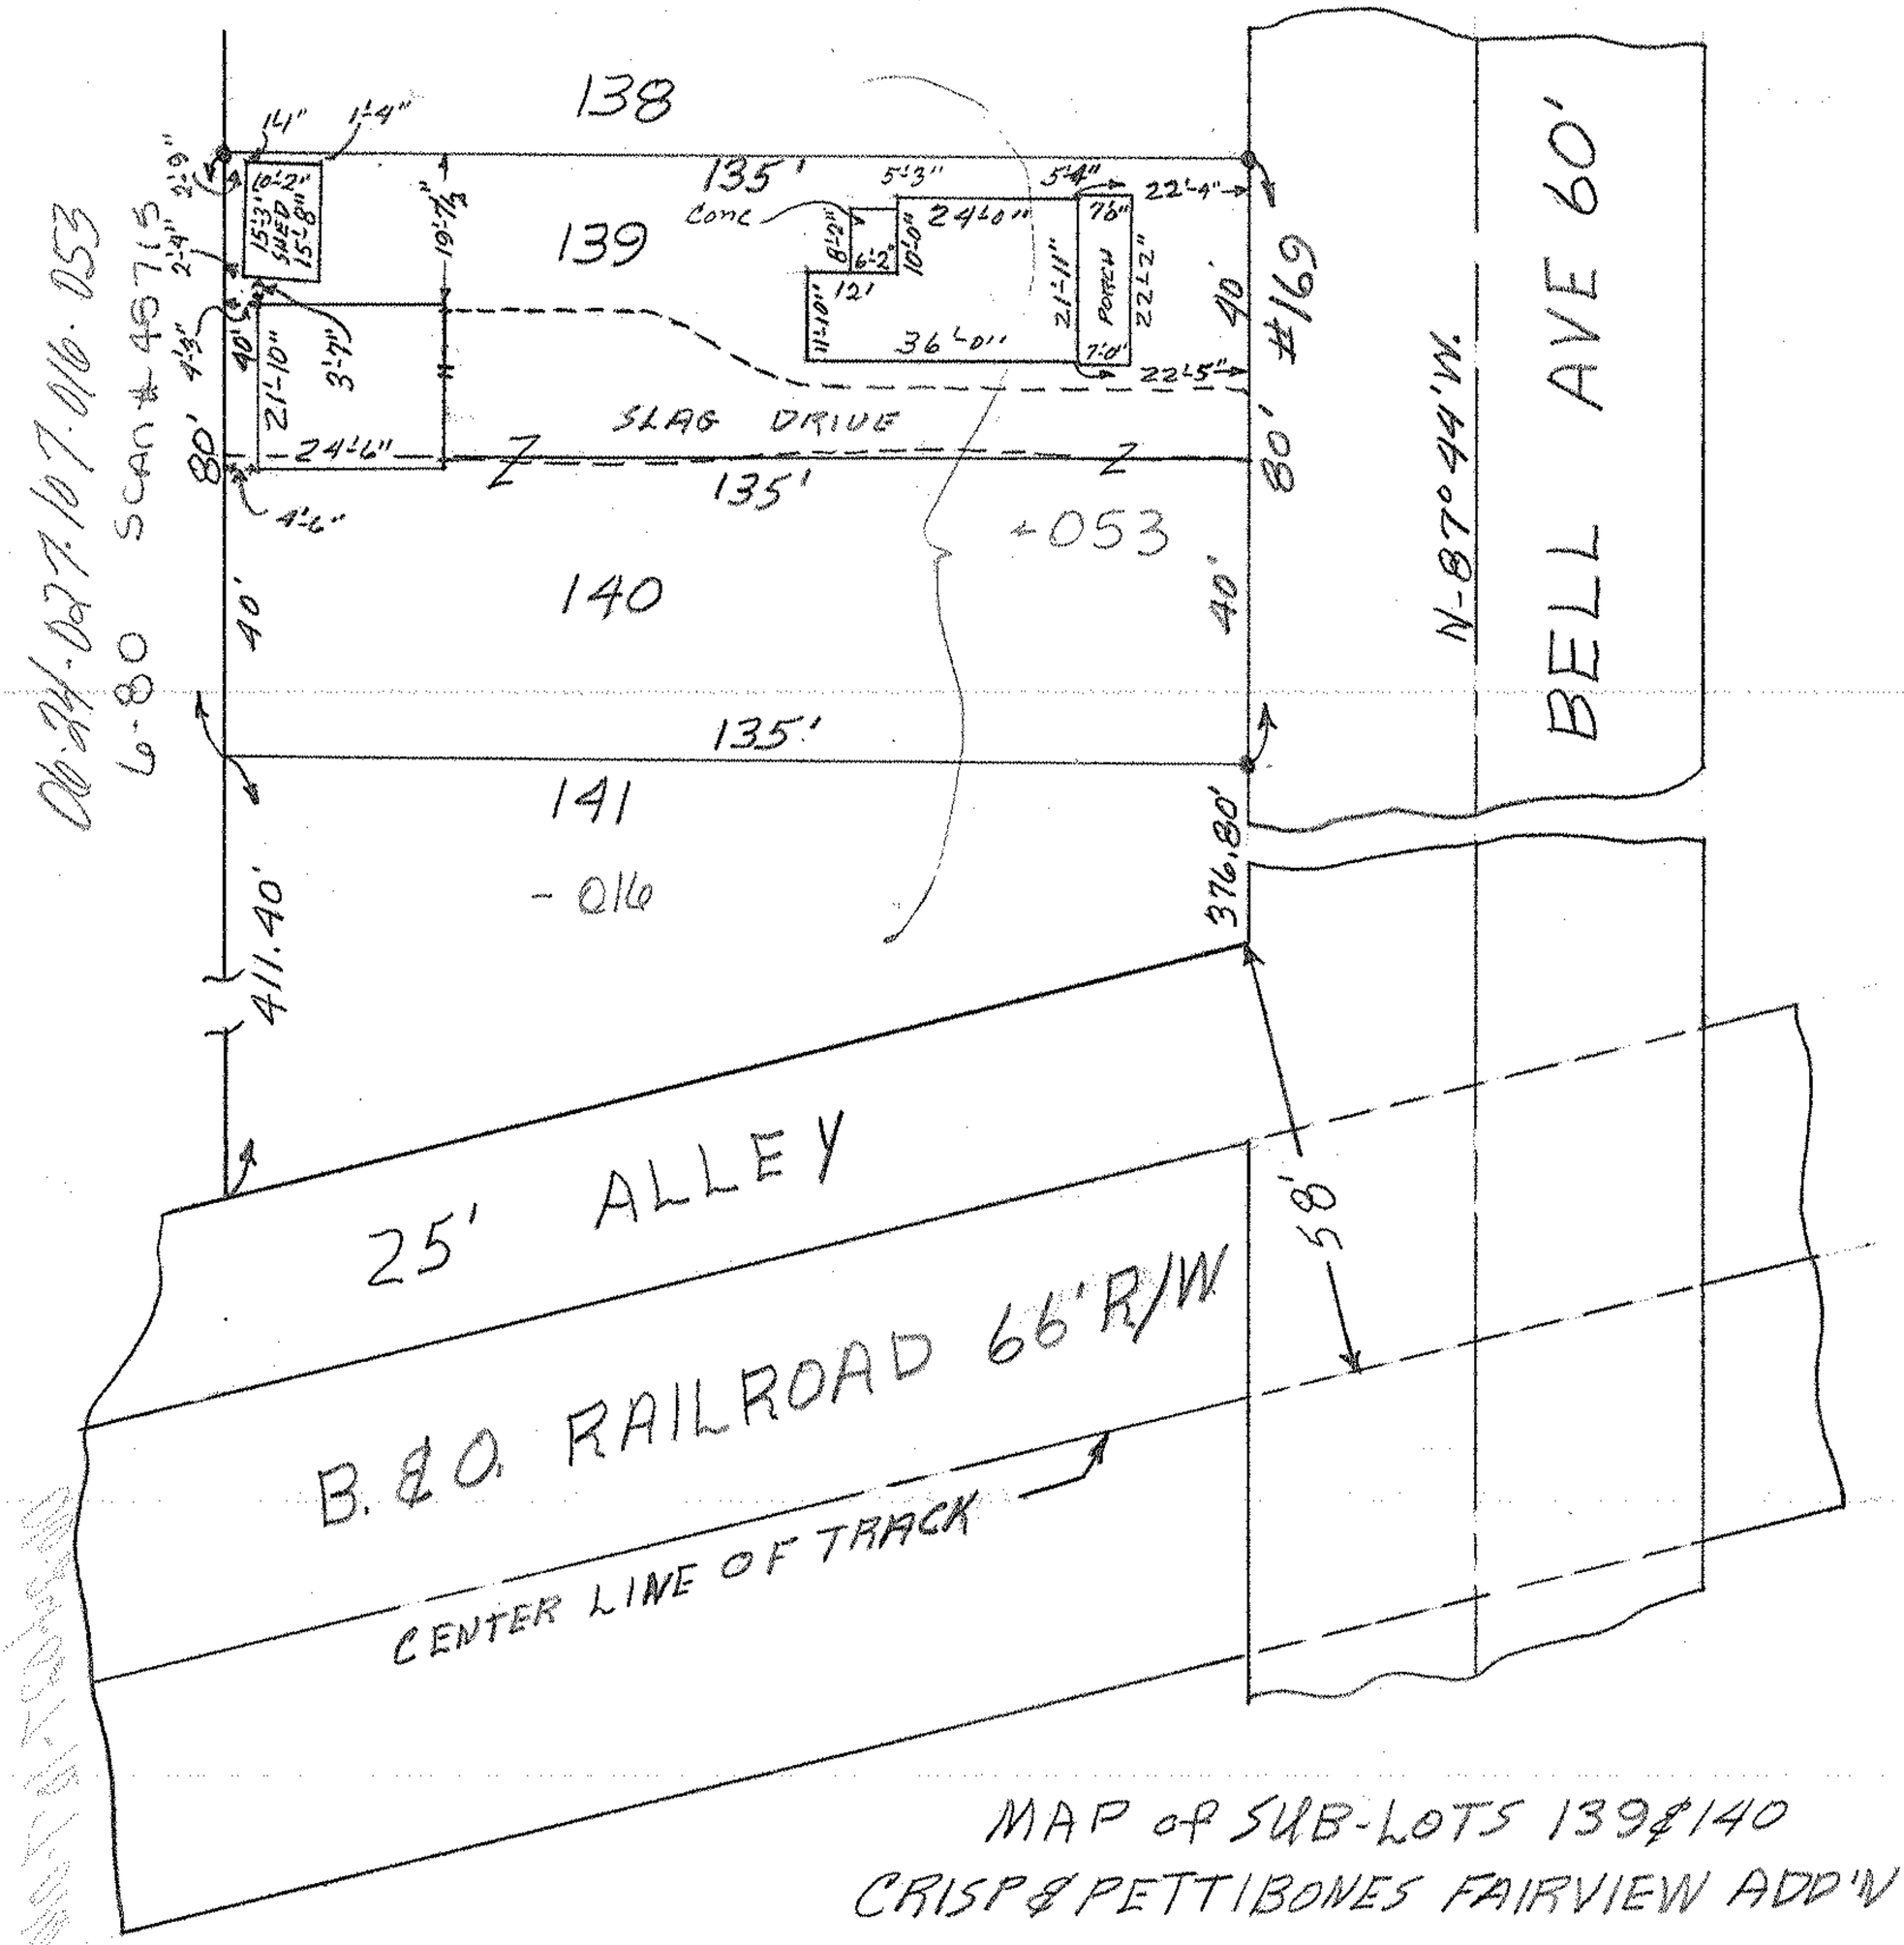

MAP of SUB-LOTS 139 & 140
CRISP & PETTIBONES FAIRVIEW ADD'N
VOL. 6 Pg. 24 PLAT RECORDS
ELYRIA TWP. ELYRIA-CITY
LORAIN COUNTY-OHIO

Scale: 1"=30' Dec. 20, 1962 9:30 A.M.

Clarence I. & Ann E. Board WW

Gary E. Penfound Registered Surveyor