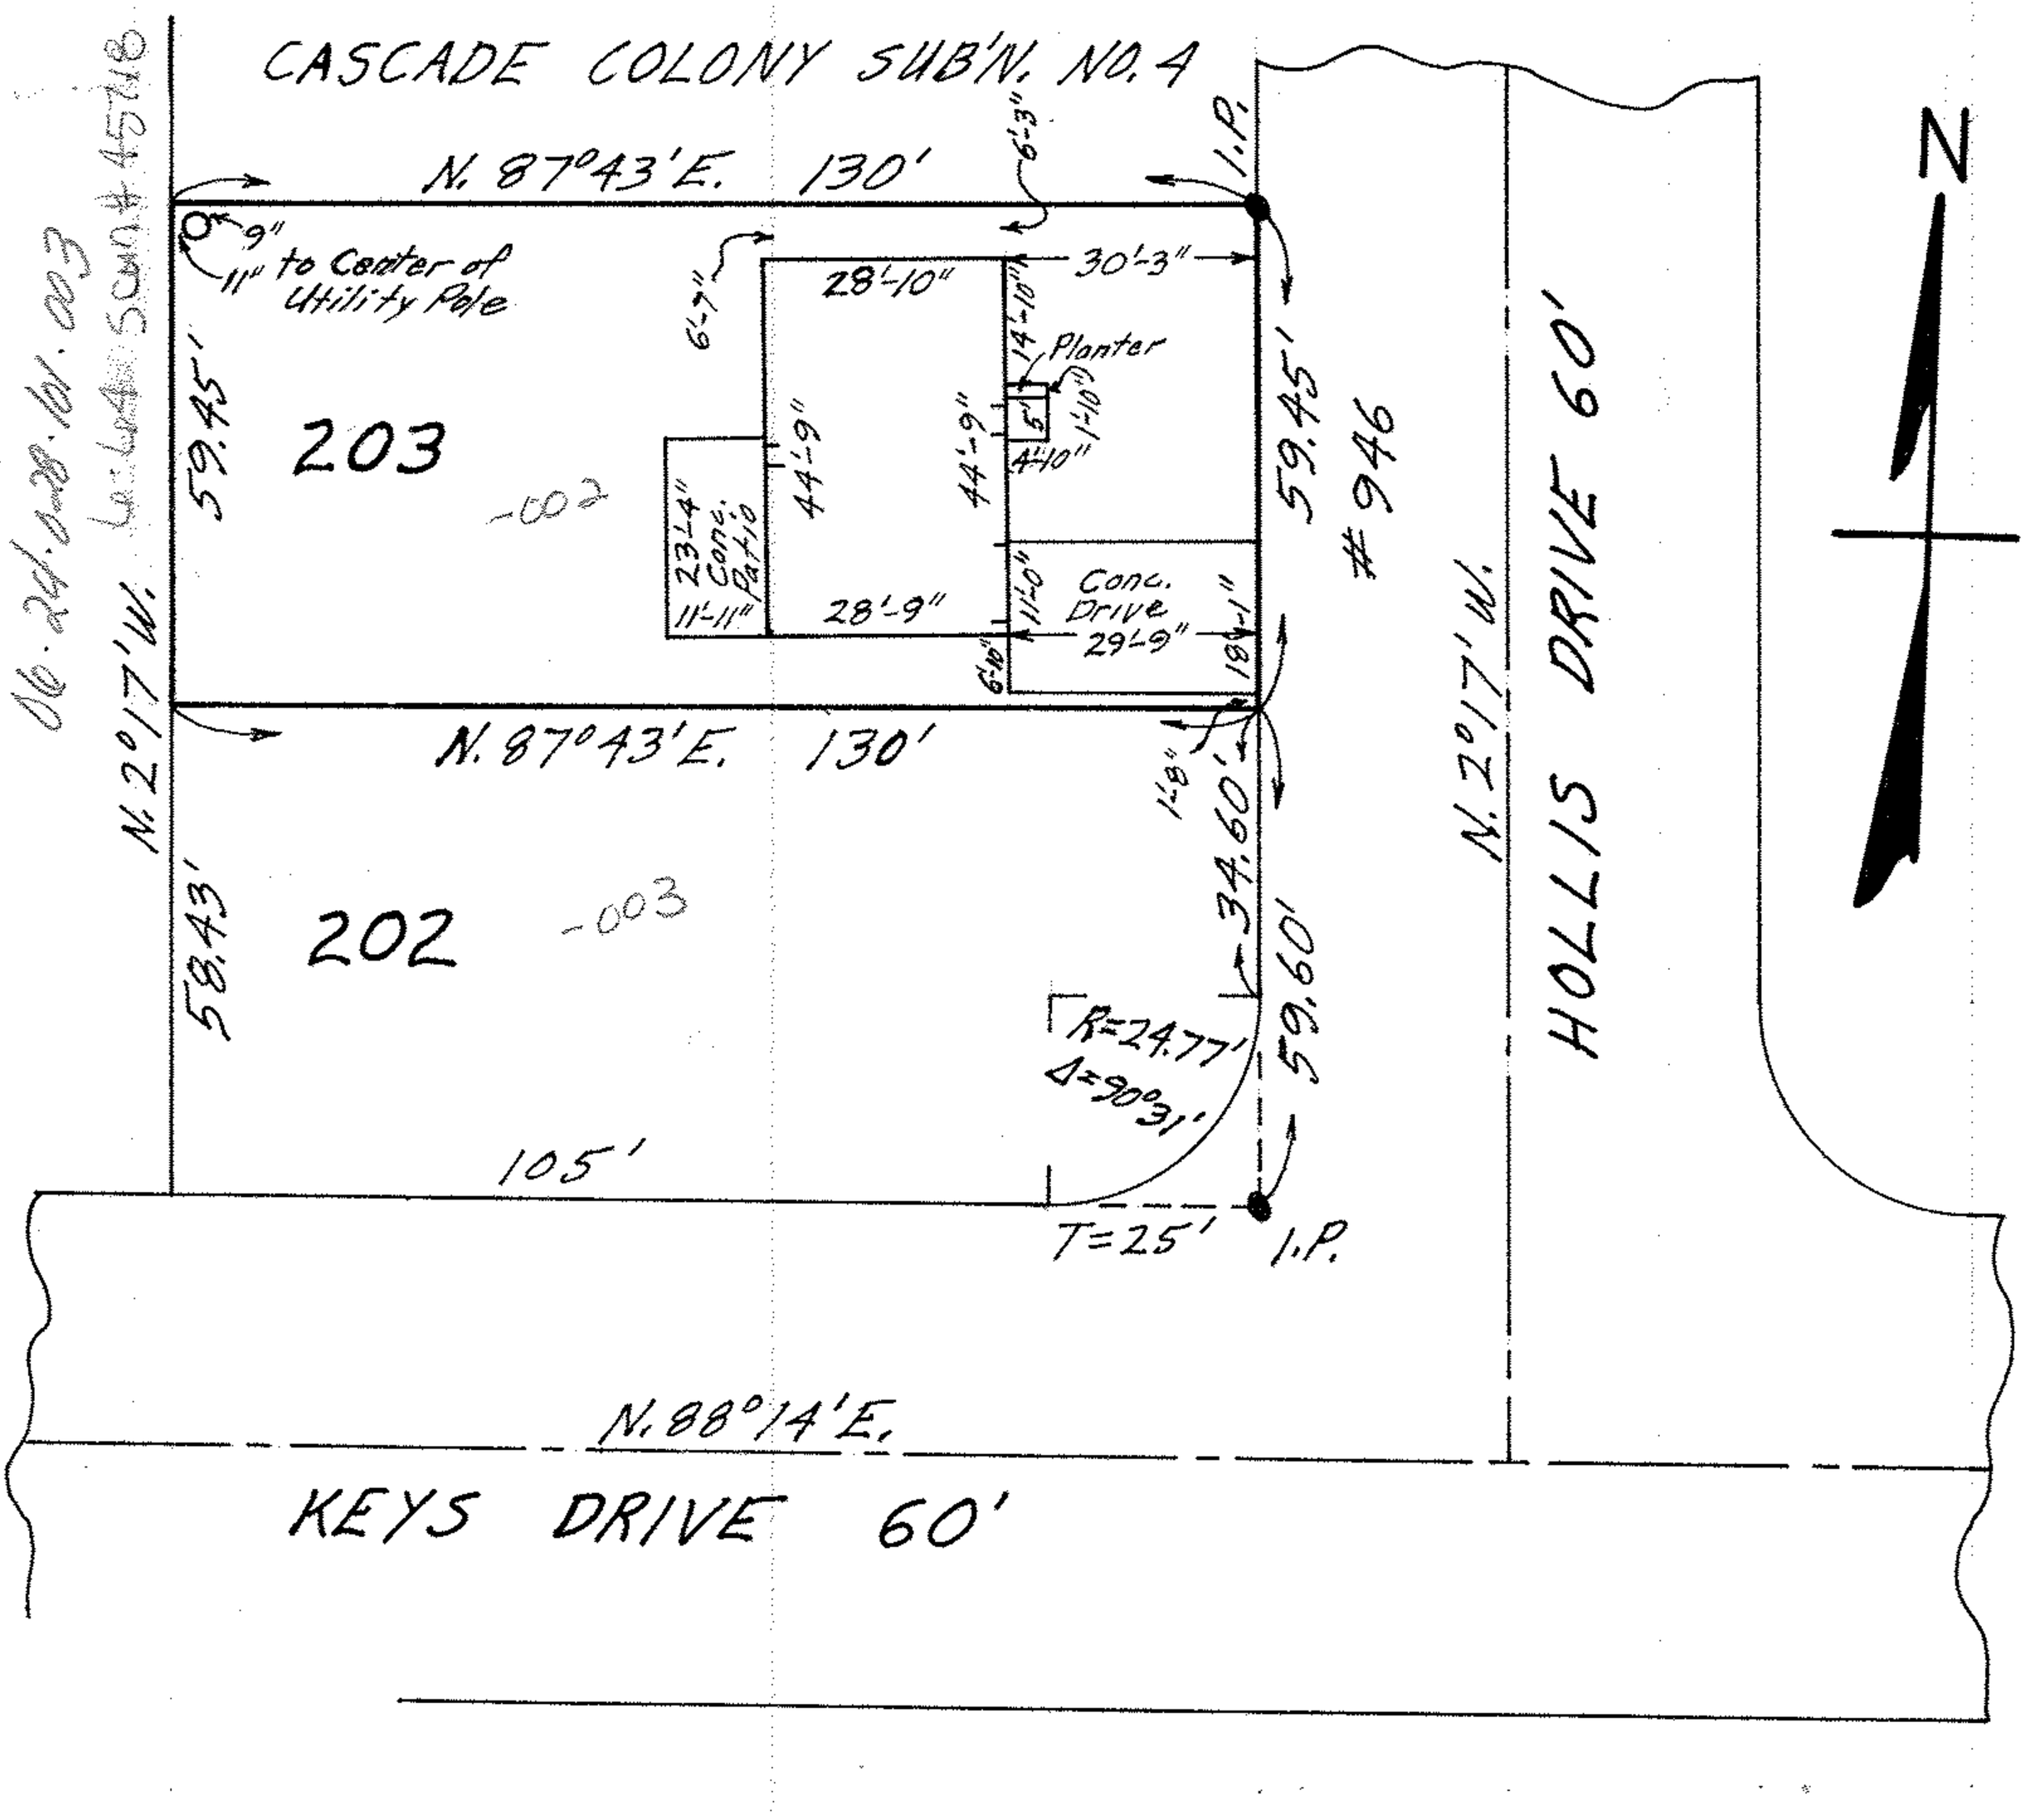

MAP OF SUB-LOT NO. 203

CASCADE COLONY SUB'N. NO. 3 VOL. 21 PG. 39

ORIG. LOT 29 - WEST OF BLACK RIVER - ELYRIA TWP.

ELYRIA CITY - LORAIN COUNTY - OHIO

SCALE: 1"=30' DEC. 16-1969 5:10 P.M.

NOTE: There are no encroachments on this property.

Gary E. Penfound REG. SURVEYOR NO. 4457

CITY TITLE Co. Order No. E-984-5

Robert Frommeyer to Samuel S. & Jacqueline M. Cannarella