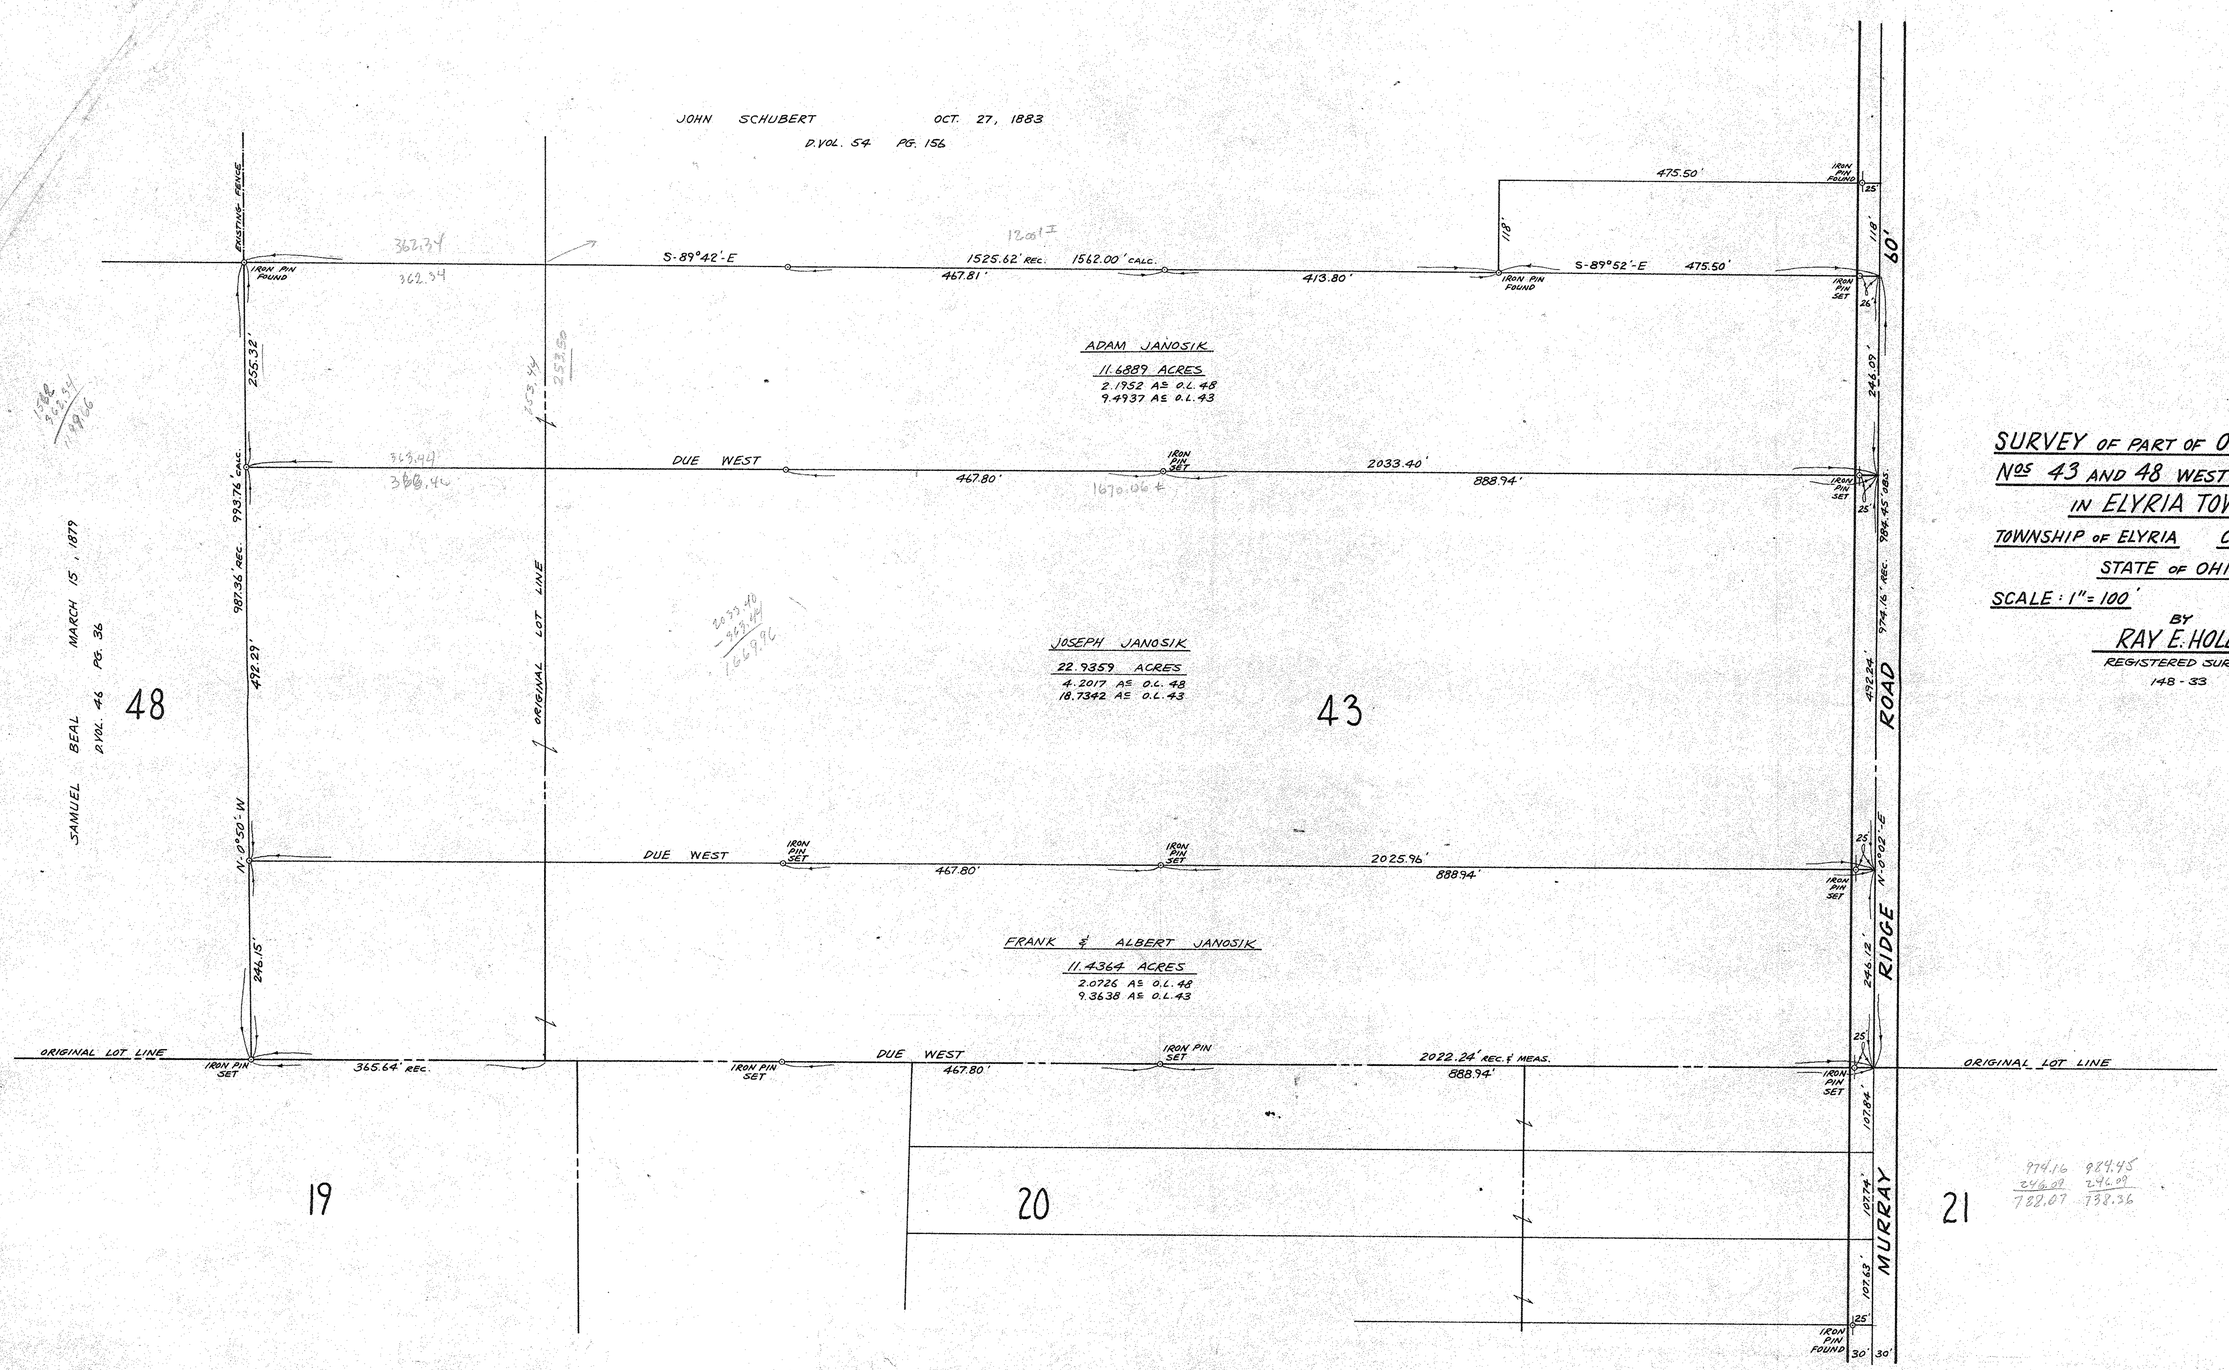

SURVEY OF PART OF ORIGINAL LOTS Nos 43 AND 48 WEST OF BLACK RIVER IN ELYRIA TOWNSHIP

TOWNSHIP OF ELYRIA COUNTY OF LORAIN

STATE OF OHIO

SCALE: 1" = 100' AUGUST 1969

BY

RAY E. HOLLIS

REGISTERED SURVEYOR

148 - 33

09-24-048-000-006.000 047-019

C 6-WOF R-43,48