06-24-049-102-013 6-82

CITY TITLE Co. Order No. E-1019-20
Sidney K. & Agnes M. Sheldon
to Lemuel B. & Betty J. Reed

MAP OF THE EASTERLY 53 FEET OF SUB-LOTS 371, 372 & 373 IN S. MENDELSON'S SUB'N. VOL. 7 PG. 23 ORIG. LOT 49 - WEST OF RIVER ELYRIA TWP. - ELYRIA CITY LORAIN COUNTY OHIO

SCALE: 1" = 30'

FEB. 1 - 1970 2:30 P.M.

NOTE: There are no encroachments on this property.
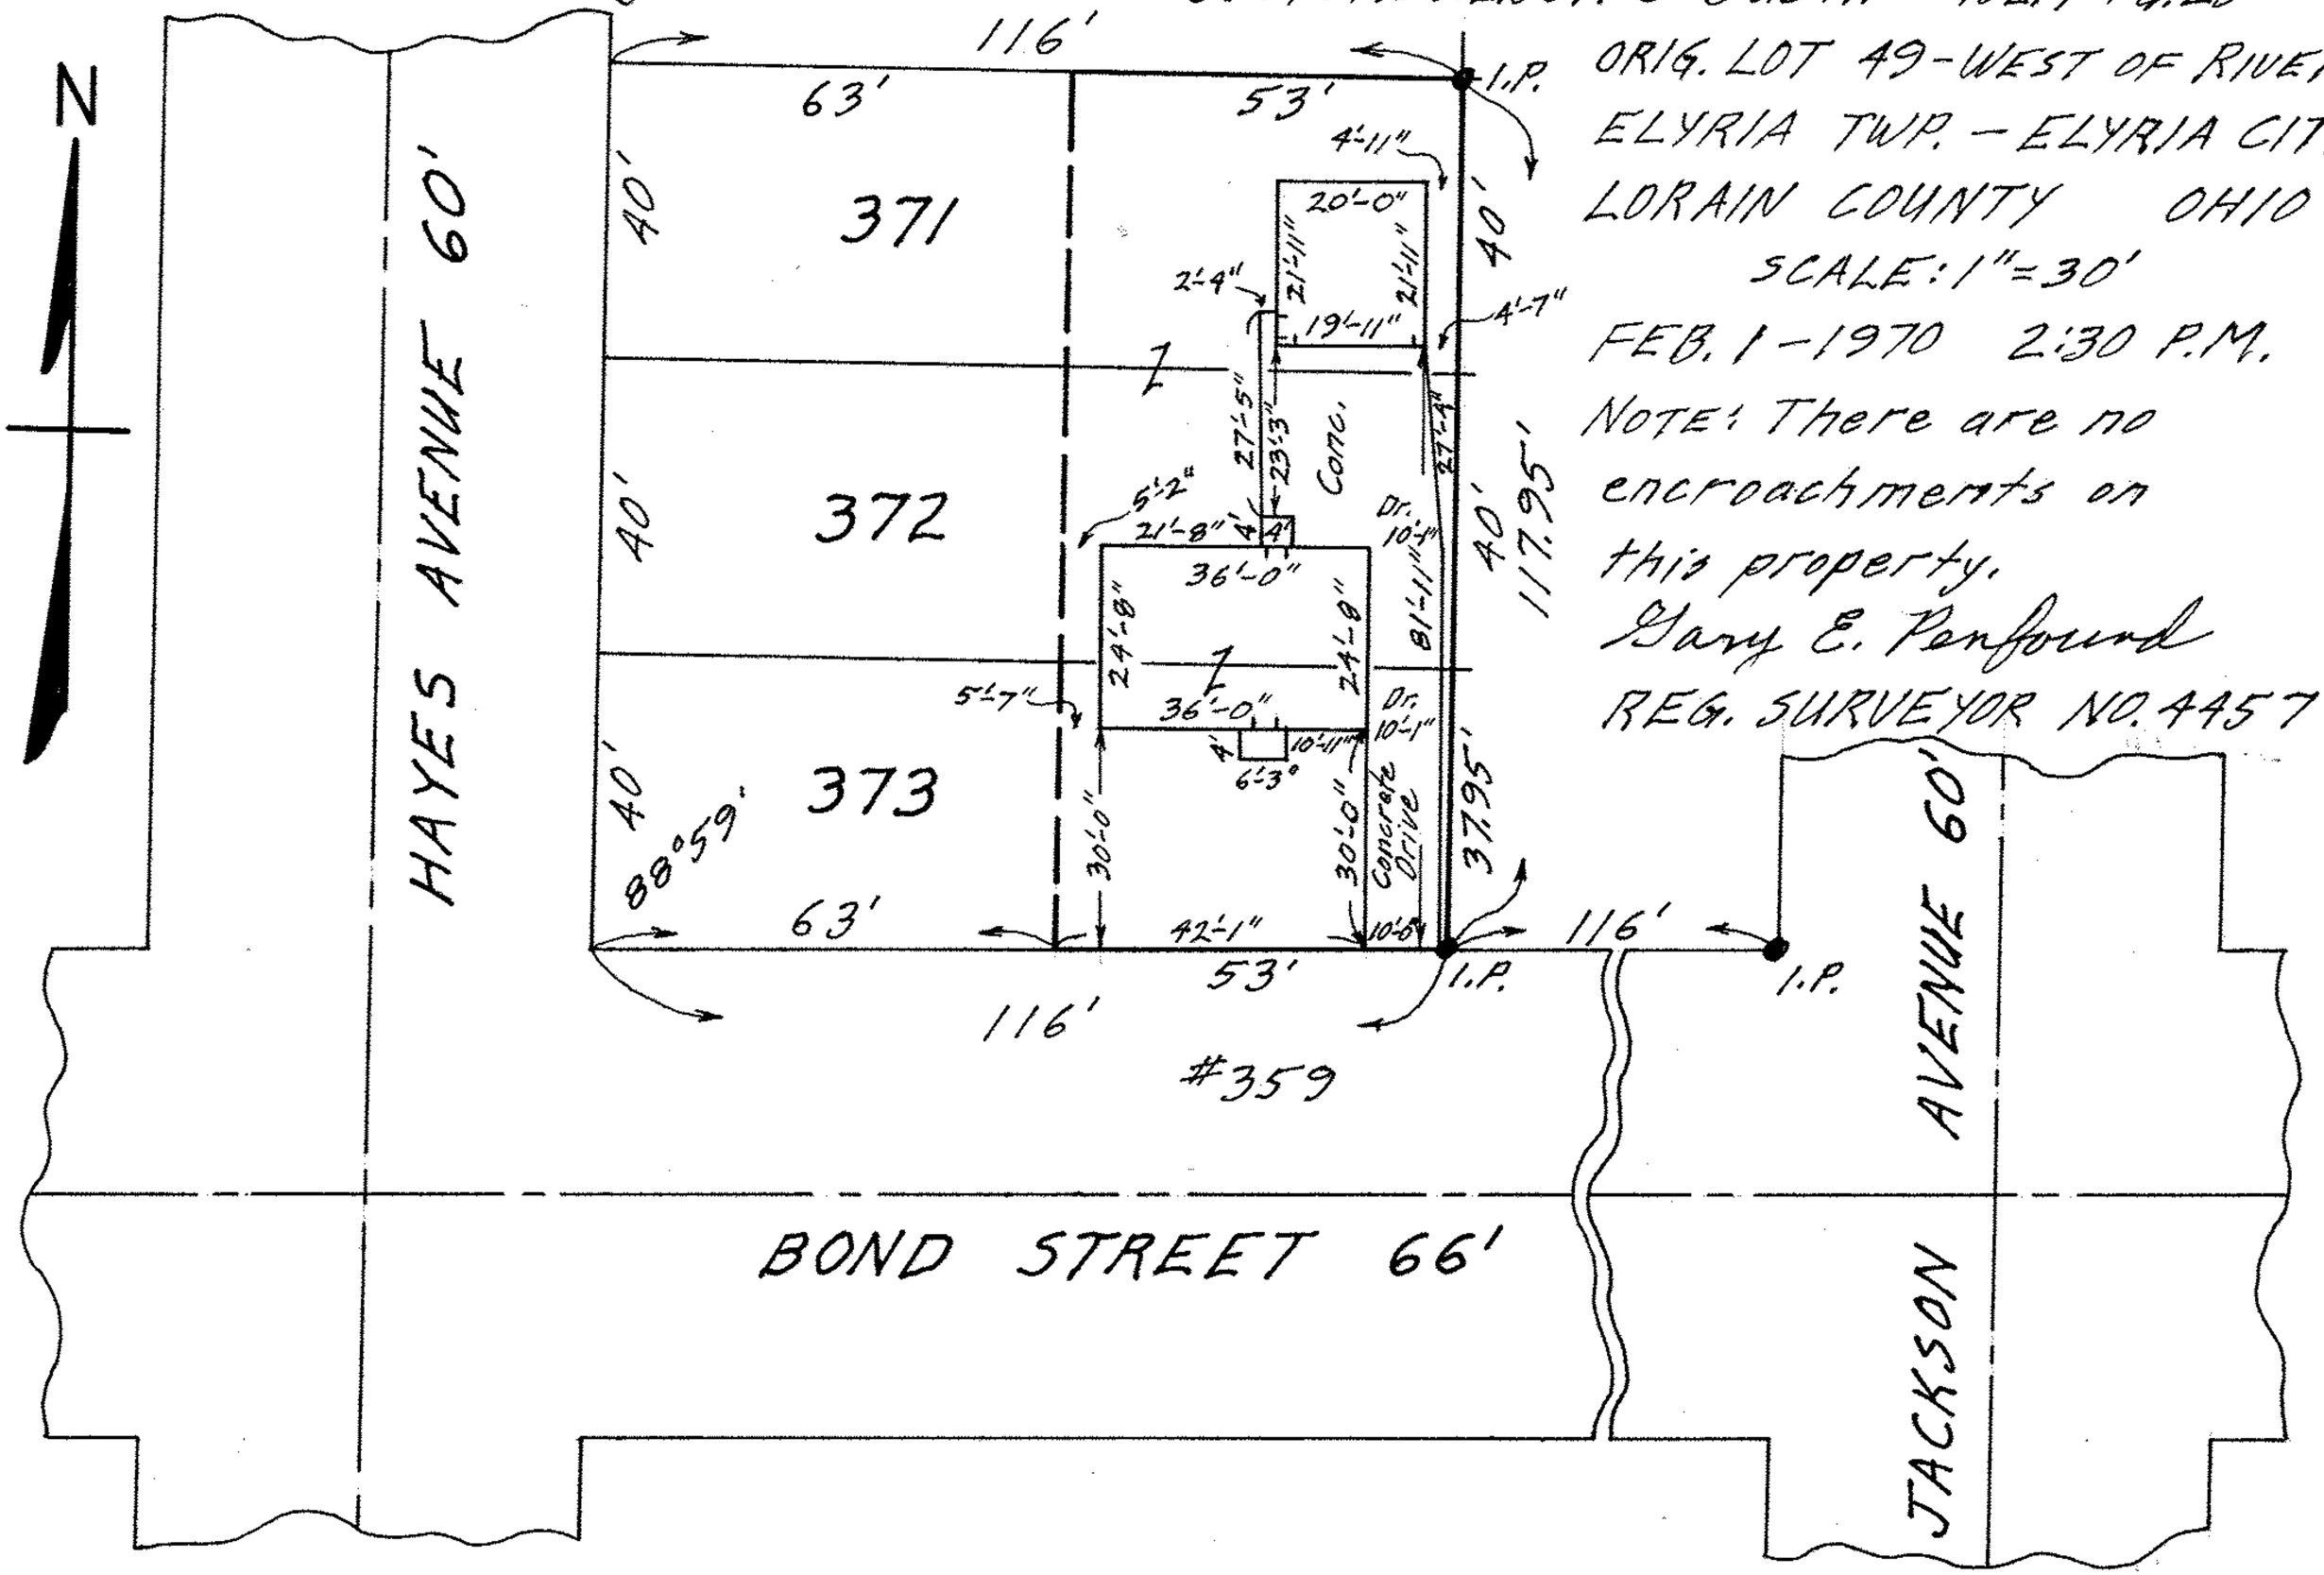
Gary E. Penfound
REG. SURVEYOR NO. 4457